


GENERAL NOTES:

1. THE GENERAL NOTES REFER TO ALL ARCHITECTURAL DRAWINGS.
2. DO NOT SCALE DRAWINGS.
3. SITE CHECK ALL DIMENSIONS PRIOR TO CONSTRUCTION.
4. NOTHING ON THESE DRAWINGS SUPERSEDES THE REGULATIONS OF THE GOVERNING CODES INCLUDING THE ONTARIO BUILDING CODE.
5. NOTIFY ARCHITECT OF ALL CONFLICTS AND DISCREPANCIES PRIOR TO CONSTRUCTION.
6. CONTRACTOR TO COORDINATE ARCHITECTURAL, STRUCTURAL, MECHANICAL, ELECTRICAL DRAWINGS BEFORE CONSTRUCTION AND NOTIFY ARCHITECT OF ANY DISCREPANCIES.
7. THESE DRAWINGS ARE NOT INTENDED TO SHOW CIVIL, STRUCTURAL, MECHANICAL OR ELECTRICAL INFORMATION.

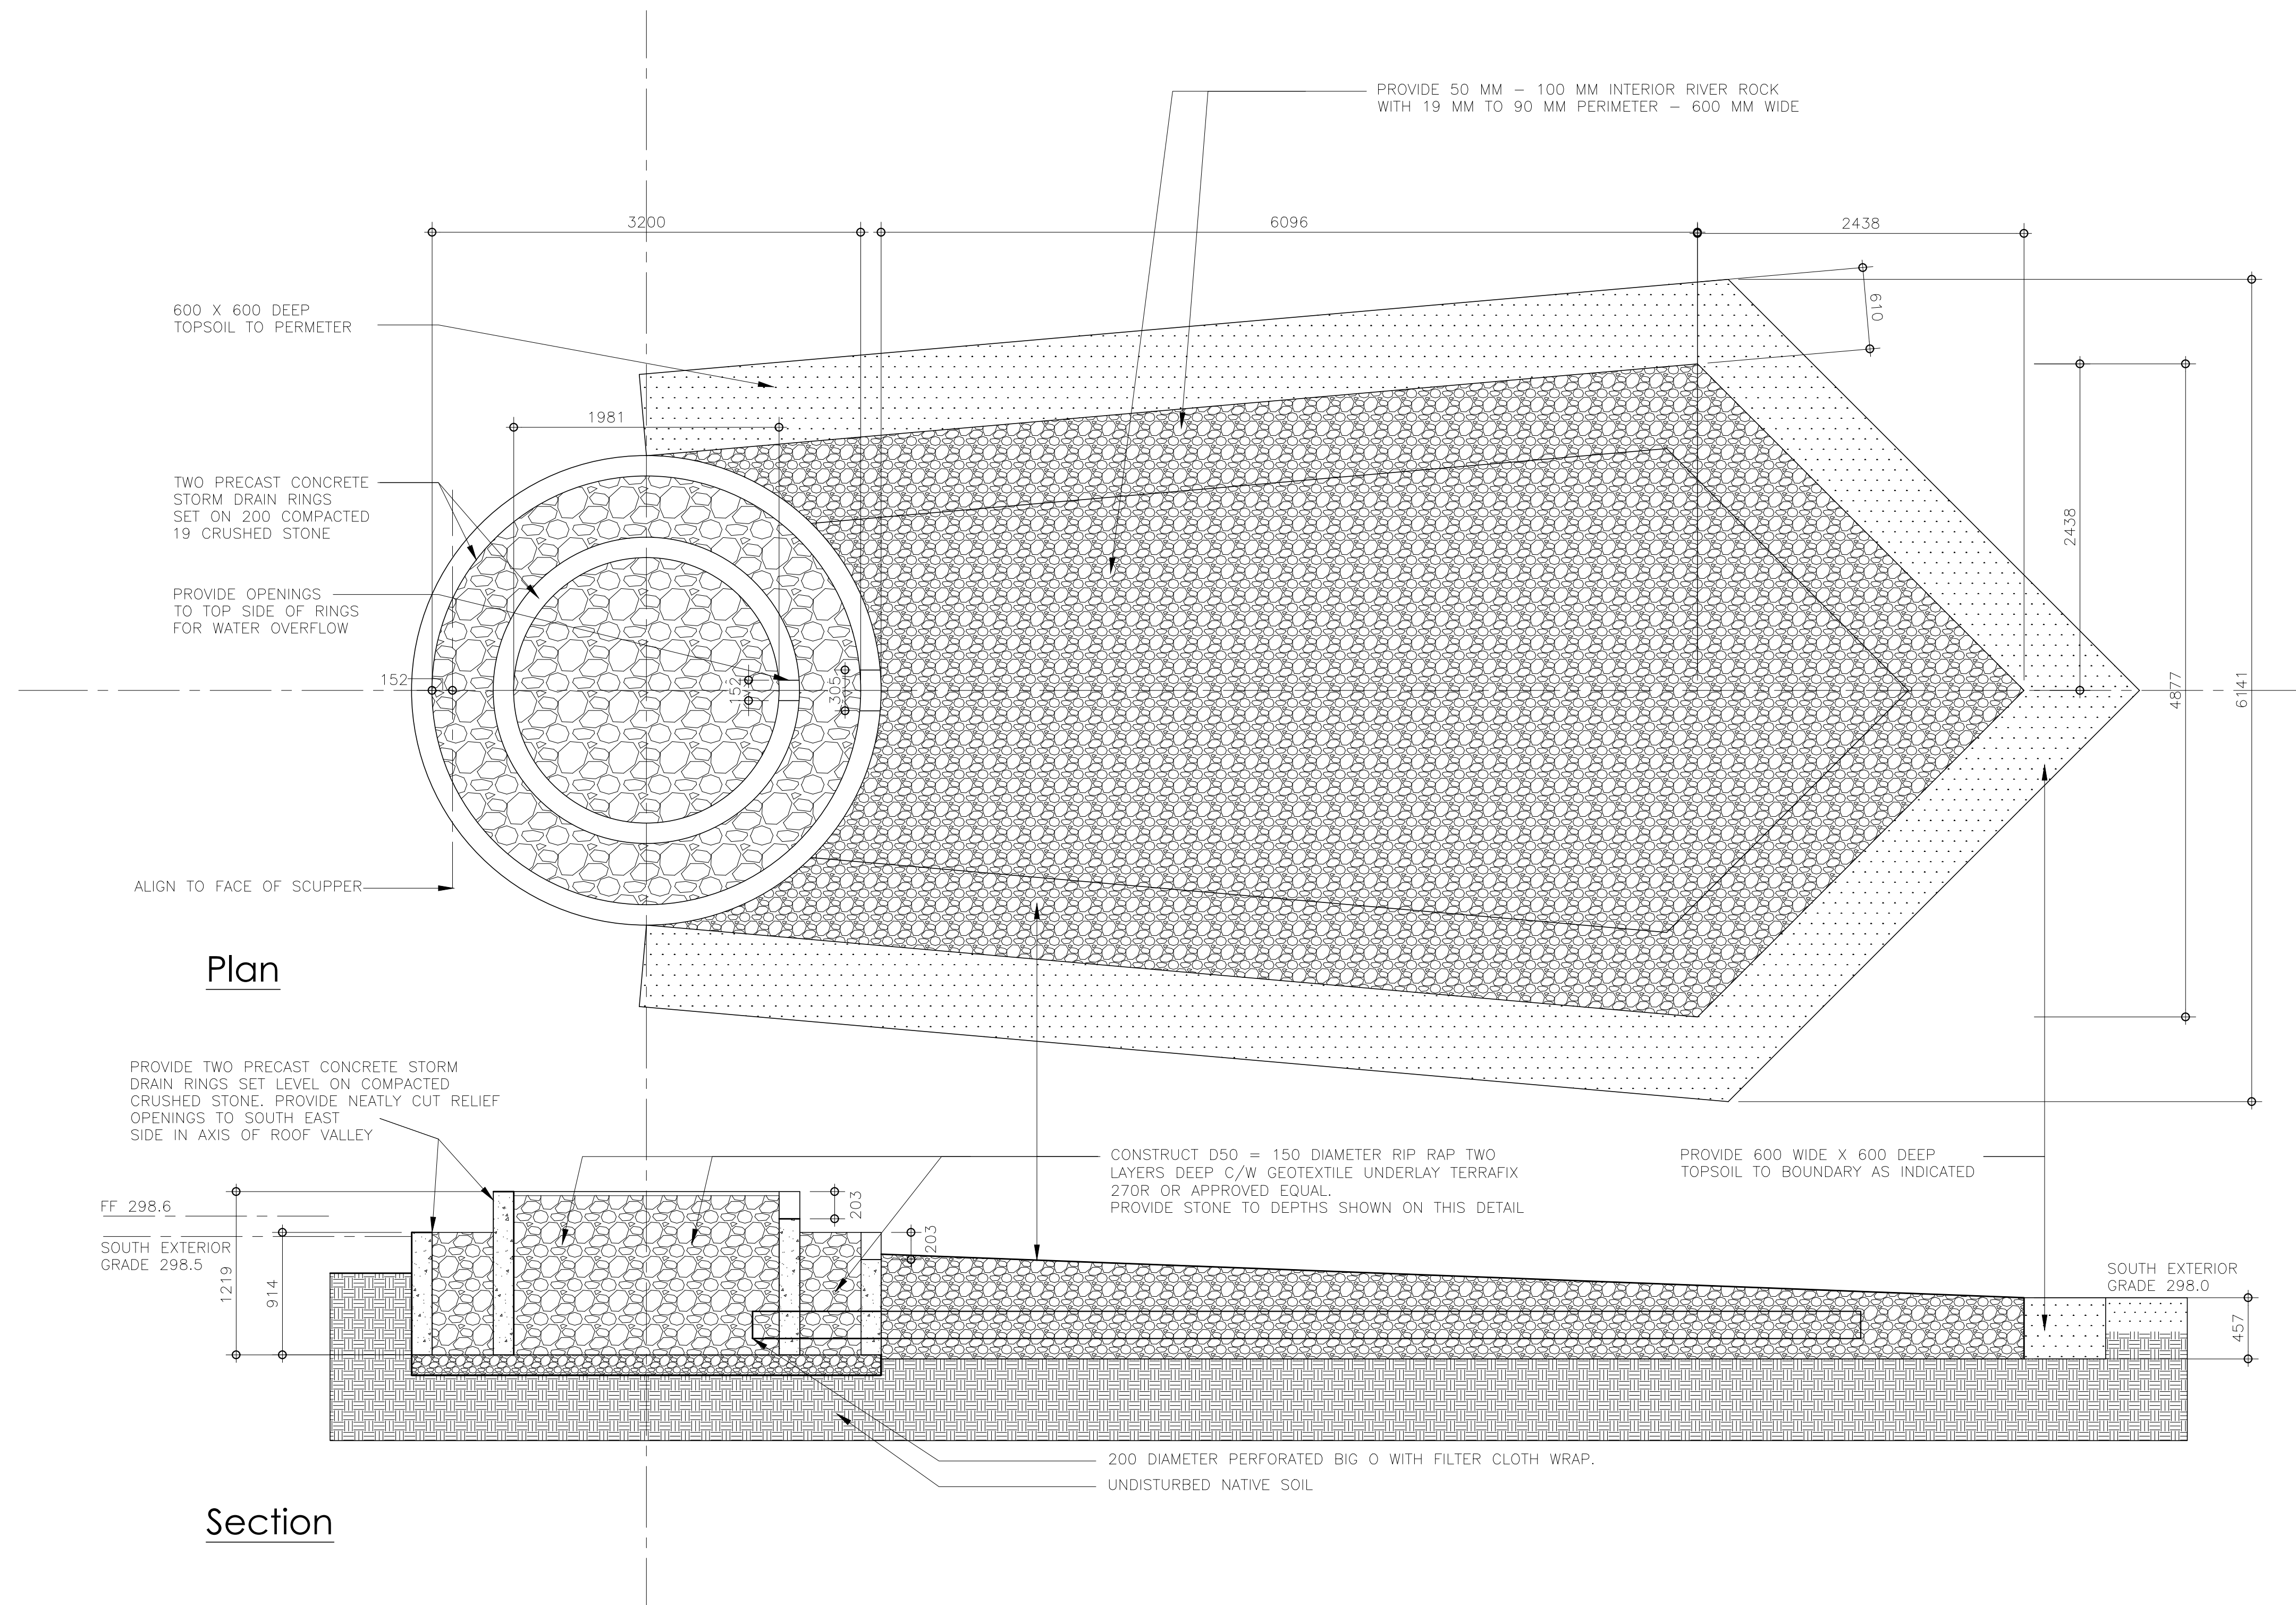

Plan

Section

1 Water Feature Details
1.2 Scale 1:30

5		
4		
3	AS-BUILT	2018.07.23
2	Issued for Tender & Permit	2017.05.12
1	Issued for 90% Review	2017.04.10
NO.	REVISION	DATE

MARKLEVITZ ARCHITECTS
inc

516 HURON STREET, STRATFORD, ONTARIO N5A 5T7
 TEL: 519 271 9230 FAX: 519 271 6560
 www.marklevitz.com

THESE DRAWINGS ARE AN INSTRUMENT OF SERVICE AND ALL INFORMATION WITHIN IS THE SOLE PROPERTY AND COPYRIGHT OF MARKLEVITZ ARCHITECTS INC. REPRODUCTION OF THESE DOCUMENTS WITHOUT WRITTEN PERMISSION OF THE ARCHITECT AND CONSULTANTS IS STRICTLY PROHIBITED.


PROJECT
New Waste Management Administration Building

LOCATION
 384060 Salford Road
 Township of Oxford, Ontario

FOR
 Oxford County

DRAWING
Water Feature Details

	DRAWING NO. A1.2
	PROJ. No: 3153-16
	DATE: 2017.05.12

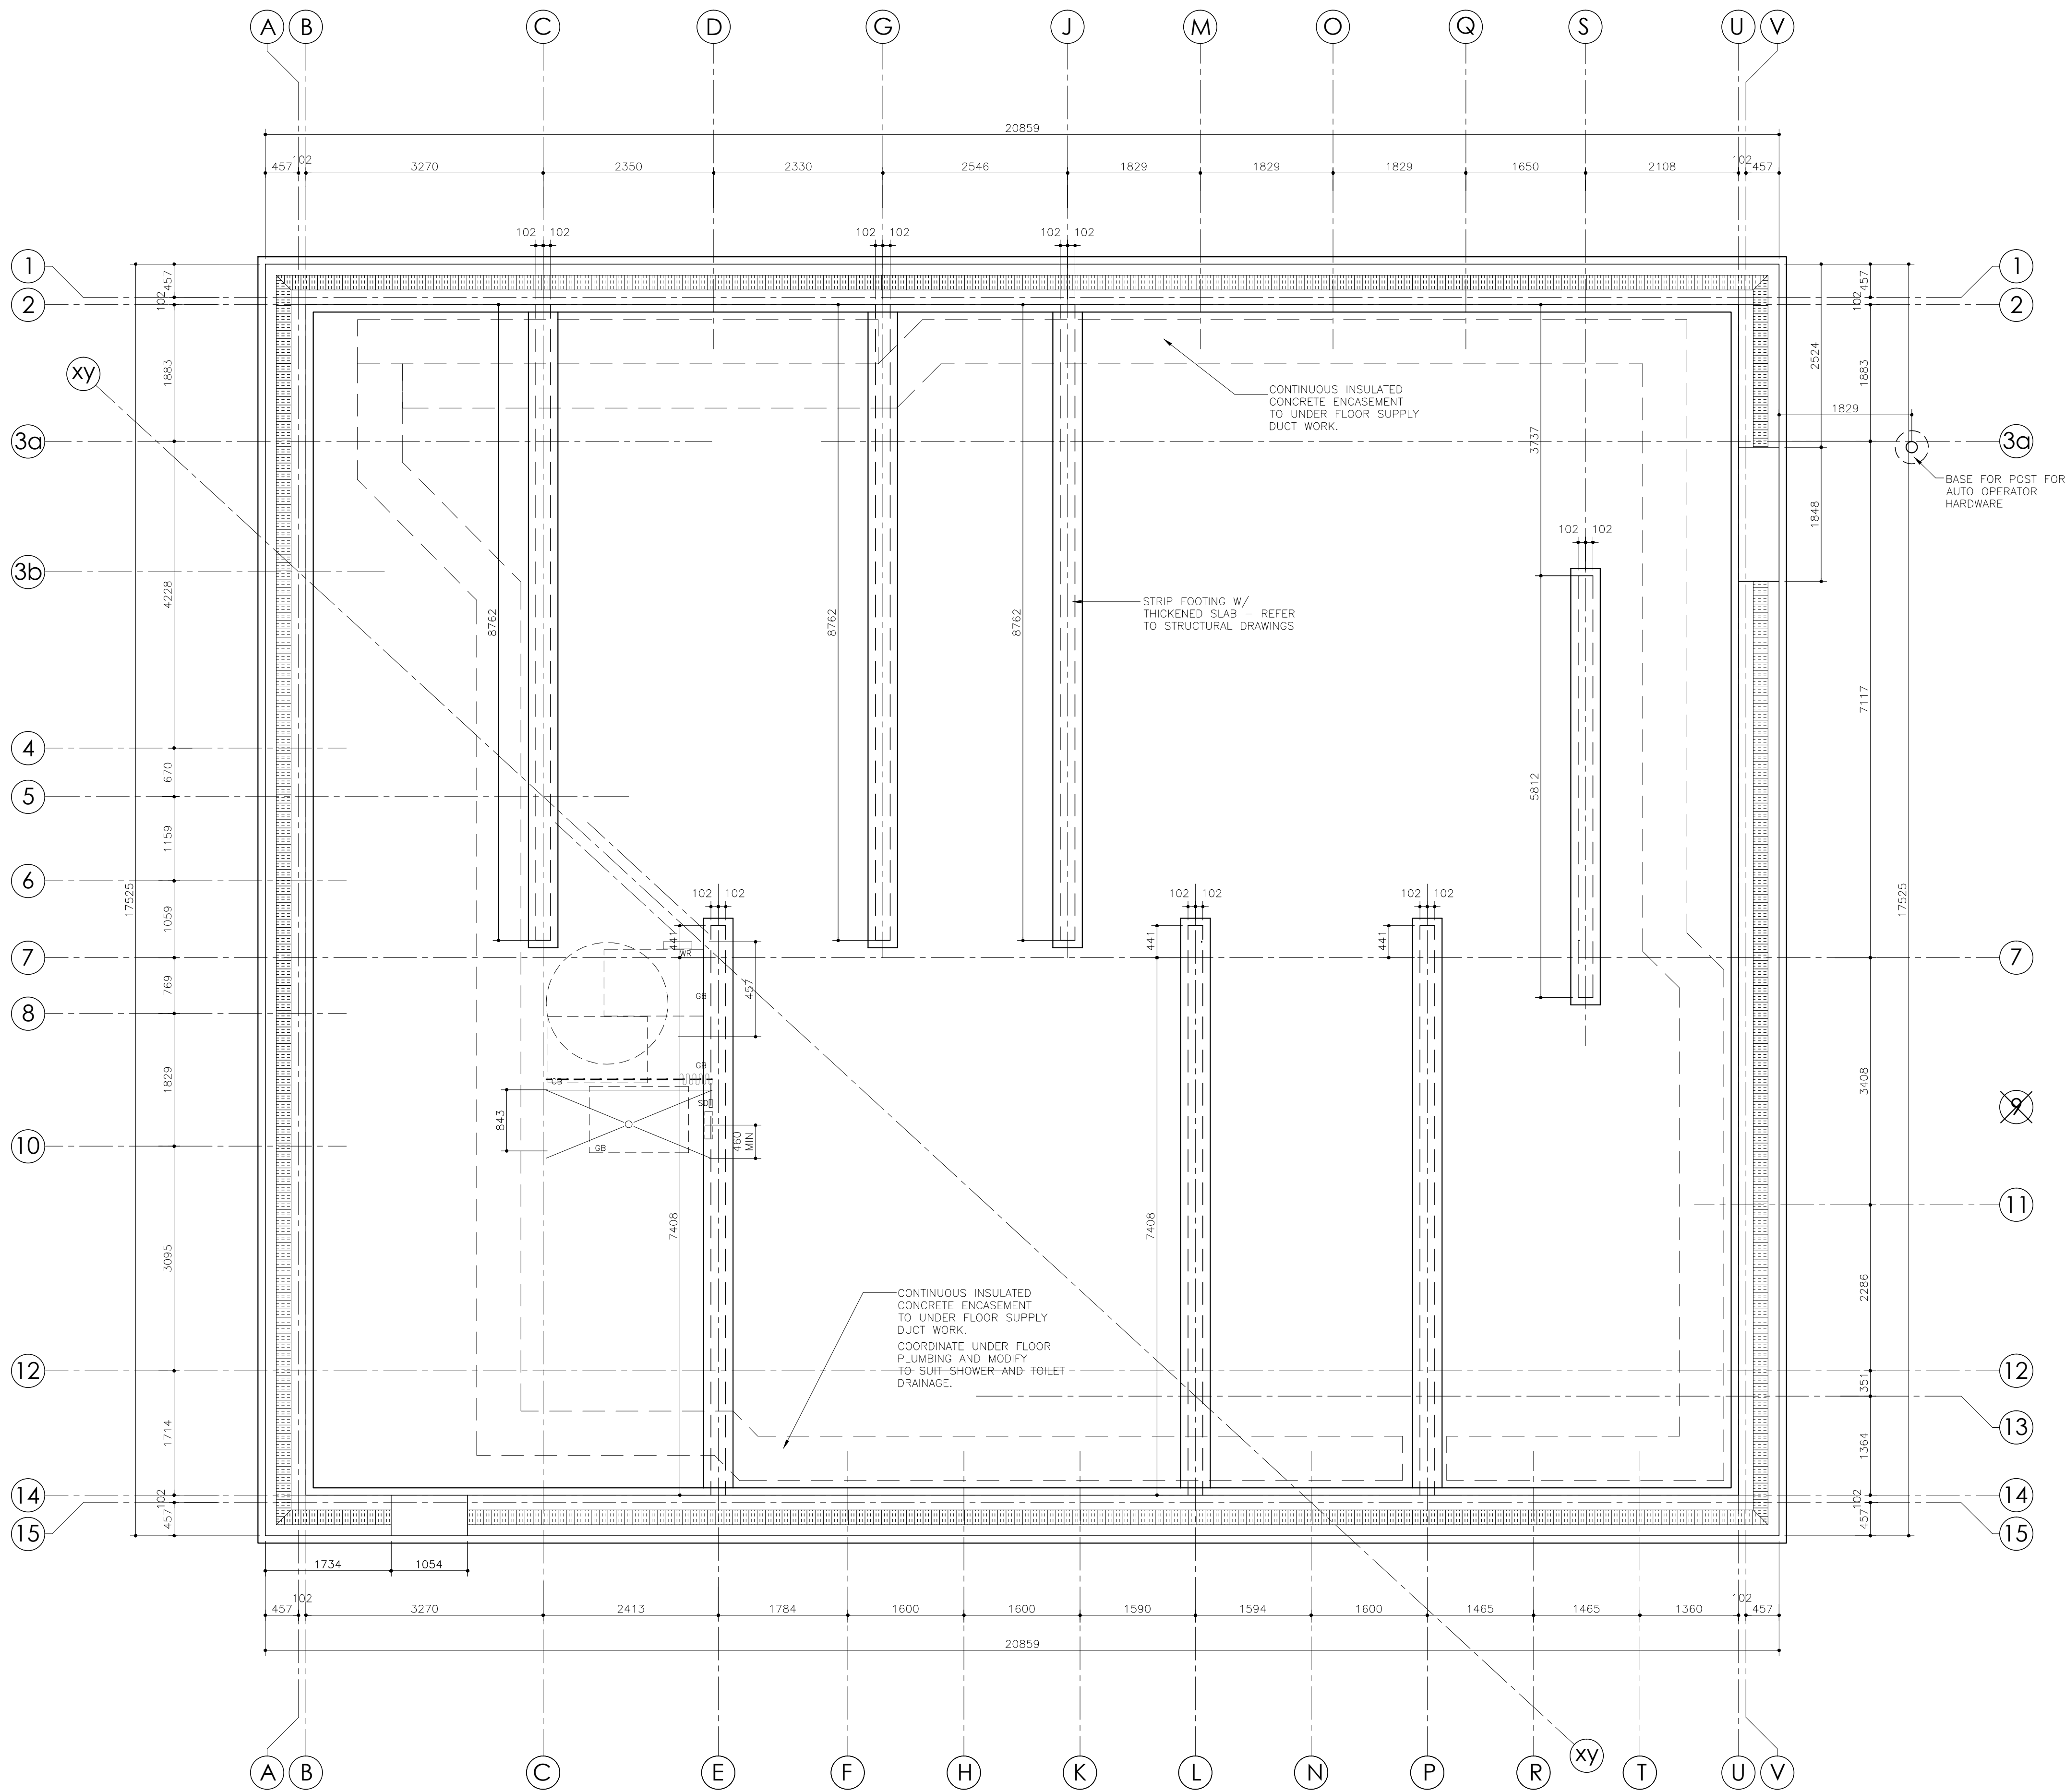

- GENERAL NOTES:**
1. THE GENERAL NOTES REFER TO ALL ARCHITECTURAL DRAWINGS.
 2. DO NOT SCALE DRAWINGS.
 3. SITE CHECK ALL DIMENSIONS PRIOR TO CONSTRUCTION.
 4. NOTHING ON THESE DRAWINGS SUPERSEDES THE REGULATIONS OF THE GOVERNING CODES INCLUDING THE ONTARIO BUILDING CODE.
 5. NOTIFY ARCHITECT OF ALL CONFLICTS AND DISCREPANCIES PRIOR TO CONSTRUCTION.
 6. CONTRACTOR TO COORDINATE ARCHITECTURAL, STRUCTURAL, MECHANICAL, ELECTRICAL DRAWINGS BEFORE CONSTRUCTION AND NOTIFY ARCHITECT OF ANY DISCREPANCIES.
 7. THESE DRAWINGS ARE NOT INTENDED TO SHOW CIVIL, STRUCTURAL, MECHANICAL OR ELECTRICAL INFORMATION.

5		
4		
3	AS-BUILT	2018.07.23
2	Issued for Tender & Permit	2017.05.12
1	Issued for 90% Review	2017.04.10
NO.	REVISION	DATE




516 HURON STREET, STRATFORD, ONTARIO N5A 5T7
 TEL: 519 271 9230 FAX: 519 271 6560
 www.marklevitz.com

THESE DRAWINGS ARE AN INSTRUMENT OF SERVICE AND ALL INFORMATION WITHIN IS THE SOLE PROPERTY AND COPYRIGHT OF MARKLEVITZ ARCHITECTS INC. REPRODUCTION OF THESE DOCUMENTS WITHOUT WRITTEN PERMISSION OF THE ARCHITECT AND CONSULTANTS IS STRICTLY PROHIBITED.

PROJECT	New Waste Management Administration Building
LOCATION	384060 Salford Road Township of Oxford, Ontario
FOR	Oxford County
DRAWING	Foundation Plan

DRAWING NO.	A2
PROJ. No:	3153-16
DATE:	2017.05.12

1 Foundation Plan
 A2 Scale 1:50

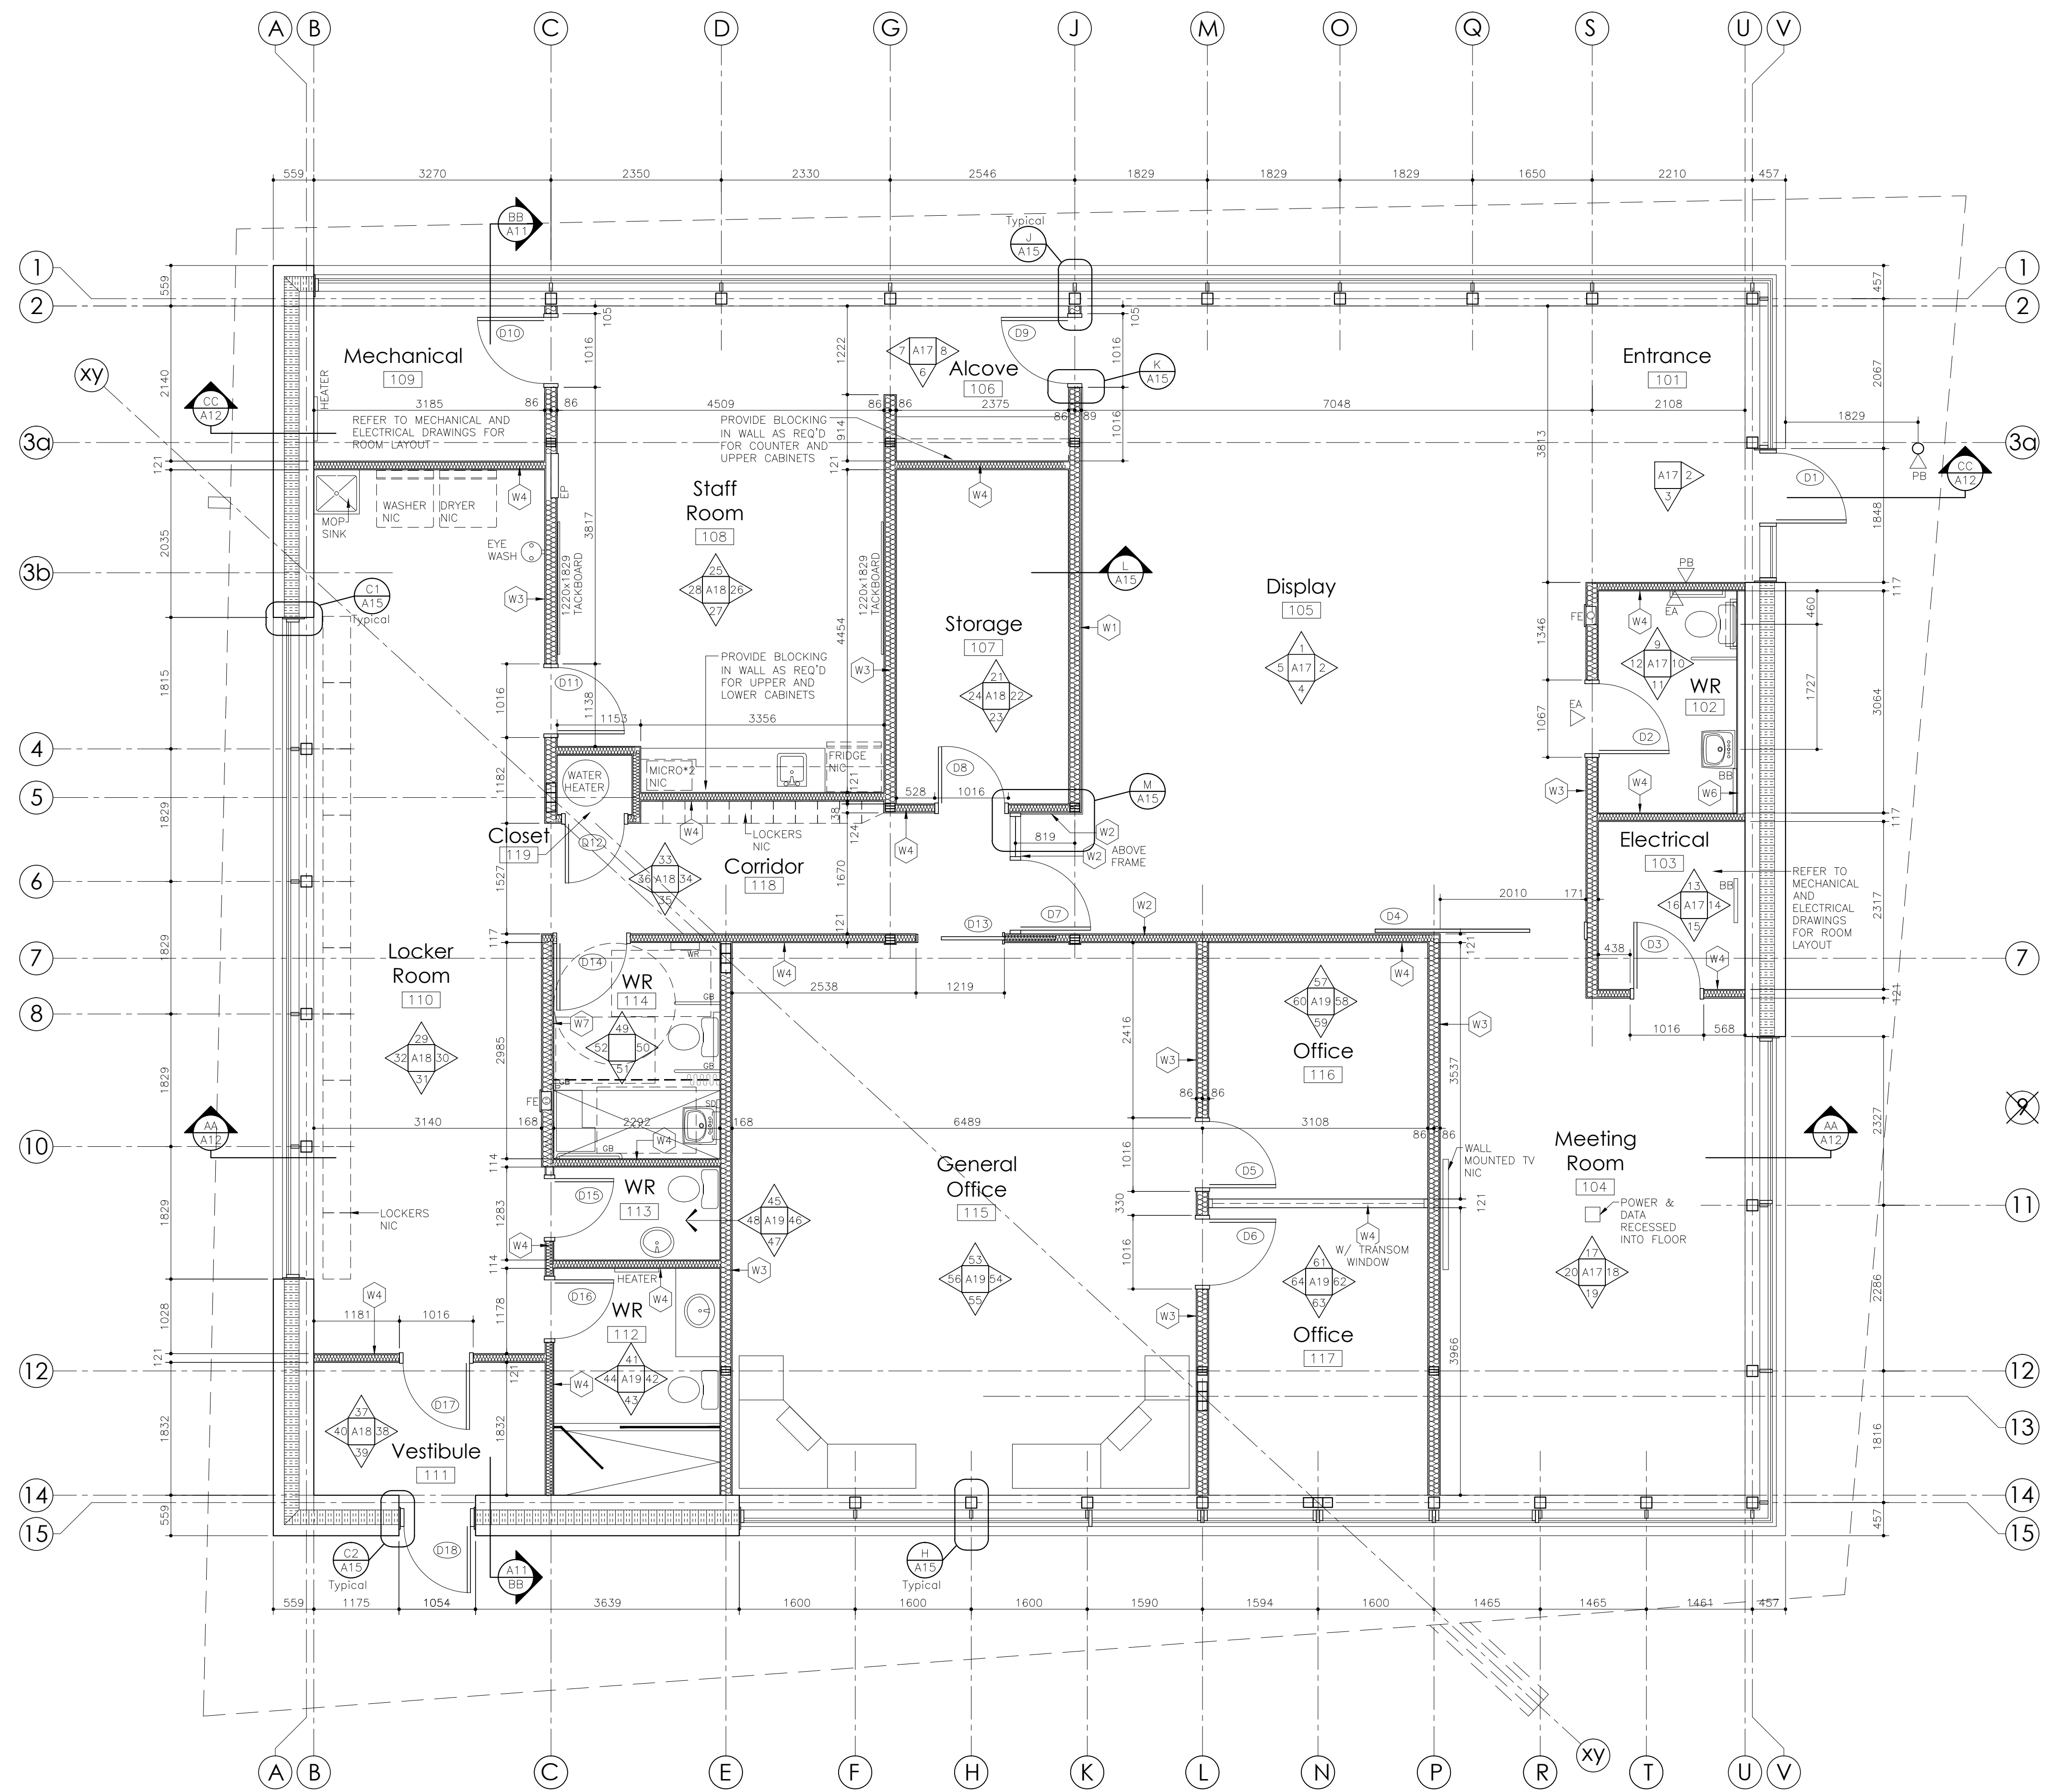

- GENERAL NOTES:**
1. THE GENERAL NOTES REFER TO ALL ARCHITECTURAL DRAWINGS.
 2. DO NOT SCALE DRAWINGS.
 3. SITE CHECK ALL DIMENSIONS PRIOR TO CONSTRUCTION.
 4. NOTHING ON THESE DRAWINGS SUPERSEDES THE REGULATIONS OF THE GOVERNING CODES INCLUDING THE ONTARIO BUILDING CODE.
 5. NOTIFY ARCHITECT OF ALL CONFLICTS AND DISCREPANCIES PRIOR TO CONSTRUCTION.
 6. CONTRACTOR TO COORDINATE ARCHITECTURAL, STRUCTURAL, MECHANICAL, ELECTRICAL DRAWINGS BEFORE CONSTRUCTION AND NOTIFY ARCHITECT OF ANY DISCREPANCIES.
 7. THESE DRAWINGS ARE NOT INTENDED TO SHOW CIVIL, STRUCTURAL, MECHANICAL OR ELECTRICAL INFORMATION.

Wall Type Legend

- W1 WALL TYPE 1: RECLAIMED PALLET WOOD SECURED TO 19 FIR PLYWOOD 38x140 WOOD LOAD BEARING STUDS @ 406 O.C., FILL CAVITY WITH SOUND ATTENUATION INSULATION, 15.9 GYPSUM BOARD TO WEST FACE
- W2 WALL TYPE 2: RECLAIMED PALLET WOOD SECURED TO 19 FIR PLYWOOD 38x102 WOOD STUDS @ 406 O.C., FILL CAVITY WITH SOUND ATTENUATION INSULATION 15.9 GYPSUM BOARD TO WEST AND NORTH FACE
- W3 WALL TYPE 3: 38x140 LOAD BEARING WOOD STUDS @ 406 O.C., FILL CAVITY WITH SOUND ATTENUATION INSULATION, 15.9 GYPSUM BOARD EACH SIDE SUBSTITUTE 12.7 WATER RESISTANT GYPSUM BOARD TO ALL SURFACES WITHIN WASHROOMS
- W4 WALL TYPE 4: 38x102 WOOD STUDS @ 406 O.C., FILL CAVITY WITH SOUND ATTENUATION INSULATION 15.9 GYPSUM BOARD EACH SIDE SUBSTITUTE 12.7 WATER RESISTANT GYPSUM BOARD TO ALL SURFACES WITHIN WASHROOMS
- W5 WALL TYPE 5: SITE MIXED CONCRETE: 203 INTERIOR LOAD BEARING WYTHE 203 POLYISOCYANURATE (MINIMUM TWO LAYERS-OVERLAP SEAMS) 150 SITE MIXED CONCRETE EXTERIOR WYTHE ALL SURFACES EXPOSED AND FINISHED
- W6 WALL TYPE 6: 38x140 WOOD STUD PLUMBING CHASE W/ 12.7 WATER RESISTANT GYPSUM BOARD
- W7 WALL TYPE 7: 38x140 WOOD STUD WALL W/ 12.7 WATER RESISTANT GYPSUM BOARD ON WASHROOM SIDE AND 15.9 GYPSUM BOARD ON LOCKER ROOM SIDE

NO.	REVISION	DATE
5		
4		
3	AS-BUILT	2018.07.23
2	Issued for Tender & Permit	2017.05.12
1	Issued for 90% Review	2017.04.10

M
MARKLEVITZ
ARCHITECTS
inc

516 HURON STREET, STRATFORD, ONTARIO N5A 5T7
 TEL: 519 271 9230 FAX: 519 271 6560
 www.marklevitz.com

THESE DRAWINGS ARE AN INSTRUMENT OF SERVICE AND ALL INFORMATION WITHIN IS THE SOLE PROPERTY AND COPYRIGHT OF MARKLEVITZ ARCHITECTS INC. REPRODUCTION OF THESE DOCUMENTS WITHOUT WRITTEN PERMISSION OF THE ARCHITECT AND CONSULTANTS IS STRICTLY PROHIBITED.


PROJECT	New Waste Management Administration Building
LOCATION	384060 Salford Road Township of Oxford, Ontario
FOR	Oxford County
DRAWING	Construction Plan

DRAWING NO.	A3
PROJ. No:	3153-16
DATE:	2017.05.12

1
A3 Construction Plan
 Scale 1:50

GENERAL NOTES:

1. THE GENERAL NOTES REFER TO ALL ARCHITECTURAL DRAWINGS.
2. DO NOT SCALE DRAWINGS.
3. SITE CHECK ALL DIMENSIONS PRIOR TO CONSTRUCTION.
4. NOTHING ON THESE DRAWINGS SUPERSEDES THE REGULATIONS OF THE GOVERNING CODES INCLUDING THE ONTARIO BUILDING CODE.
5. NOTIFY ARCHITECT OF ALL CONFLICTS AND DISCREPANCIES PRIOR TO CONSTRUCTION.
6. CONTRACTOR TO COORDINATE ARCHITECTURAL, STRUCTURAL, MECHANICAL, ELECTRICAL DRAWINGS BEFORE CONSTRUCTION AND NOTIFY ARCHITECT OF ANY DISCREPANCIES.
7. THESE DRAWINGS ARE NOT INTENDED TO SHOW CIVIL, STRUCTURAL, MECHANICAL OR ELECTRICAL INFORMATION.

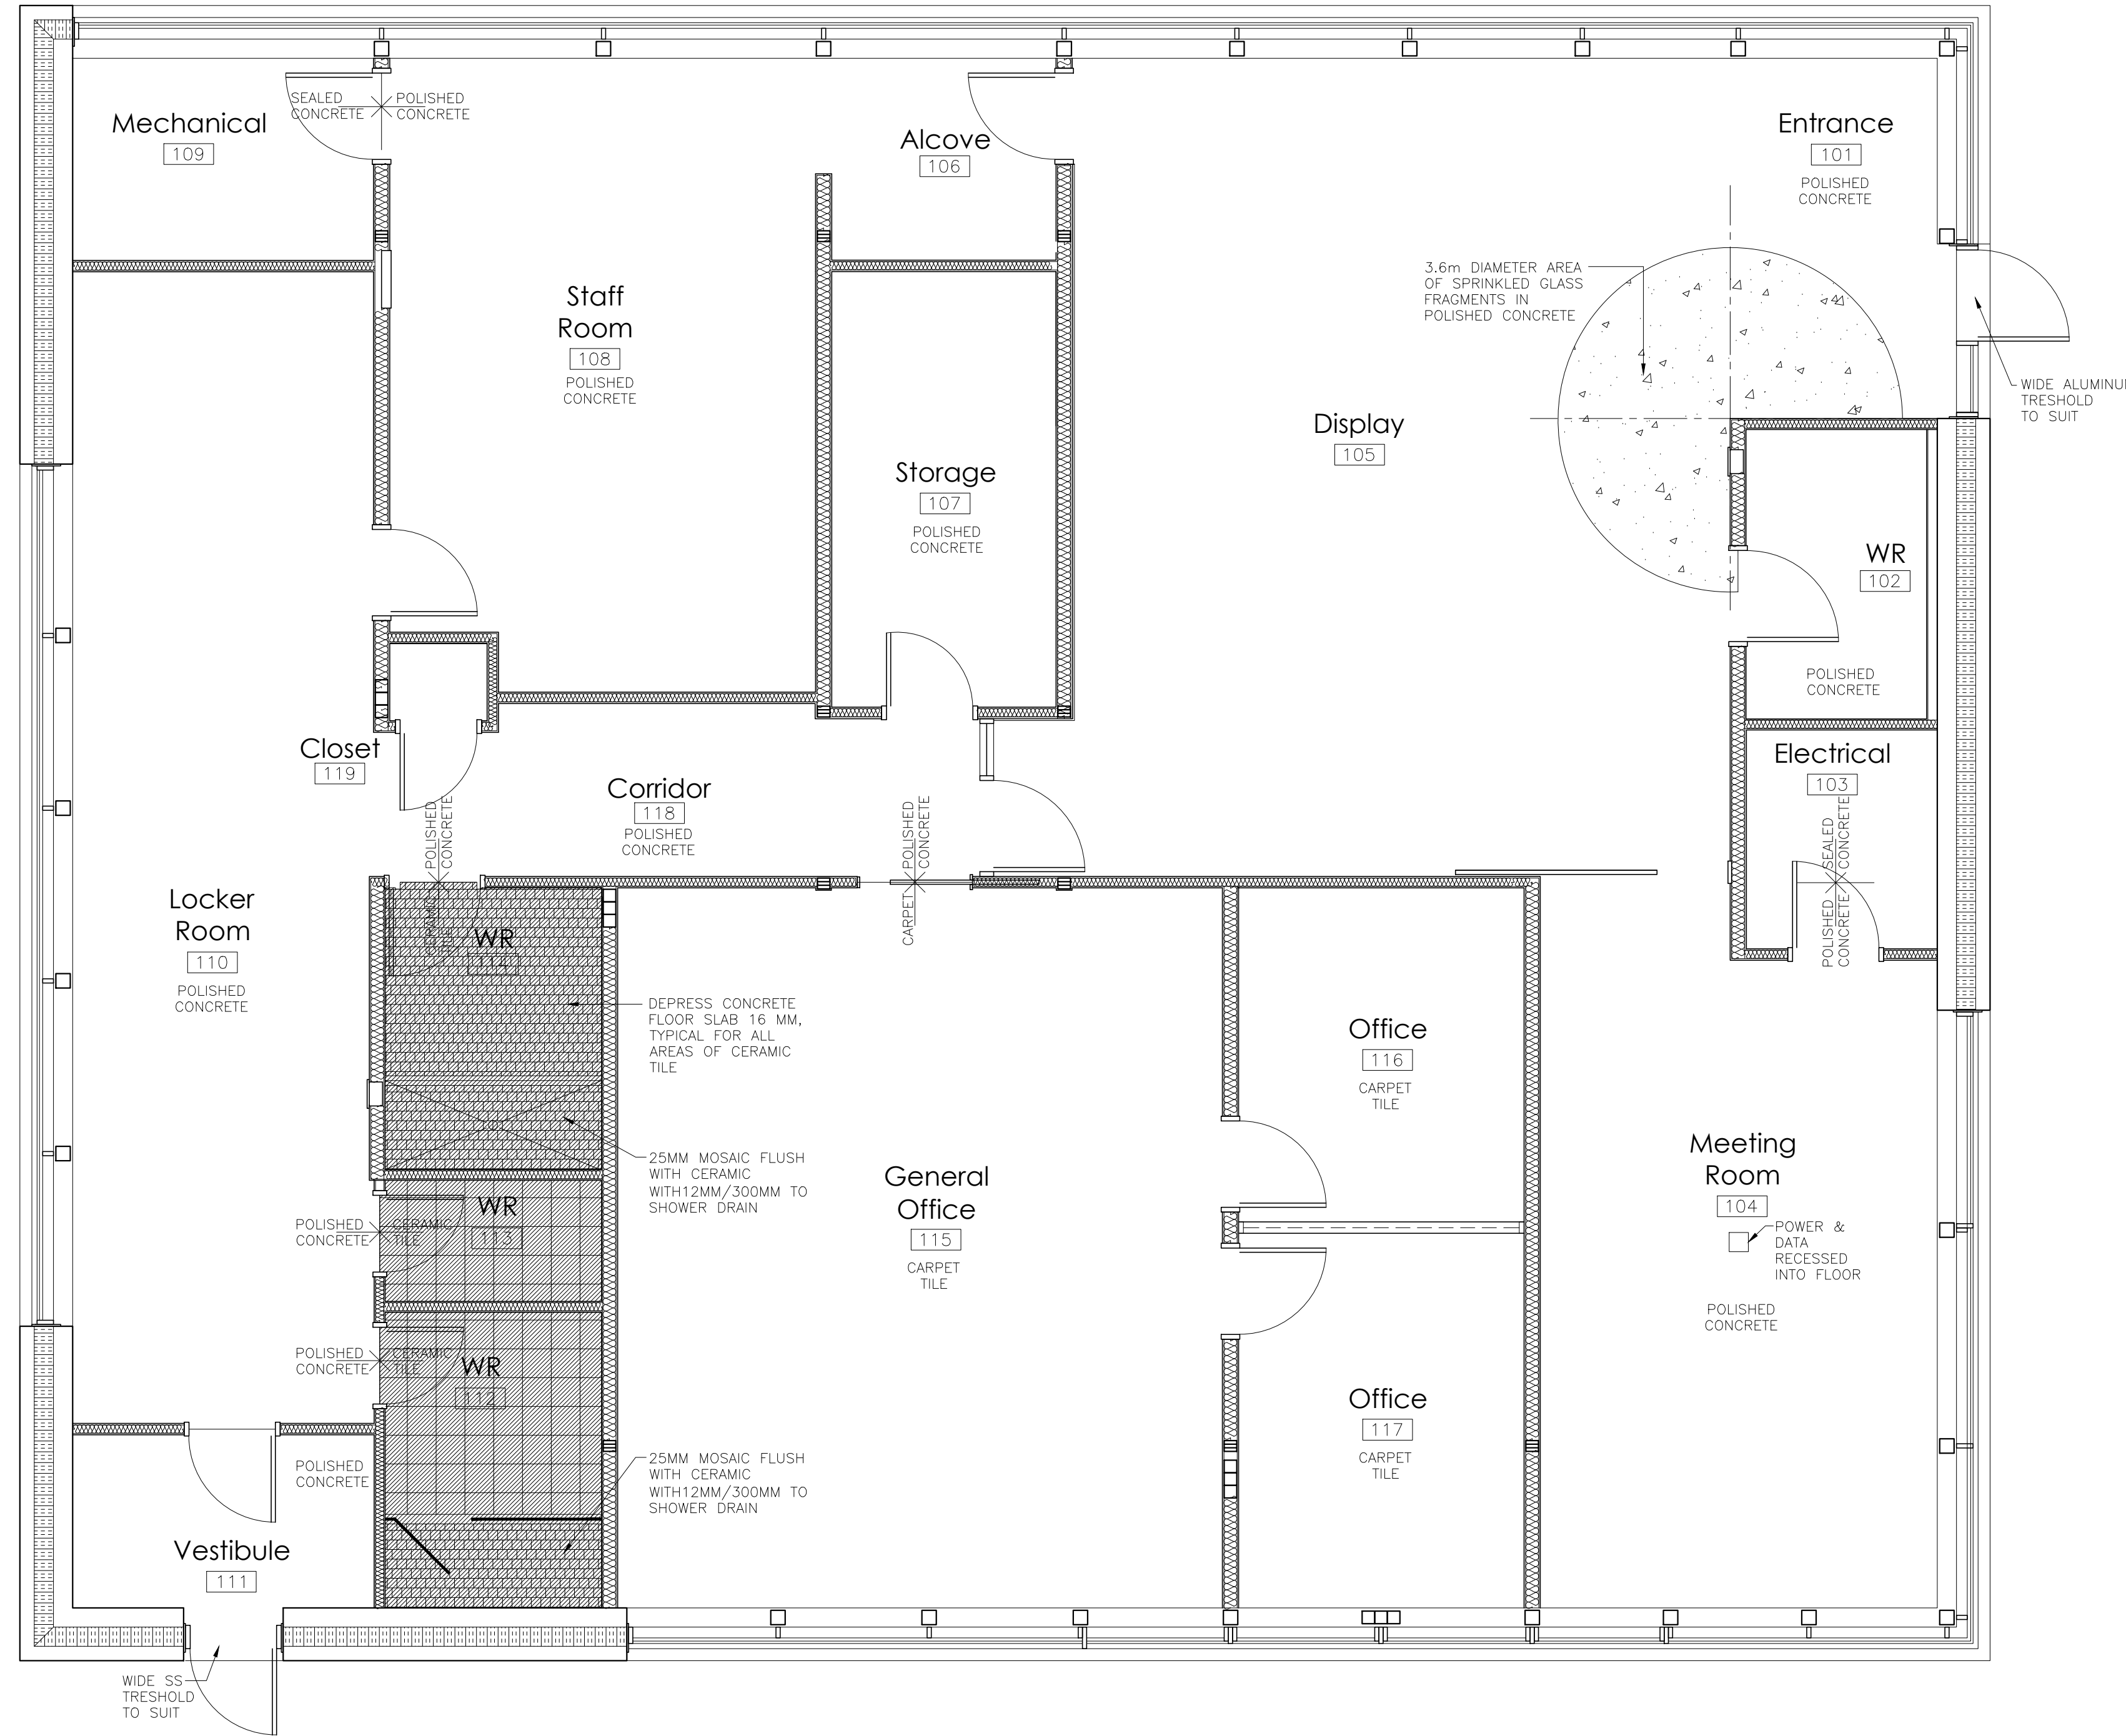

1 Floor Pattern Plan
A4 Scale 1:50

5		
4		
3	AS-BUILT	2018.07.23
2	Issued for Tender & Permit	2017.05.12
1	Issued for 90% Review	2017.04.10
NO.	REVISION	DATE

M
MARKLEVITZ ARCHITECTS
inc

516 HURON STREET, STRATFORD, ONTARIO N5A 5T7
TEL: 519 271 9230 FAX: 519 271 6560
www.marklevitz.com

THESE DRAWINGS ARE AN INSTRUMENT OF SERVICE AND ALL INFORMATION WITHIN IS THE SOLE PROPERTY AND COPYRIGHT OF MARKLEVITZ ARCHITECTS INC. REPRODUCTION OF THESE DOCUMENTS WITHOUT WRITTEN PERMISSION OF THE ARCHITECT AND CONSULTANTS IS STRICTLY PROHIBITED.

PROJECT
New Waste Management Administration Building

LOCATION
384060 Salford Road
Township of Oxford, Ontario


FOR
Oxford County

DRAWING
Floor Pattern Plan

DRAWING NO.	A4
PROJ. No:	3153-16
DATE:	2017.05.12

GENERAL NOTES:

1. THE GENERAL NOTES REFER TO ALL ARCHITECTURAL DRAWINGS.
2. DO NOT SCALE DRAWINGS.
3. SITE CHECK ALL DIMENSIONS PRIOR TO CONSTRUCTION.
4. NOTHING ON THESE DRAWINGS SUPERSEDES THE REGULATIONS OF THE GOVERNING CODES INCLUDING THE ONTARIO BUILDING CODE.
5. NOTIFY ARCHITECT OF ALL CONFLICTS AND DISCREPANCIES PRIOR TO CONSTRUCTION.
6. CONTRACTOR TO COORDINATE ARCHITECTURAL, STRUCTURAL, MECHANICAL, ELECTRICAL DRAWINGS BEFORE CONSTRUCTION AND NOTIFY ARCHITECT OF ANY DISCREPANCIES.
7. THESE DRAWINGS ARE NOT INTENDED TO SHOW CIVIL, STRUCTURAL, MECHANICAL OR ELECTRICAL INFORMATION.

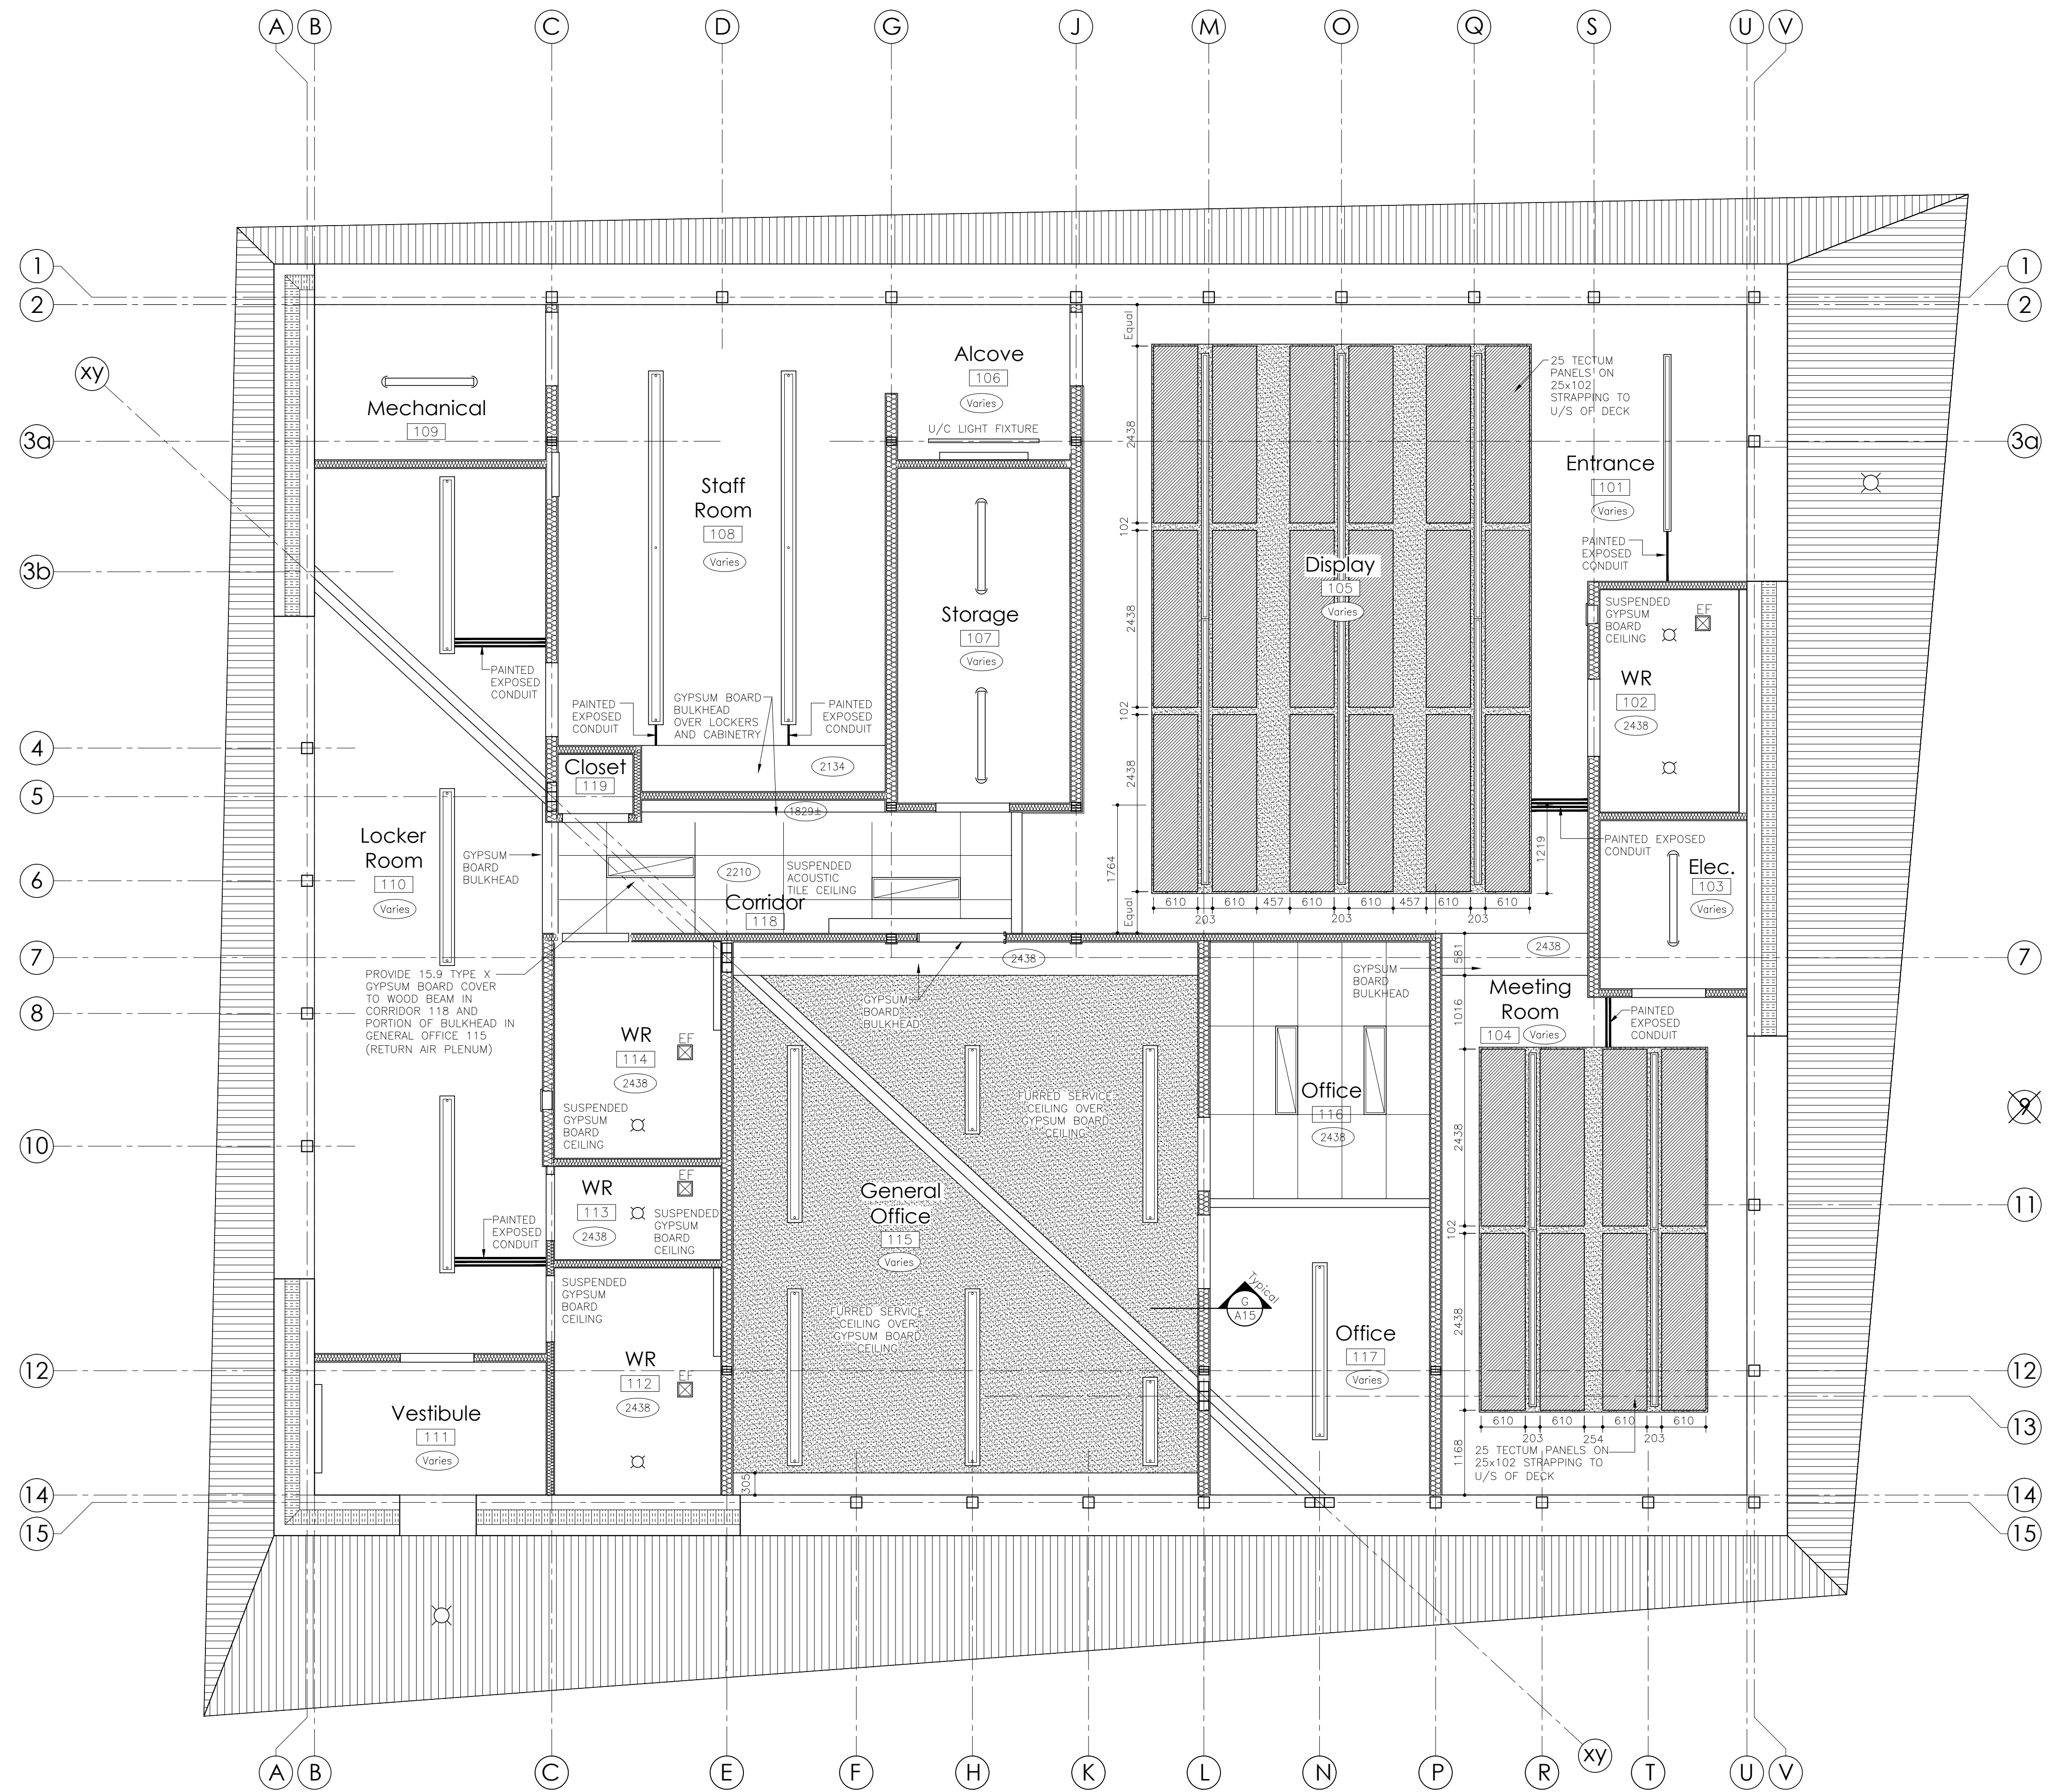

Legend

- SURFACE MOUNTED UTILITY LIGHT FIXTURE
- WALL MOUNTED LIGHT FIXTURE
- SUSPENDED LIGHT FIXTURE - LENGTHS VARY
- RECESSED POT LIGHT
- RECESSED LIGHT FIXTURE
- SURFACE MOUNTED FIXTURE BETWEEN TECTUM PANELS - LENGTHS VARY
- EXHAUST FAN

REFER TO ELECTRICAL AND MECHANICAL DRAWINGS AND SPECIFICATIONS FOR FURTHER INFORMATION

- PAINTED EXPOSED CONDUIT SPECIFICALLY LOCATED
- TECTUM PANELS - PAINTED
- FURRED SERVICE SPACE ON UNDERSIDE OF MAIN GYPSUM BOARD CEILING

- GENERAL CEILING NOTES:**
- ENTIRE UNDERSIDE OF STRUCTURE IS TO BE FINISHED WITH 15.9mm TYPE 'X' GYPSUM BOARD ON CERTAINTED 'MEMBRAN' VAPOUR BARRIER
 - WOOD BEAM ON GRIDLINE 'XL' IS TO REMAIN EXPOSED EXCEPT WHERE PASSING THRU THE RETURN AIR FLENUM IN CORRIDOR 118 AND THE BULKHEAD IN GENERAL OFFICE 115
 - SUSPENDED GYPSUM BOARD CEILINGS, BULKHEADS, ACOUSTIC TILE CEILINGS AND FURRED SERVICE SPACES ARE IN ADDITION TO THIS MAIN CEILING
 - ALL EXPOSED CONDUIT IS TO BE PAINTED. SOME LOCATIONS OF CONDUIT ARE SPECIFICALLY LOCATED FOR ESTHETIC REASONS
 - ALL EXPOSED DUCTWORK IS TO BE PAINTED

5		
4		
3	AS-BUILT	2018.07.23
2	Issued for Tender & Permit	2017.05.12
1	Issued for 90% Review	2017.04.10
NO.	REVISION	DATE



516 HURON STREET, STRATFORD, ONTARIO N5A 5T7
 TEL: 519 271 9230 FAX: 519 271 6560
 www.marklevitz.com

THESE DRAWINGS ARE AN INSTRUMENT OF SERVICE AND ALL INFORMATION WITHIN IS THE SOLE PROPERTY AND COPYRIGHT OF MARKLEVITZ ARCHITECTS INC. REPRODUCTION OF THESE DOCUMENTS WITHOUT WRITTEN PERMISSION OF THE ARCHITECT AND CONSULTANTS IS STRICTLY PROHIBITED.

PROJECT
 New Waste Management Administration Building


LOCATION
 384060 Salford Road
 Township of Oxford, Ontario


FOR
 Oxford County

DRAWING
 Reflected Ceiling Plan

DRAWING NO.	A5
PROJ. No:	3153-16
DATE:	2017.05.12

1 Reflected Ceiling Plan
 A5 Scale 1:50

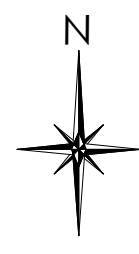

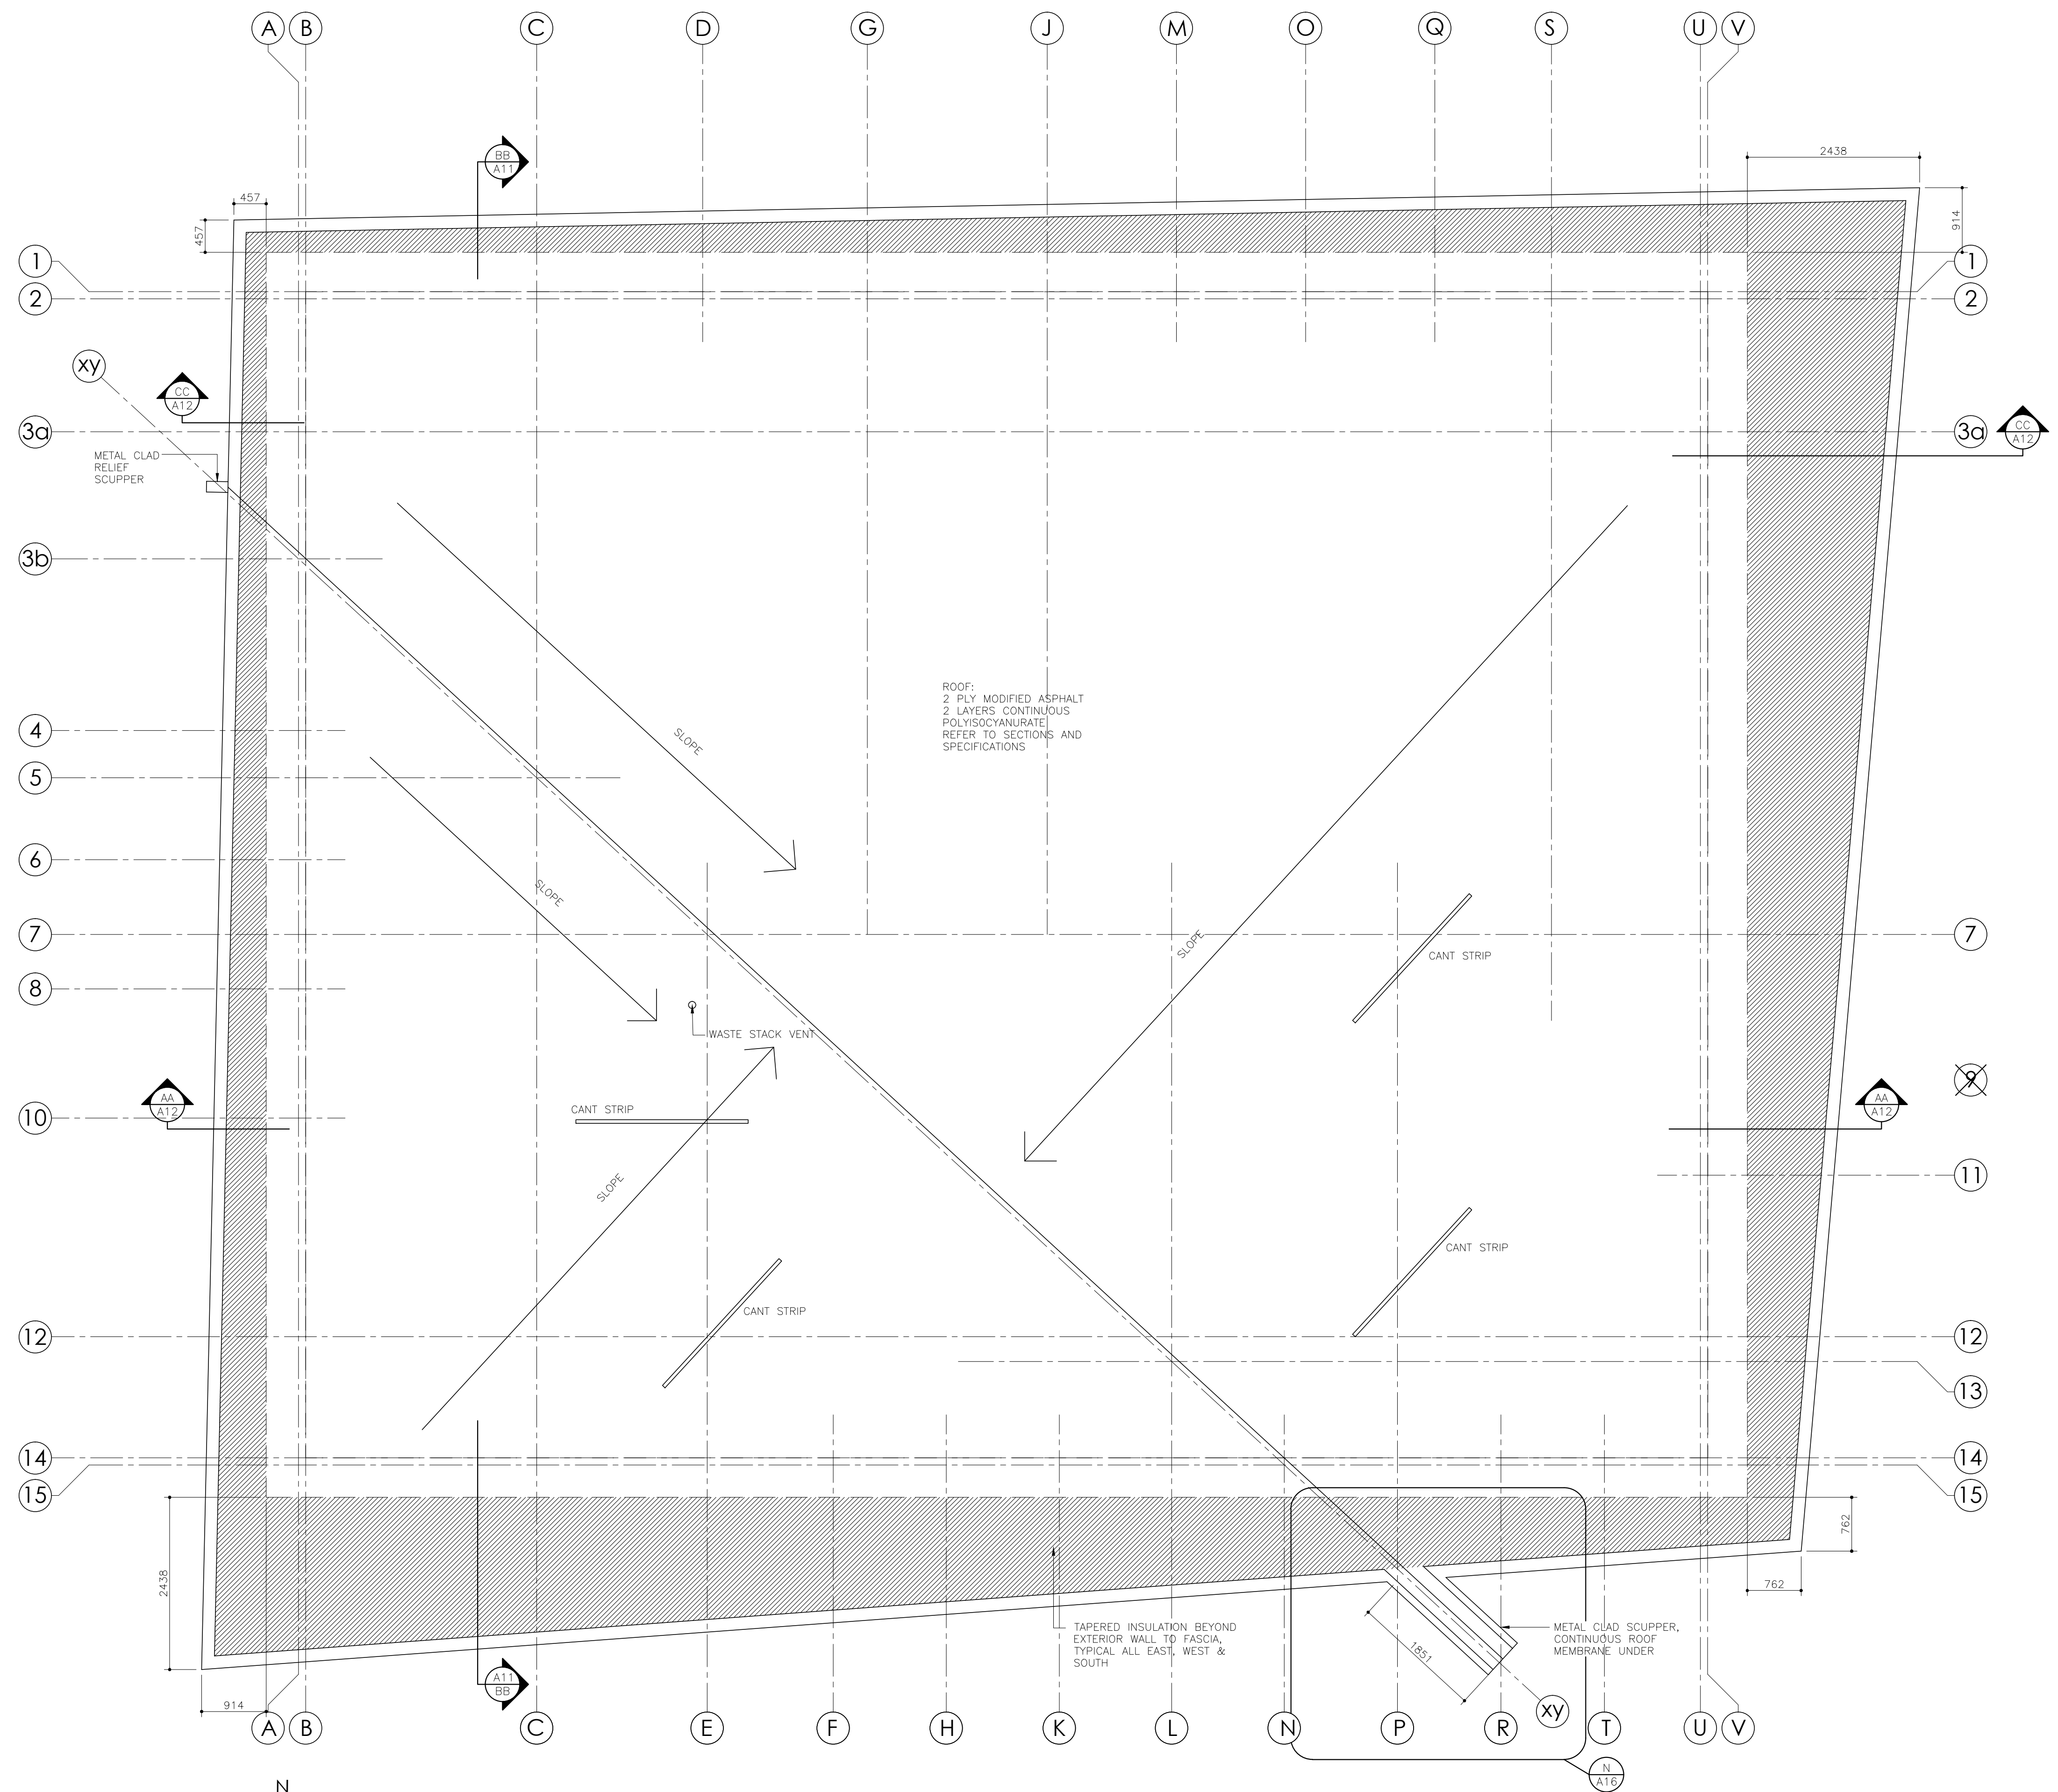


ROOF:
 2 PLY MODIFIED ASPHALT
 2 LAYERS CONTINUOUS
 POLYISOCYANURATE
 REFER TO SECTIONS AND
 SPECIFICATIONS

TAPERED INSULATION BEYOND
 EXTERIOR WALL TO FASCIA,
 TYPICAL ALL EAST, WEST &
 SOUTH

METAL CLAD SCUPPER,
 CONTINUOUS ROOF
 MEMBRANE UNDER

1 Roof Plan
 A6 Scale 1:50

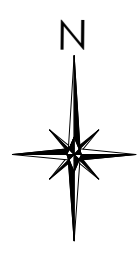

GENERAL NOTES:

1. THE GENERAL NOTES REFER TO ALL ARCHITECTURAL DRAWINGS.
2. DO NOT SCALE DRAWINGS.
3. SITE CHECK ALL DIMENSIONS PRIOR TO CONSTRUCTION.
4. NOTHING ON THESE DRAWINGS SUPERSEDES THE REGULATIONS OF THE GOVERNING CODES INCLUDING THE ONTARIO BUILDING CODE.
5. NOTIFY ARCHITECT OF ALL CONFLICTS AND DISCREPANCIES PRIOR TO CONSTRUCTION.
6. CONTRACTOR TO COORDINATE ARCHITECTURAL, STRUCTURAL, MECHANICAL, ELECTRICAL DRAWINGS BEFORE CONSTRUCTION AND NOTIFY ARCHITECT OF ANY DISCREPANCIES.
7. THESE DRAWINGS ARE NOT INTENDED TO SHOW CIVIL, STRUCTURAL, MECHANICAL OR ELECTRICAL INFORMATION.

5		
4		
3	AS-BUILT	2018.07.23
2	Issued for Tender & Permit	2017.05.12
1	Issued for 90% Review	2017.04.10
NO.	REVISION	DATE

M
 MARKLEVITZ
 ARCHITECTS
inc

516 HURON STREET, STRATFORD, ONTARIO N5A 5T7
 TEL: 519 271 9230 FAX: 519 271 6560
 www.marklevitz.com

THESE DRAWINGS ARE AN INSTRUMENT OF SERVICE AND ALL INFORMATION WITHIN IS THE SOLE PROPERTY AND COPYRIGHT OF MARKLEVITZ ARCHITECTS INC. REPRODUCTION OF THESE DOCUMENTS WITHOUT WRITTEN PERMISSION OF THE ARCHITECT AND CONSULTANTS IS STRICTLY PROHIBITED.


PROJECT
New Waste Management Administration Building

LOCATION
 384060 Salford Road
 Township of Oxford, Ontario


FOR
 Oxford County

DRAWING
 Roof Plan


DRAWING NO.	A6
PROJ. No:	3153-16
DATE:	2017.05.12

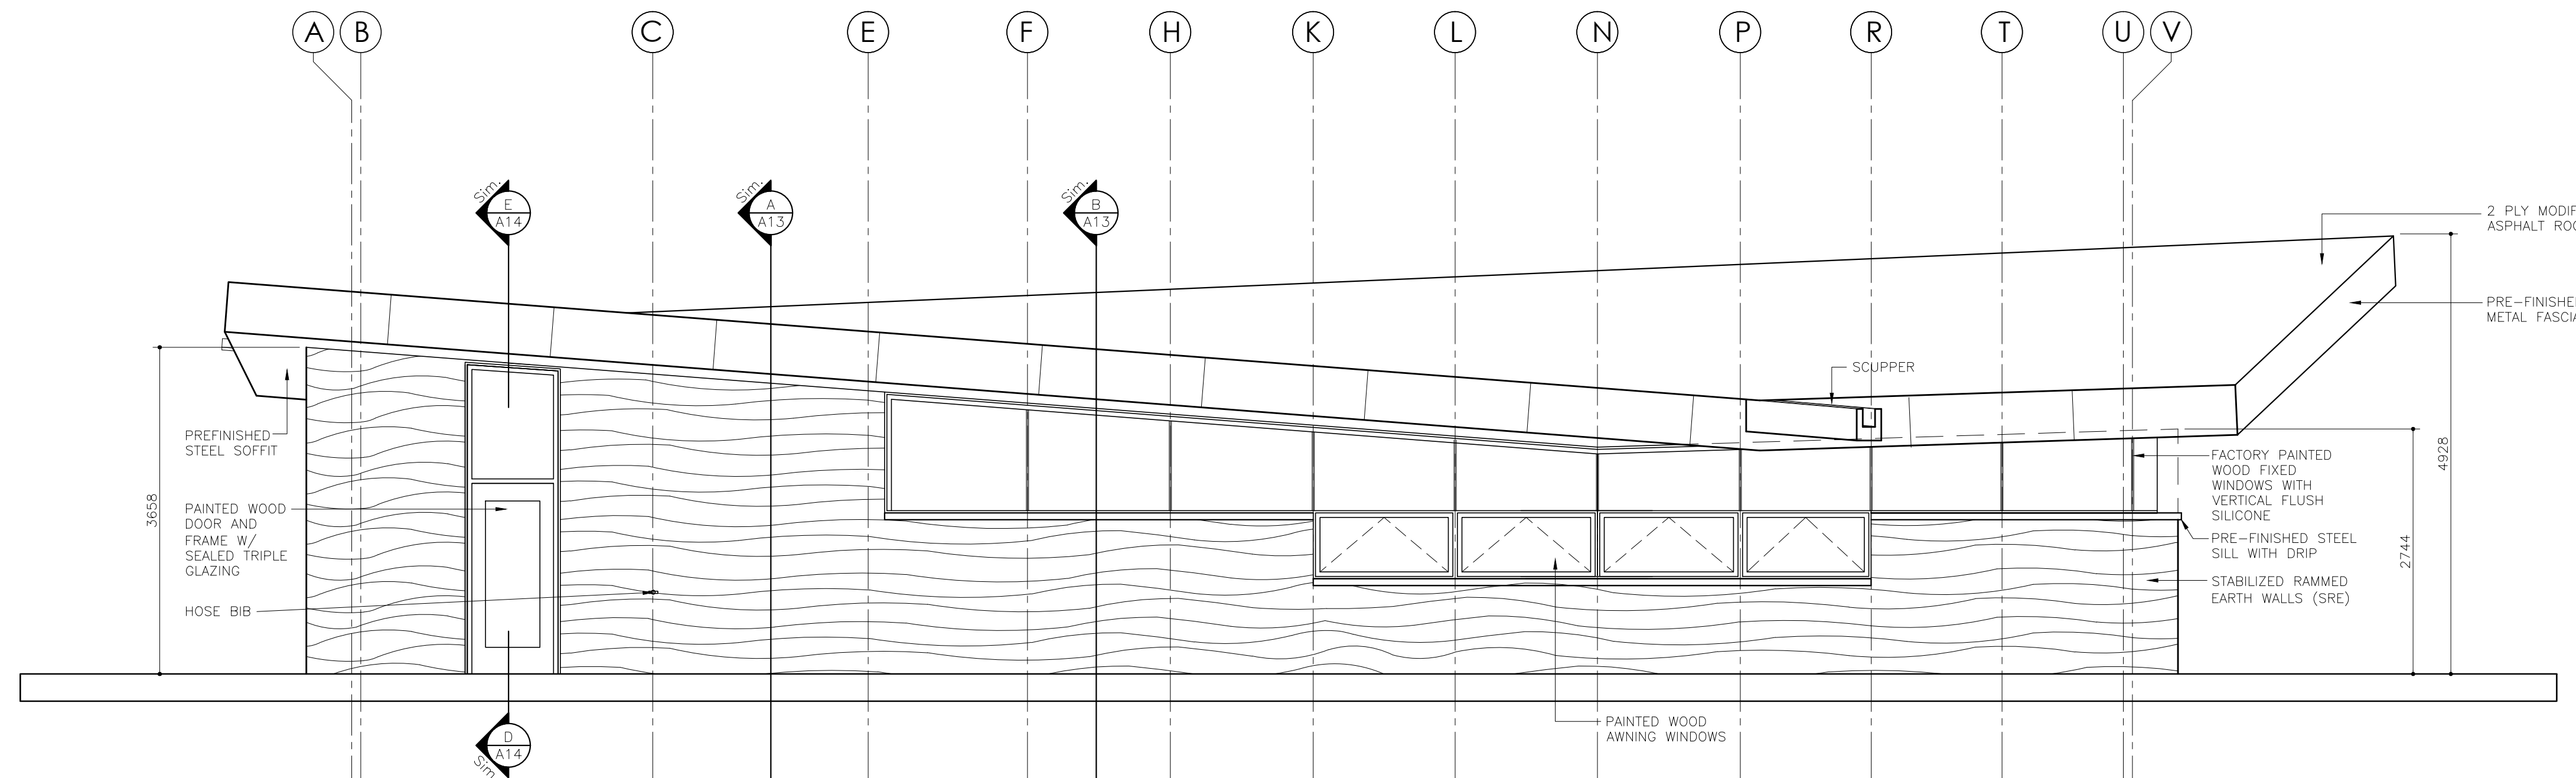

1 South Elevation
A7 Scale 1:50

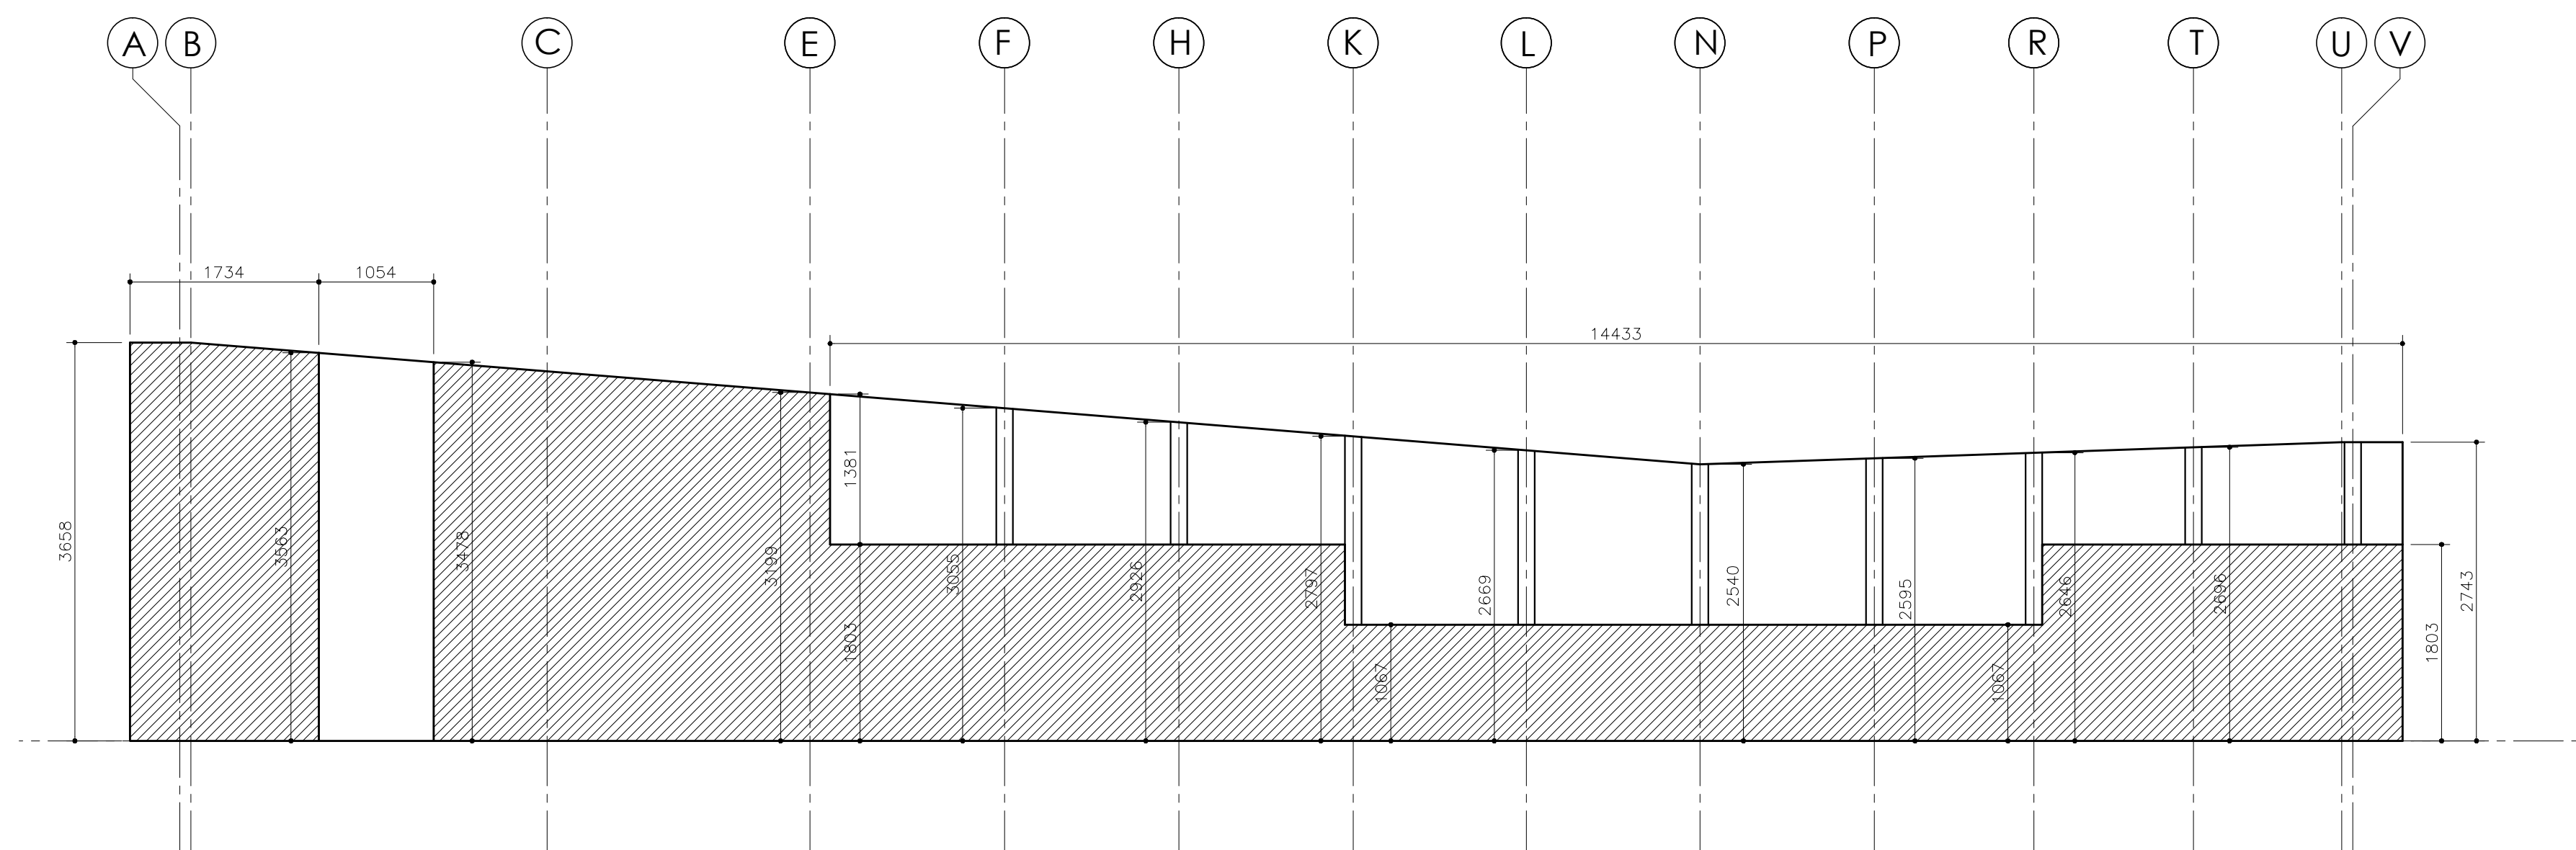

2 South Elevation - Wall & Column Dimensions
A7 Scale 1:50

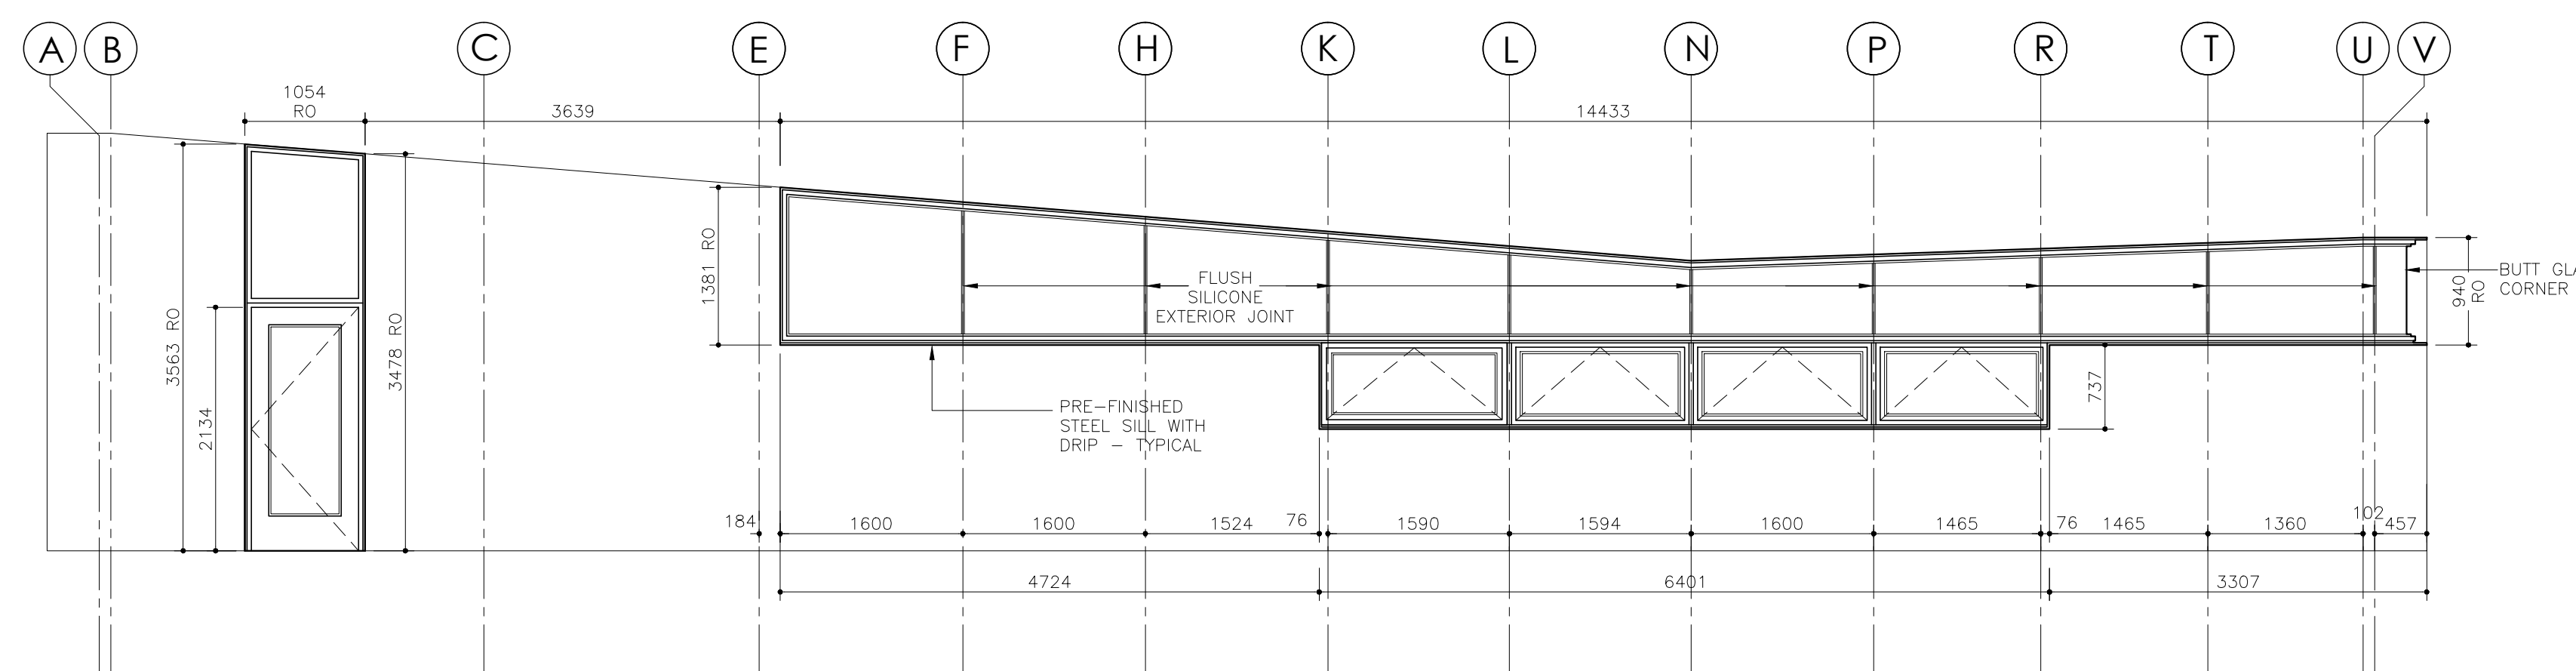

3 South Elevation - Windows & Doors
A7 Scale 1:50

GENERAL NOTES:

1. THE GENERAL NOTES REFER TO ALL ARCHITECTURAL DRAWINGS.
2. DO NOT SCALE DRAWINGS.
3. SITE CHECK ALL DIMENSIONS PRIOR TO CONSTRUCTION.
4. NOTHING ON THESE DRAWINGS SUPERSEDES THE REGULATIONS OF THE GOVERNING CODES INCLUDING THE ONTARIO BUILDING CODE.
5. NOTIFY ARCHITECT OF ALL CONFLICTS AND DISCREPANCIES PRIOR TO CONSTRUCTION.
6. CONTRACTOR TO COORDINATE ARCHITECTURAL, STRUCTURAL, MECHANICAL, ELECTRICAL DRAWINGS BEFORE CONSTRUCTION AND NOTIFY ARCHITECT OF ANY DISCREPANCIES.
7. THESE DRAWINGS ARE NOT INTENDED TO SHOW CIVIL, STRUCTURAL, MECHANICAL OR ELECTRICAL INFORMATION.

5		
4		
3	AS-BUILT	2018.07.23
2	Issued for Tender & Permit	2017.05.12
1	Issued for 90% Review	2017.04.10
NO.	REVISION	DATE



516 HURON STREET, STRATFORD, ONTARIO N5A 5T7
TEL: 519 271 9230 FAX: 519 271 6560
www.marklevitz.com

THESE DRAWINGS ARE AN INSTRUMENT OF SERVICE AND ALL INFORMATION WITHIN IS THE SOLE PROPERTY AND COPYRIGHT OF MARKLEVITZ ARCHITECTS INC. REPRODUCTION OF THESE DOCUMENTS WITHOUT WRITTEN PERMISSION OF THE ARCHITECT AND CONSULTANTS IS STRICTLY PROHIBITED.


PROJECT
New Waste Management Administration Building

LOCATION
384060 Salford Road
Township of Oxford, Ontario


FOR
Oxford County

DRAWING
South Elevations


DRAWING NO.	A7
PROJ. No:	3153-16
DATE:	2017.05.12

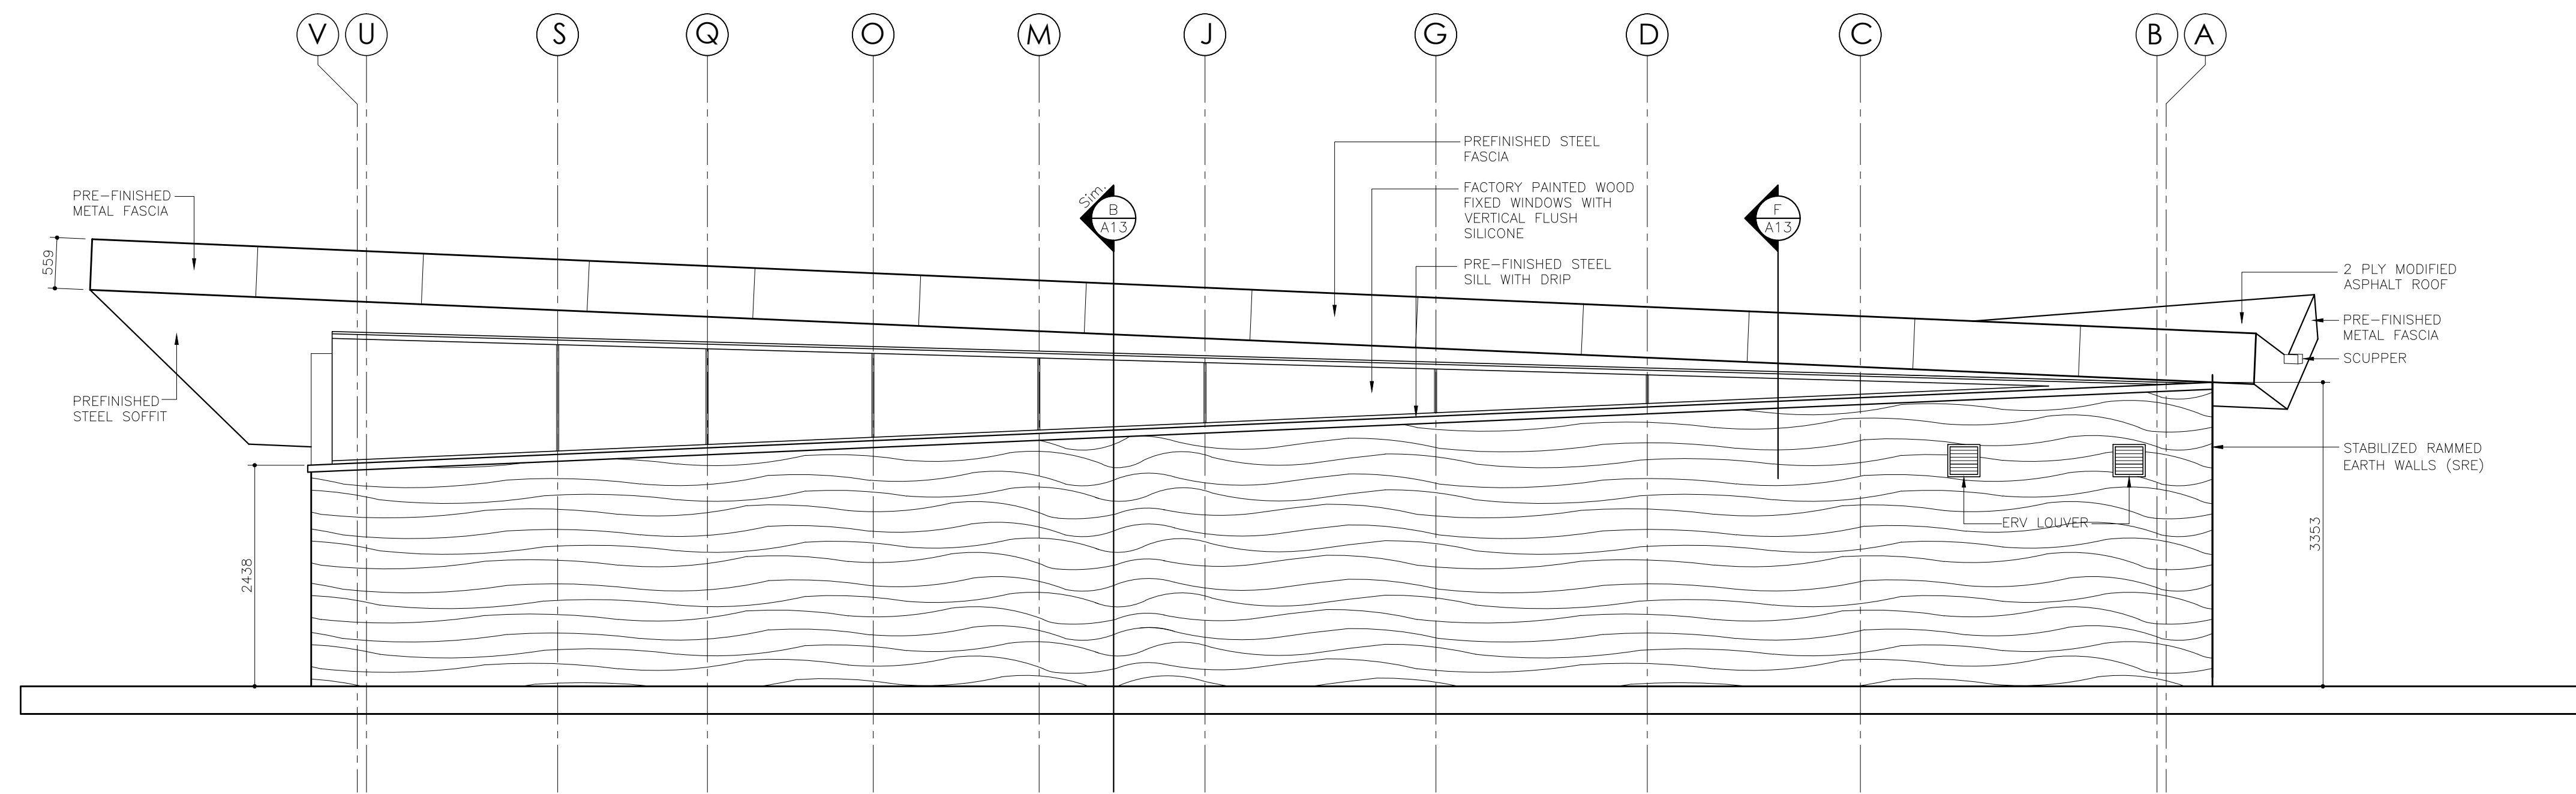

1 North Elevation
A8 Scale: 1:50

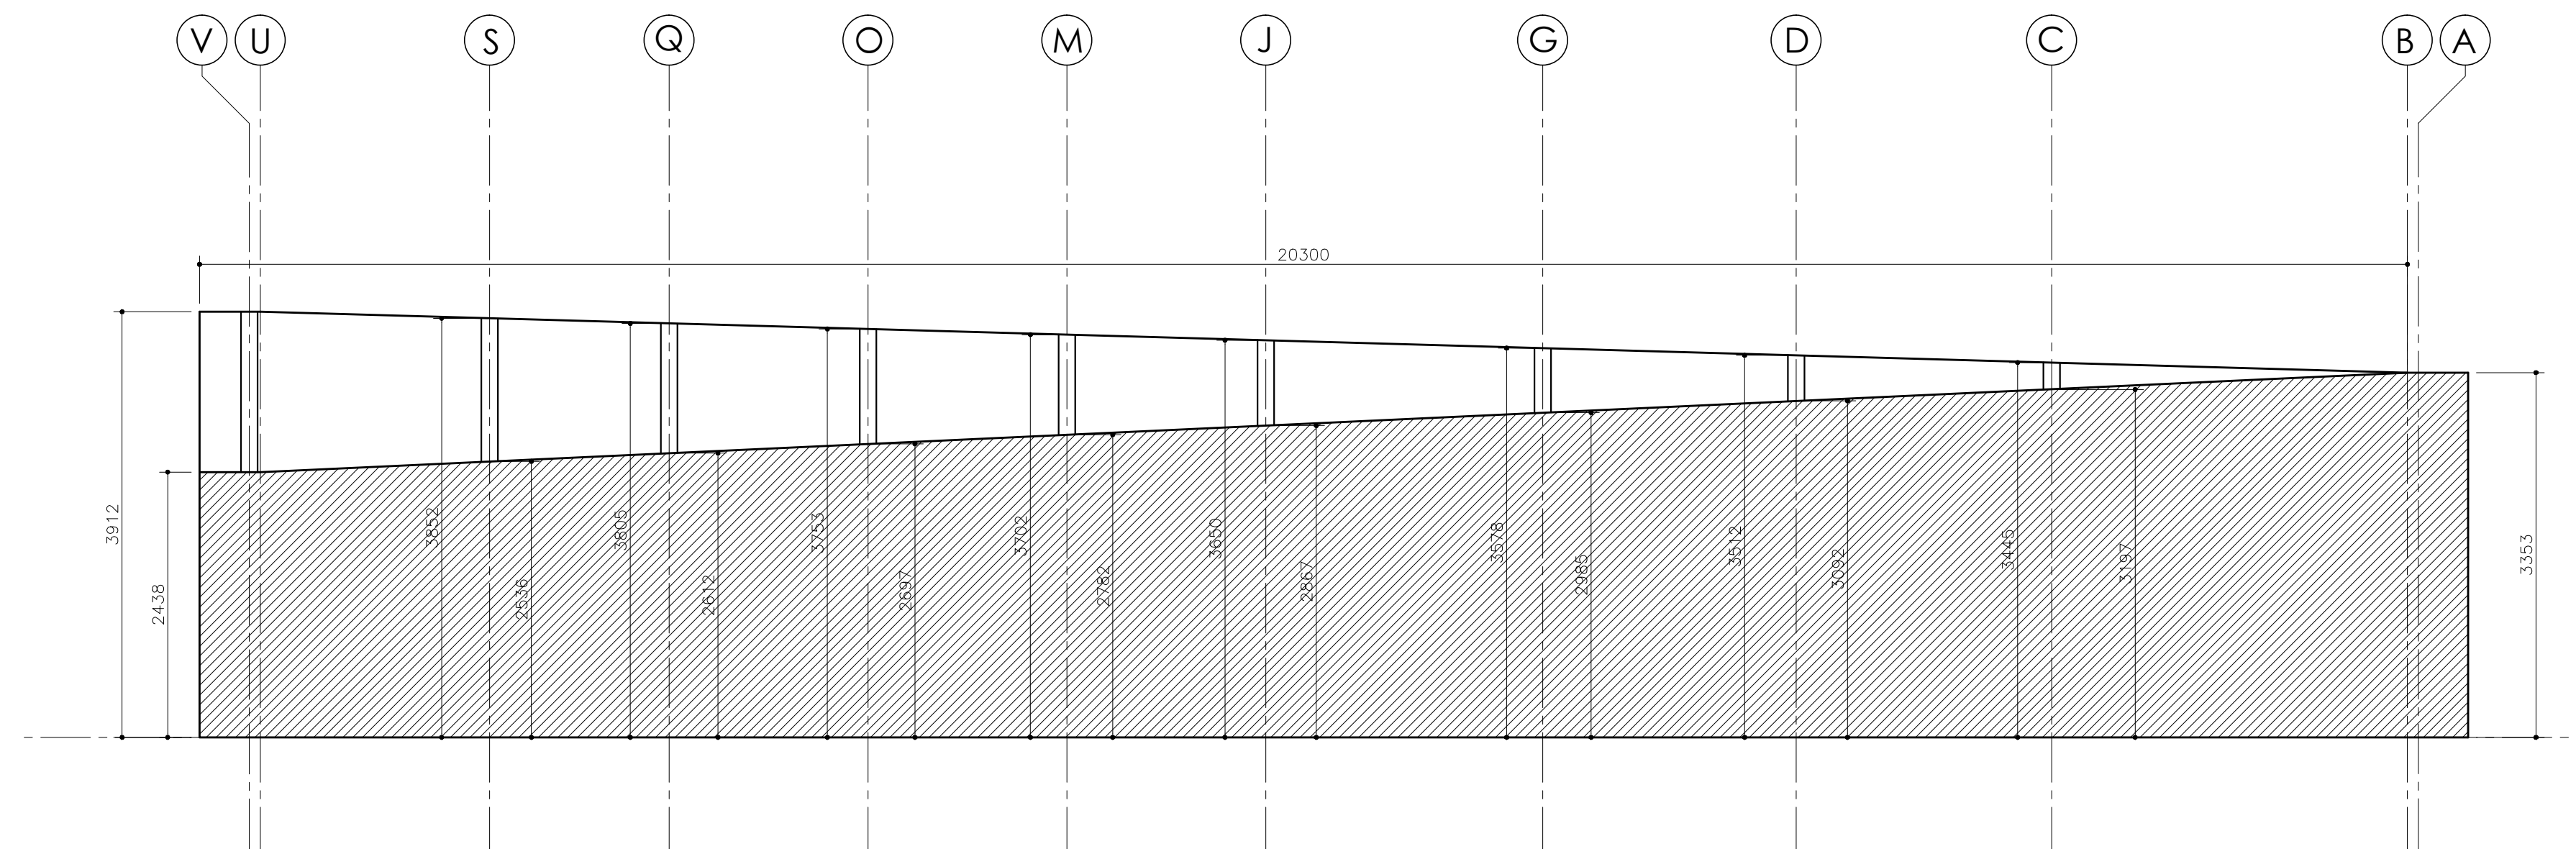

2 North Elevation - Wall & Column Dimensions
A8 Scale: 1:50

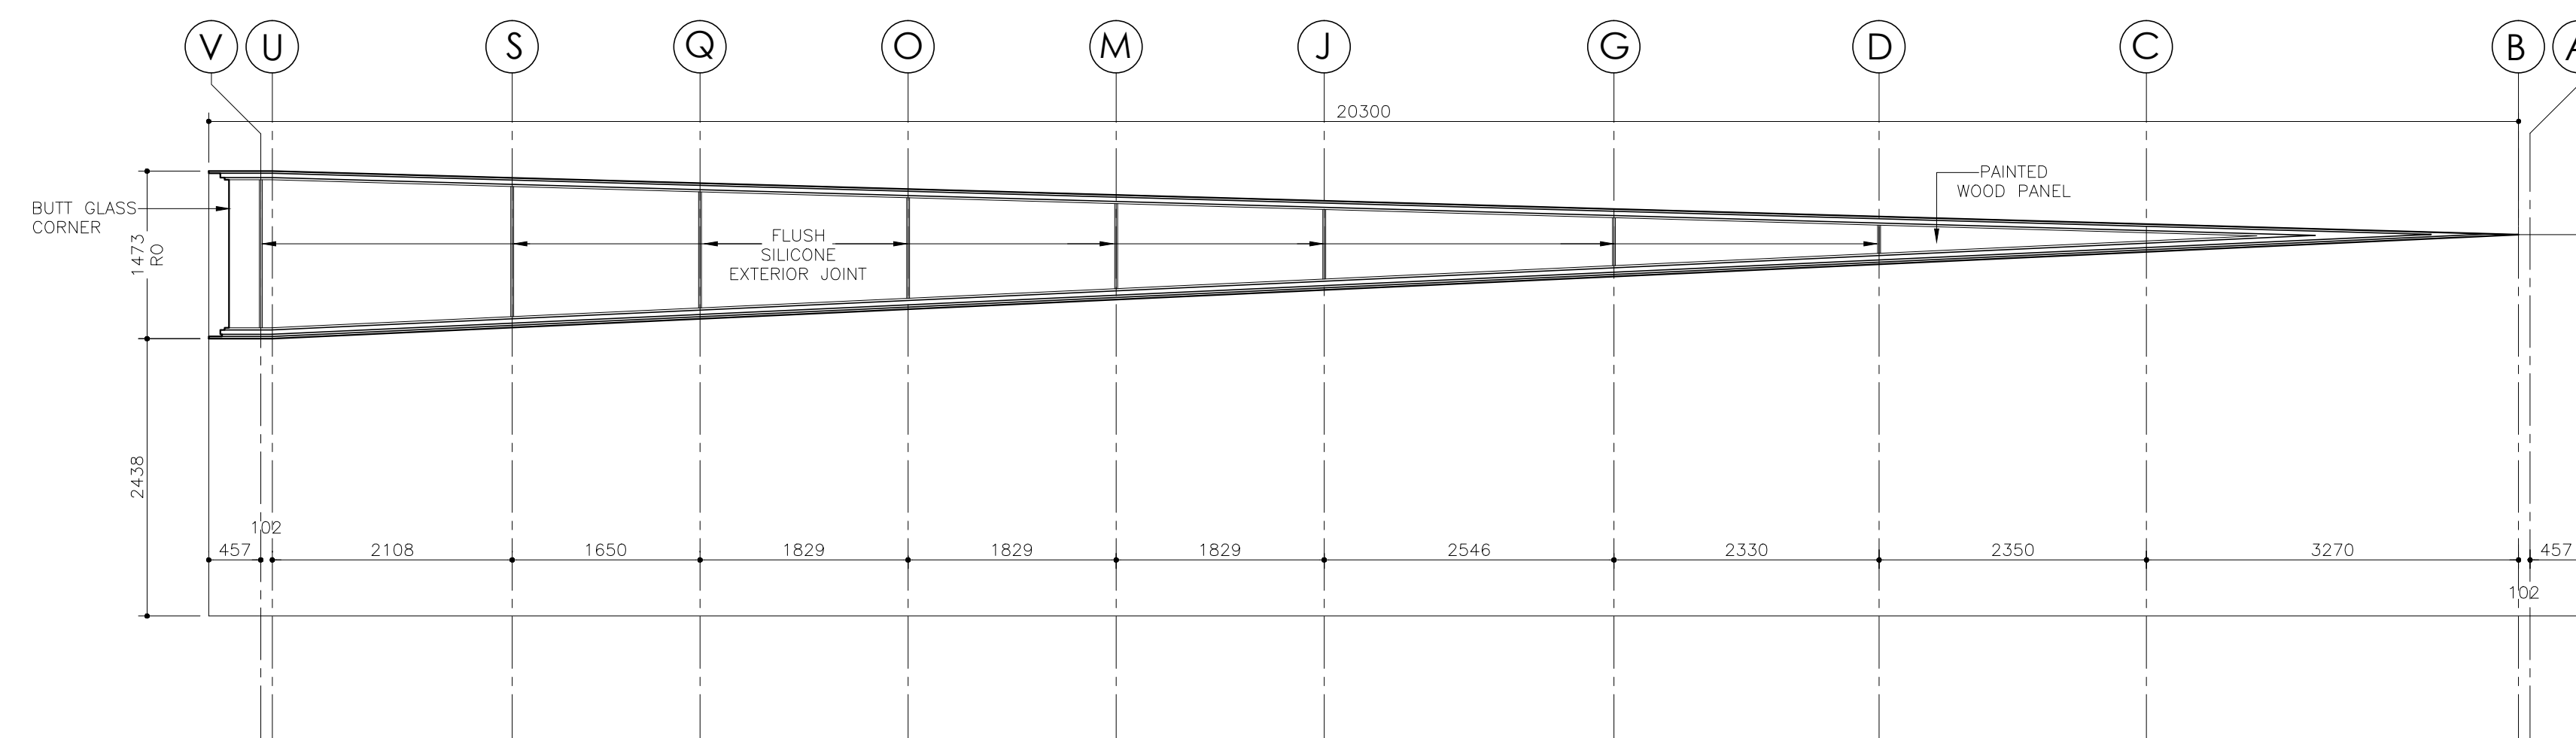

3 North Elevation - Windows & Doors
A8 Scale: 1:50

GENERAL NOTES:

1. THE GENERAL NOTES REFER TO ALL ARCHITECTURAL DRAWINGS.
2. DO NOT SCALE DRAWINGS.
3. SITE CHECK ALL DIMENSIONS PRIOR TO CONSTRUCTION.
4. NOTHING ON THESE DRAWINGS SUPERSEDES THE REGULATIONS OF THE GOVERNING CODES INCLUDING THE ONTARIO BUILDING CODE.
5. NOTIFY ARCHITECT OF ALL CONFLICTS AND DISCREPANCIES PRIOR TO CONSTRUCTION.
6. CONTRACTOR TO COORDINATE ARCHITECTURAL, STRUCTURAL, MECHANICAL, ELECTRICAL DRAWINGS BEFORE CONSTRUCTION AND NOTIFY ARCHITECT OF ANY DISCREPANCIES.
7. THESE DRAWINGS ARE NOT INTENDED TO SHOW CIVIL, STRUCTURAL, MECHANICAL OR ELECTRICAL INFORMATION.

5		
4		
3		
2	Issued for Tender & Permit	2017.05.12
1	Issued for 90% Review	2017.04.10
NO.	REVISION	DATE



516 HURON STREET, STRATFORD, ONTARIO N5A 5T7
TEL: 519 271 9230 FAX: 519 271 6560
www.marklevitz.com

THESE DRAWINGS ARE AN INSTRUMENT OF SERVICE AND ALL INFORMATION WITHIN IS THE SOLE PROPERTY AND COPYRIGHT OF MARKLEVITZ ARCHITECTS INC. REPRODUCTION OF THESE DOCUMENTS WITHOUT WRITTEN PERMISSION OF THE ARCHITECT AND CONSULTANTS IS STRICTLY PROHIBITED.


PROJECT
New Waste Management Administration Building

LOCATION
384060 Salford Road
Township of Oxford, Ontario


FOR
Oxford County

DRAWING
North Elevations


DRAWING NO.	A8
PROJ. No:	3153-16
DATE:	2017.05.12

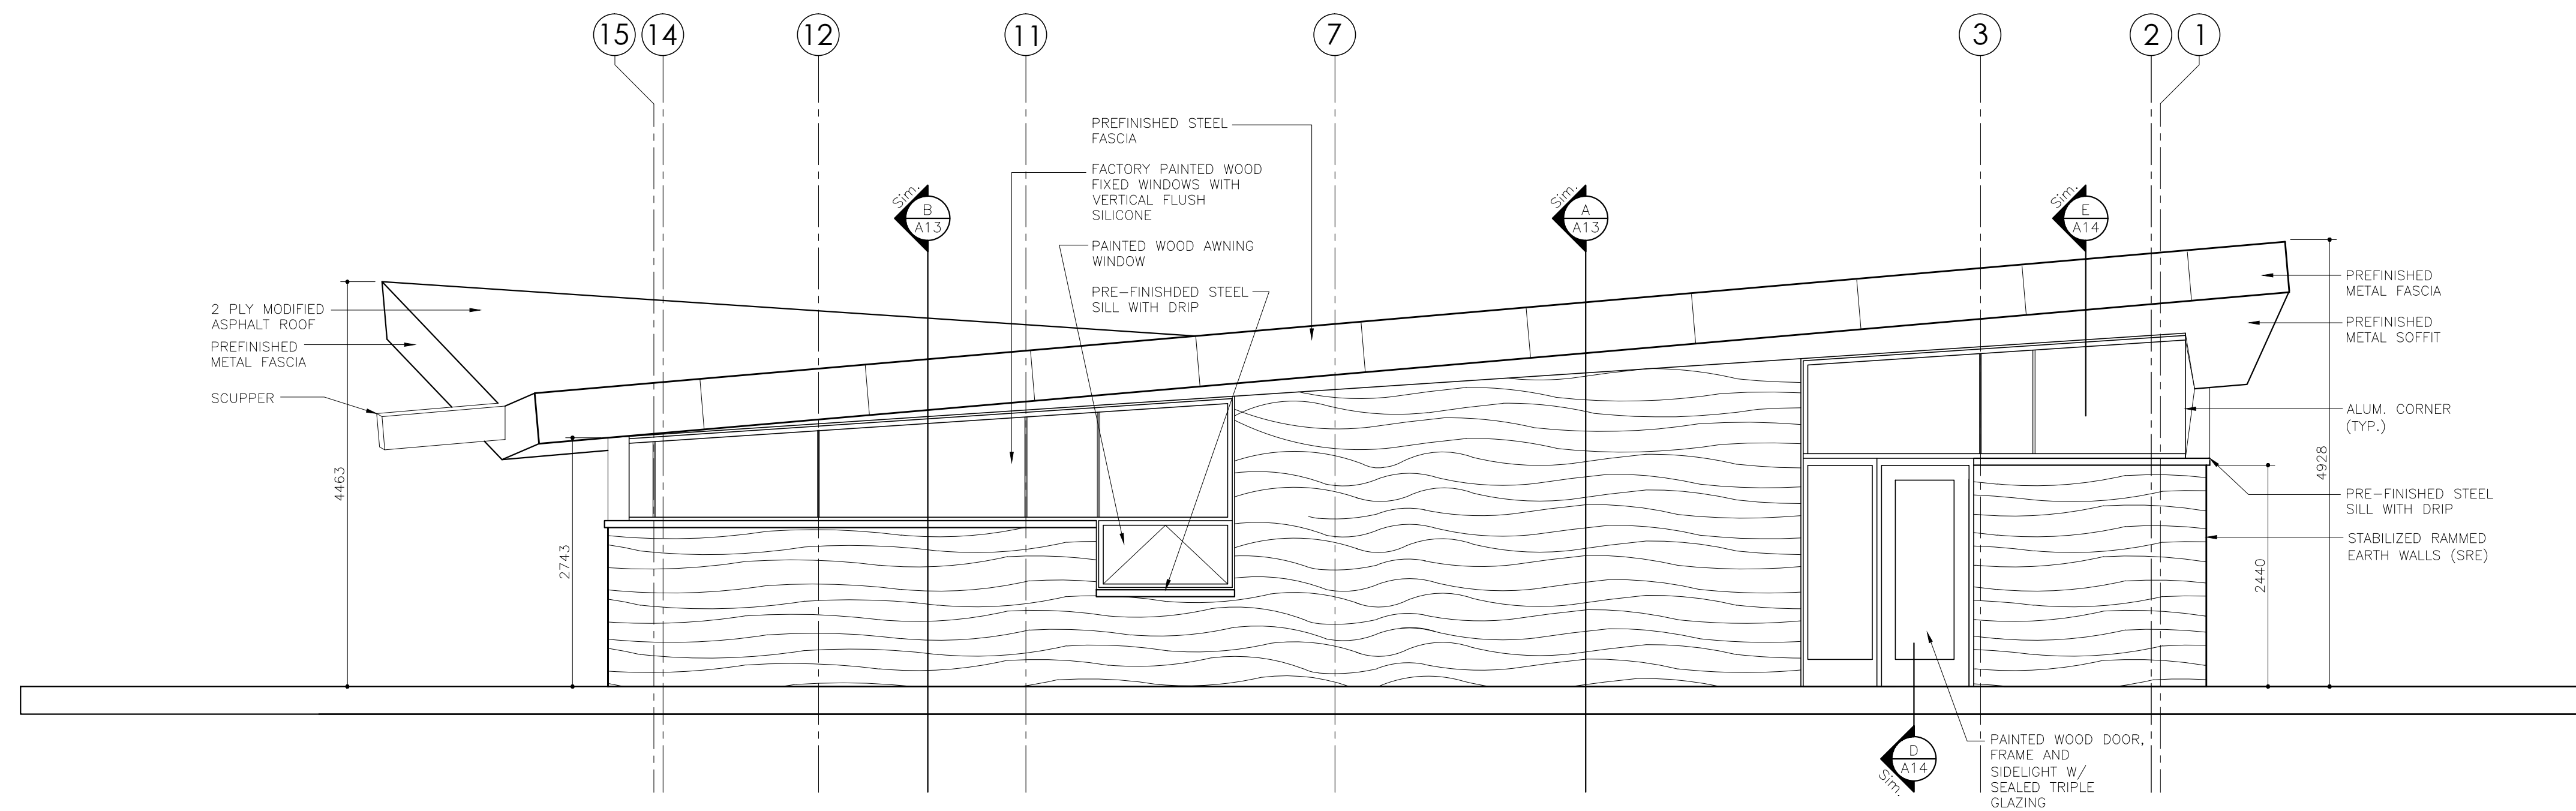

1 East Elevation
 A9 Scale 1:50

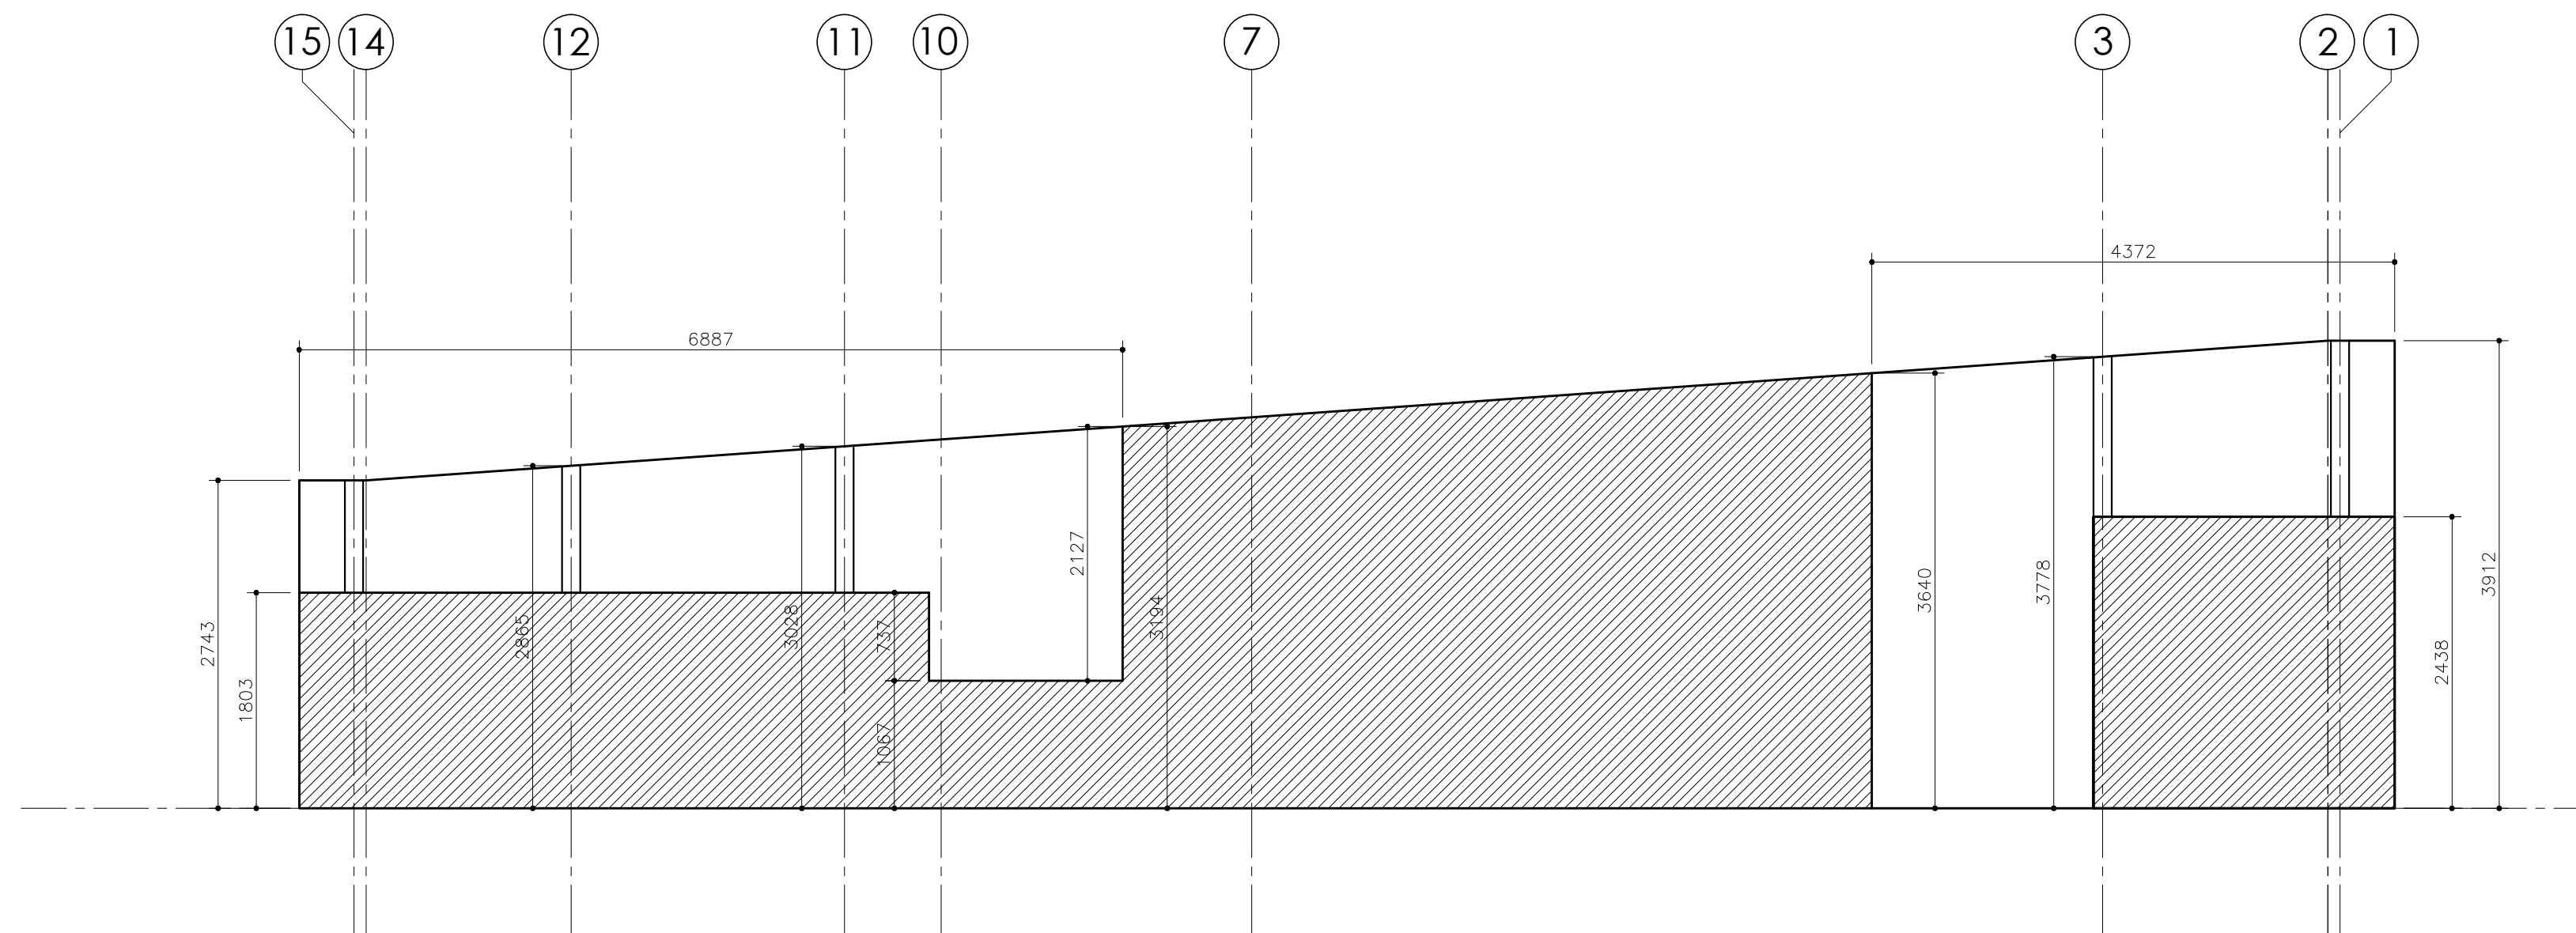

2 East Elevation - Wall & Column Dimensions
 A9 Scale 1:50

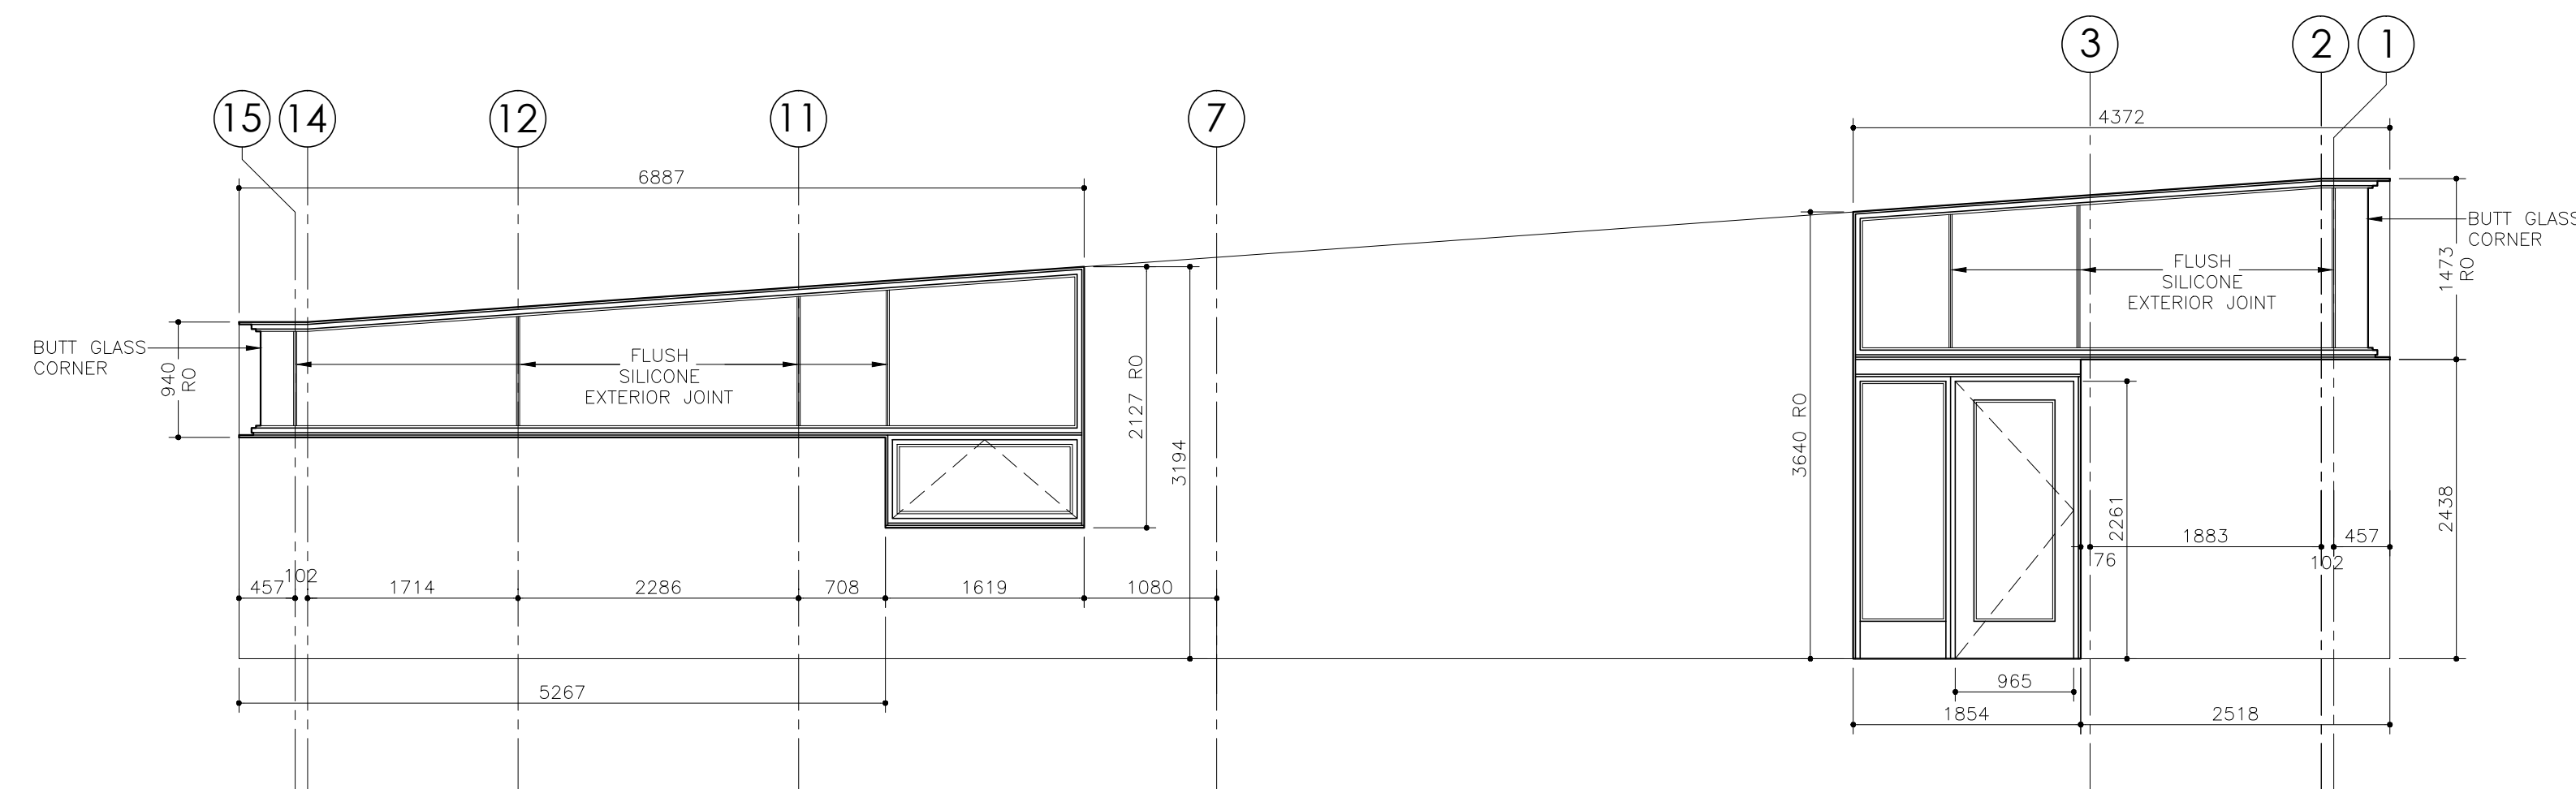

3 East Elevation - Windows & Doors
 A9 Scale 1:50

- GENERAL NOTES:**
1. THE GENERAL NOTES REFER TO ALL ARCHITECTURAL DRAWINGS.
 2. DO NOT SCALE DRAWINGS.
 3. SITE CHECK ALL DIMENSIONS PRIOR TO CONSTRUCTION.
 4. NOTHING ON THESE DRAWINGS SUPERSEDES THE REGULATIONS OF THE GOVERNING CODES INCLUDING THE ONTARIO BUILDING CODE.
 5. NOTIFY ARCHITECT OF ALL CONFLICTS AND DISCREPANCIES PRIOR TO CONSTRUCTION.
 6. CONTRACTOR TO COORDINATE ARCHITECTURAL, STRUCTURAL, MECHANICAL, ELECTRICAL DRAWINGS BEFORE CONSTRUCTION AND NOTIFY ARCHITECT OF ANY DISCREPANCIES.
 7. THESE DRAWINGS ARE NOT INTENDED TO SHOW CIVIL, STRUCTURAL, MECHANICAL OR ELECTRICAL INFORMATION.

5		
4		
3	AS-BUILT	2018.07.23
2	Issued for Tender & Permit	2017.05.12
1	Issued for 90% Review	2017.04.10
NO.	REVISION	DATE

M
 MARKLEVITZ
 ARCHITECTS
inc

516 HURON STREET, STRATFORD, ONTARIO N5A 5T7
 TEL: 519 271 9230 FAX: 519 271 6560
 www.marklevitz.com

THESE DRAWINGS ARE AN INSTRUMENT OF SERVICE AND ALL INFORMATION WITHIN IS THE SOLE PROPERTY AND COPYRIGHT OF MARKLEVITZ ARCHITECTS INC. REPRODUCTION OF THESE DOCUMENTS WITHOUT WRITTEN PERMISSION OF THE ARCHITECT AND CONSULTANTS IS STRICTLY PROHIBITED.

PROJECT
 New Waste Management Administration Building

LOCATION
 384060 Salford Road
 Township of Oxford, Ontario

FOR
 Oxford County


DRAWING
 East Elevations

DRAWING NO.
A9


PROJ. No:
 3153-16

DATE:
 2017.05.12


3153-16 Oxford County Waste Management Building Working Drawings.dwg

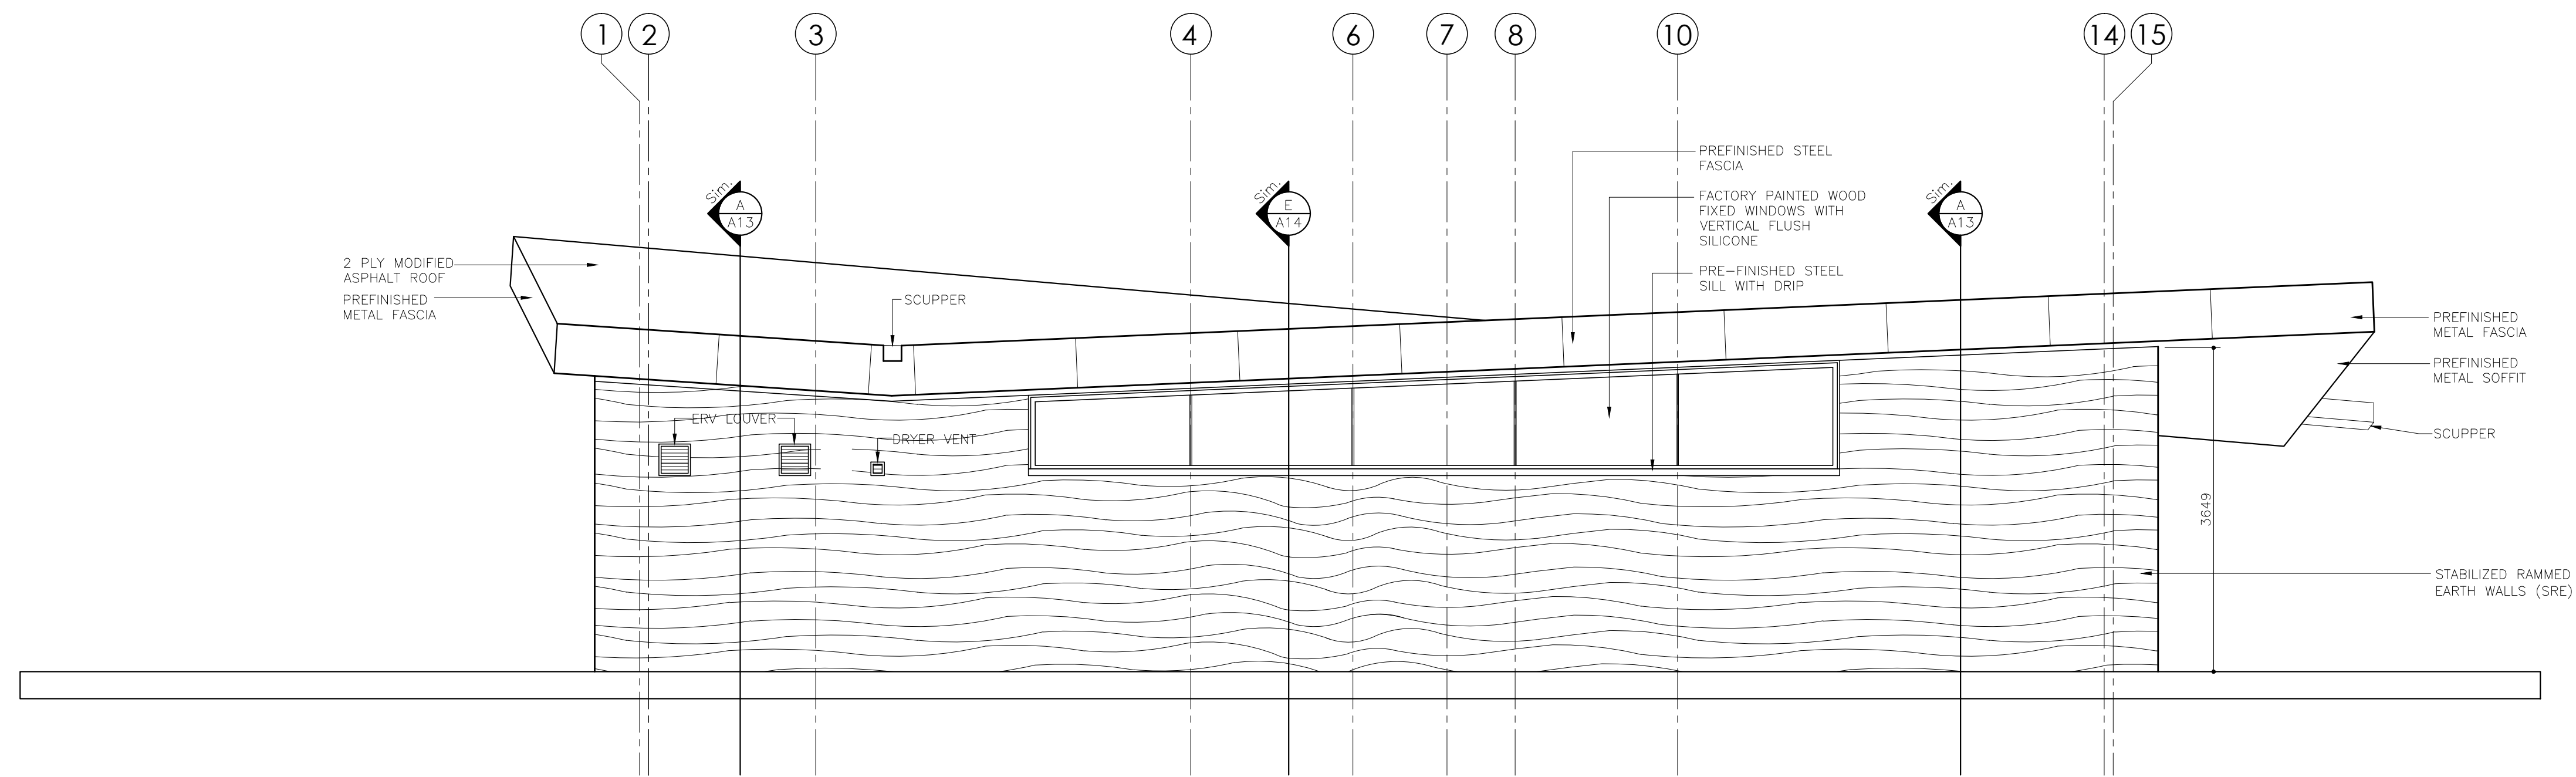

1 West Elevation
A10 Scale 1:50

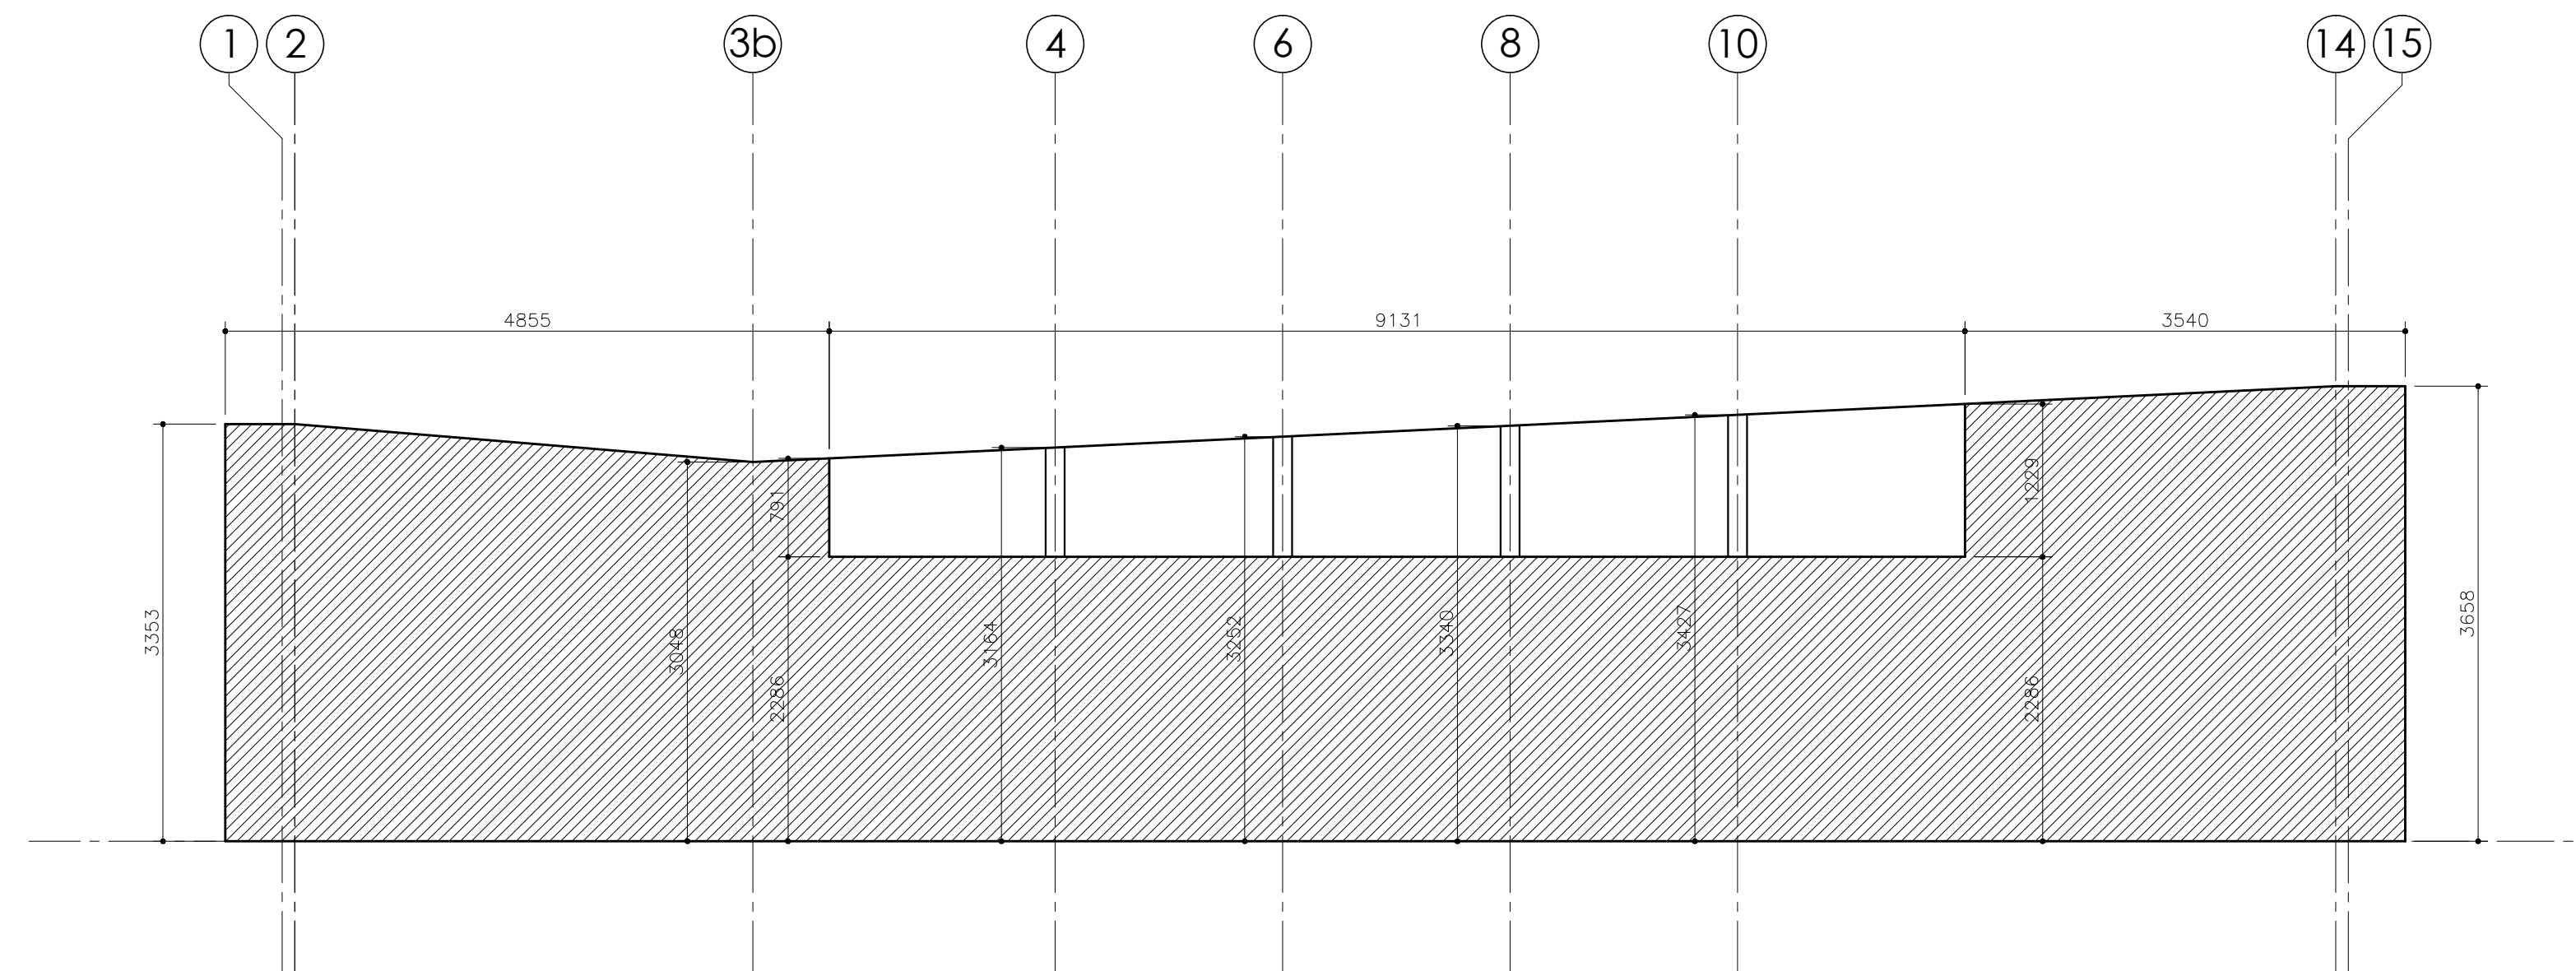

2 West Elevation - Wall & Column Dimensions
A10 Scale 1:50

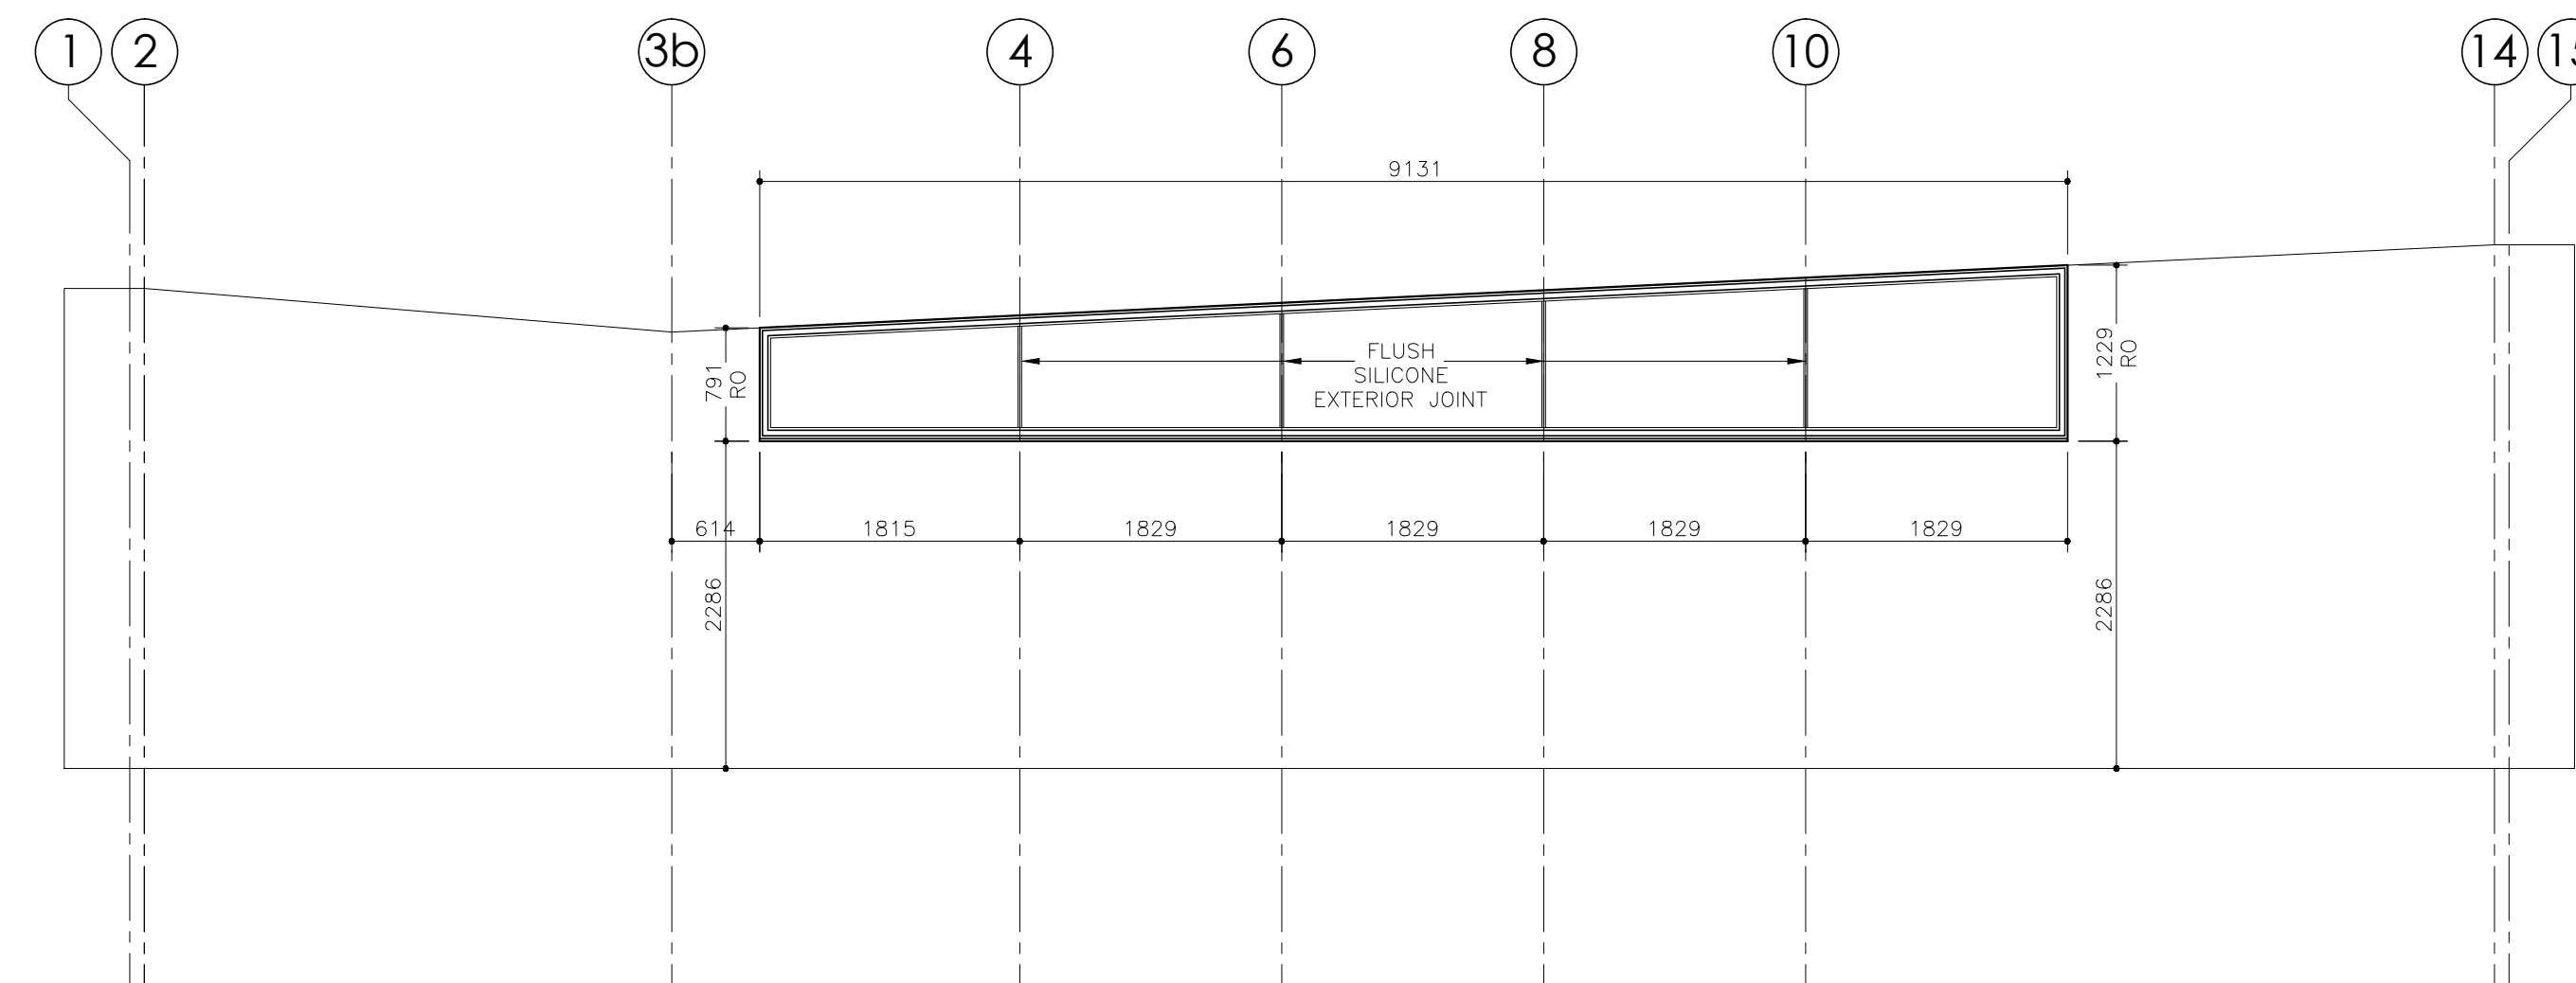

3 West Elevation - Windows & Doors
A10 Scale 1:50

GENERAL NOTES:

1. THE GENERAL NOTES REFER TO ALL ARCHITECTURAL DRAWINGS.
2. DO NOT SCALE DRAWINGS.
3. SITE CHECK ALL DIMENSIONS PRIOR TO CONSTRUCTION.
4. NOTHING ON THESE DRAWINGS SUPERSEDES THE REGULATIONS OF THE GOVERNING CODES INCLUDING THE ONTARIO BUILDING CODE.
5. NOTIFY ARCHITECT OF ALL CONFLICTS AND DISCREPANCIES PRIOR TO CONSTRUCTION.
6. CONTRACTOR TO COORDINATE ARCHITECTURAL, STRUCTURAL, MECHANICAL, ELECTRICAL DRAWINGS BEFORE CONSTRUCTION AND NOTIFY ARCHITECT OF ANY DISCREPANCIES.
7. THESE DRAWINGS ARE NOT INTENDED TO SHOW CIVIL, STRUCTURAL, MECHANICAL OR ELECTRICAL INFORMATION.

5		
4		
3	AS-BUILT	2018.07.23
2	Issued for Tender & Permit	2017.05.12
1	Issued for 90% Review	2017.04.10
NO.	REVISION	DATE



516 HURON STREET, STRATFORD, ONTARIO N5A 5T7
TEL: 519 271 9230 FAX: 519 271 6560
www.marklevitz.com

THESE DRAWINGS ARE AN INSTRUMENT OF SERVICE AND ALL INFORMATION WITHIN IS THE SOLE PROPERTY AND COPYRIGHT OF MARKLEVITZ ARCHITECTS INC. REPRODUCTION OF THESE DOCUMENTS WITHOUT WRITTEN PERMISSION OF THE ARCHITECT AND CONSULTANTS IS STRICTLY PROHIBITED.


PROJECT
New Waste Management Administration Building

LOCATION
384060 Salford Road
Township of Oxford, Ontario


FOR
Oxford County

DRAWING
West Elevations

DRAWING NO.	A10
PROJ. No:	3153-16
DATE:	2017.05.12

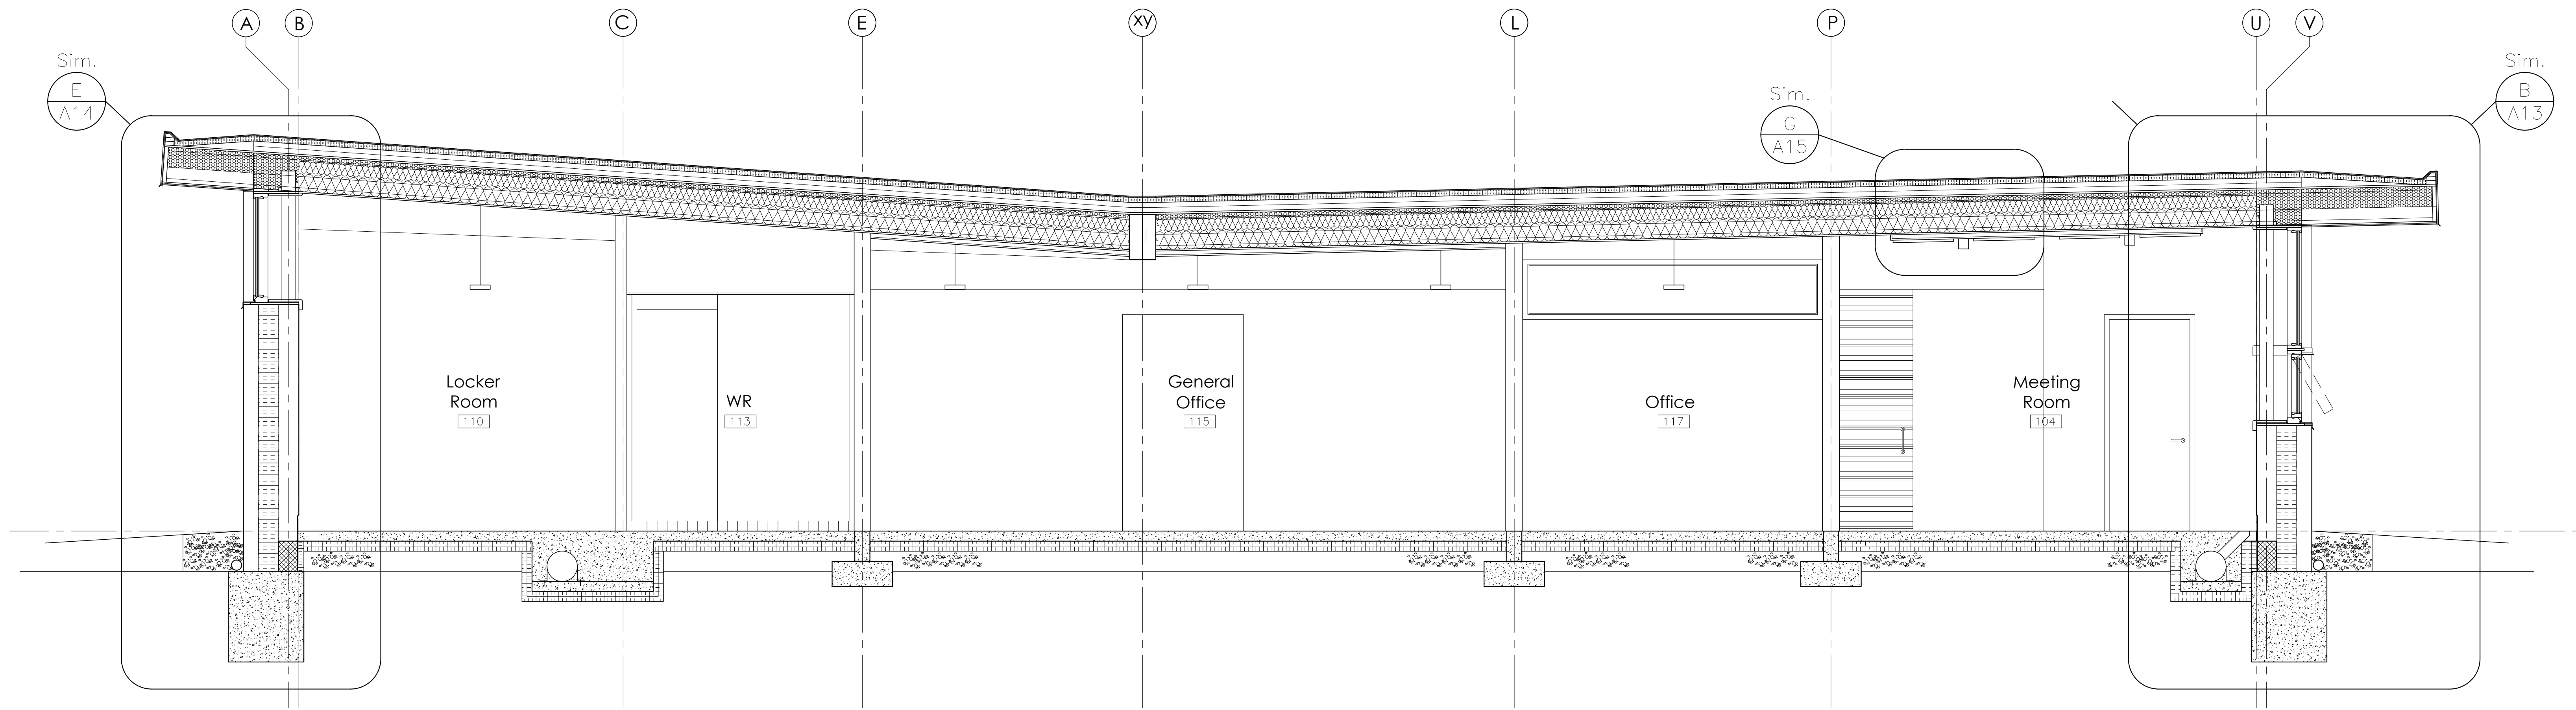

AA Building Section
A11 Scale 1:30

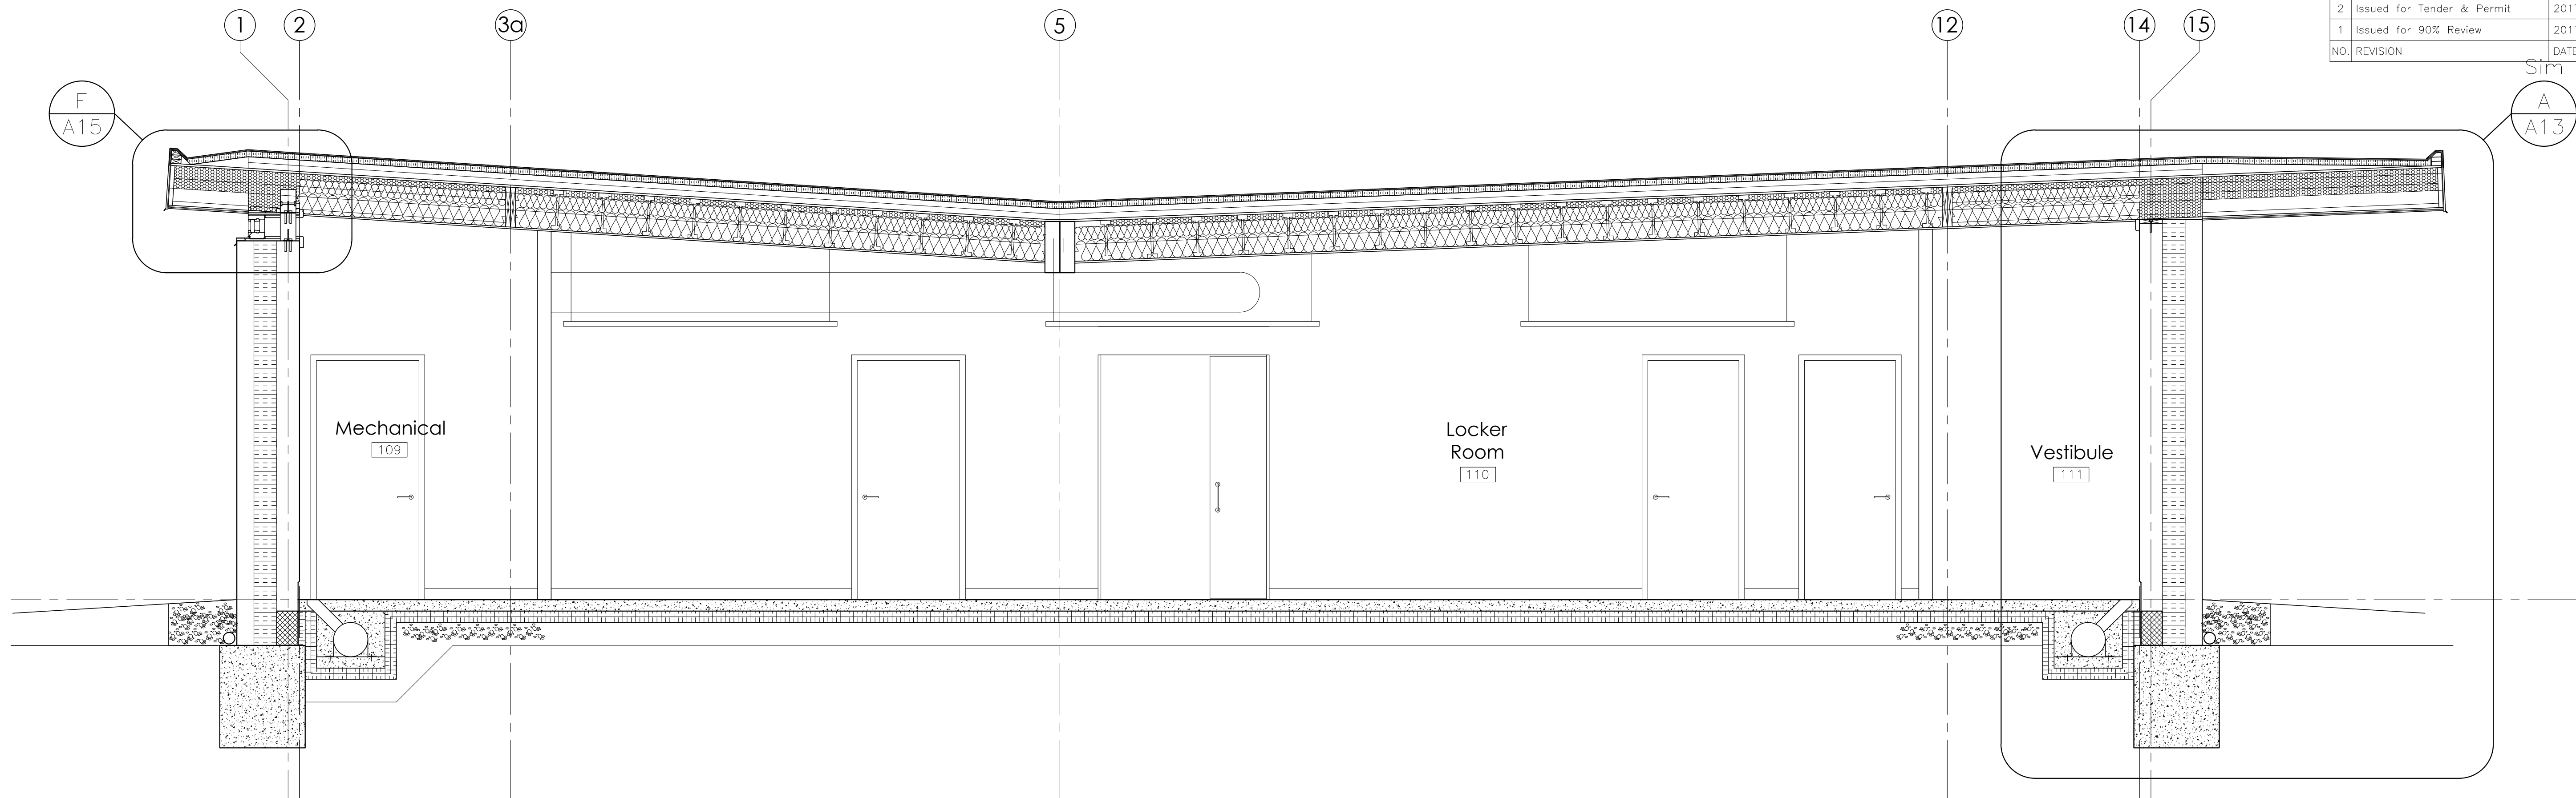

BB Building Section
A11 Scale 1:30

5		
4		
3	AS-BUILT	2018.07.23
2	Issued for Tender & Permit	2017.05.12
1	Issued for 90% Review	2017.04.10
NO.	REVISION	DATE

Sim
A
A13



516 HURON STREET, STRATFORD, ONTARIO N5A 5T7
TEL: 519 271 9230 FAX: 519 271 6560
www.marklevitz.com

THESE DRAWINGS ARE AN INSTRUMENT OF SERVICE AND ALL INFORMATION WITHIN IS THE SOLE PROPERTY AND COPYRIGHT OF MARKLEVITZ ARCHITECTS INC. REPRODUCTION OF THESE DOCUMENTS WITHOUT WRITTEN PERMISSION OF THE ARCHITECT AND CONSULTANTS IS STRICTLY PROHIBITED.


PROJECT
New Waste Management Administration Building

LOCATION
384060 Salford Road
Township of Oxford, Ontario

FOR
Oxford County

DRAWING
Building Sections

DRAWING NO.	A11
PROJ. No:	3153-16
DATE:	2017.05.12

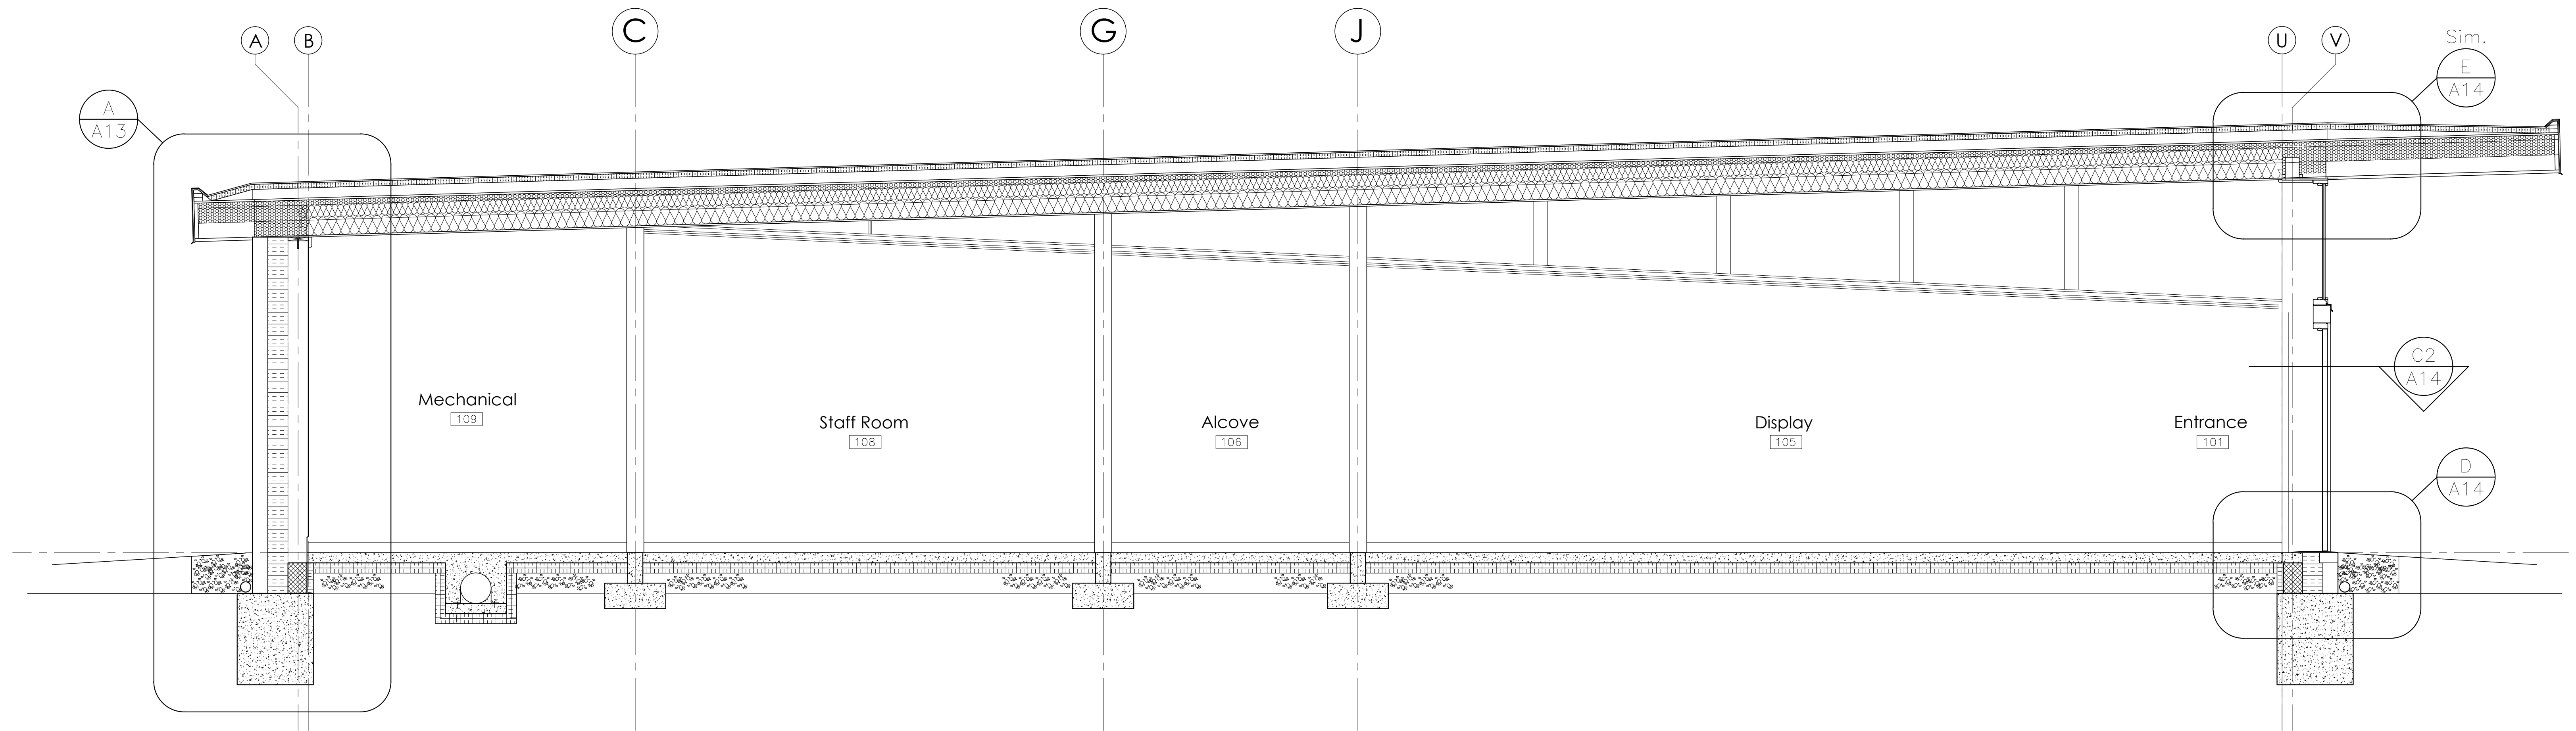

CC Building Section
A12 Scale 1:30

5		
4		
3	AS-BUILT	2018.07.23
2	Issued for Tender & Permit	2017.05.12
1	Issued for 90% Review	2017.04.10
NO.	REVISION	DATE

M

MARKLEVITZ ARCHITECTS
inc

516 HURON STREET, STRATFORD, ONTARIO N5A 5T7
TEL: 519 271 9230 FAX: 519 271 6560
www.marklevitz.com

THESE DRAWINGS ARE AN INSTRUMENT OF SERVICE AND ALL INFORMATION WITHIN IS THE SOLE PROPERTY AND COPYRIGHT OF MARKLEVITZ ARCHITECTS INC. REPRODUCTION OF THESE DOCUMENTS WITHOUT WRITTEN PERMISSION OF THE ARCHITECT AND CONSULTANTS IS STRICTLY PROHIBITED.

PROJECT
New Waste Management Administration Building


LOCATION
384060 Salford Road
Township of Oxford, Ontario

FOR
Oxford County


DRAWING
Building Sections

	DRAWING NO. A12
	PROJ. No: 3153-16
	DATE: 2017.05.12

3153-16 Oxford County Waste Management Building Working Drawings.dwg

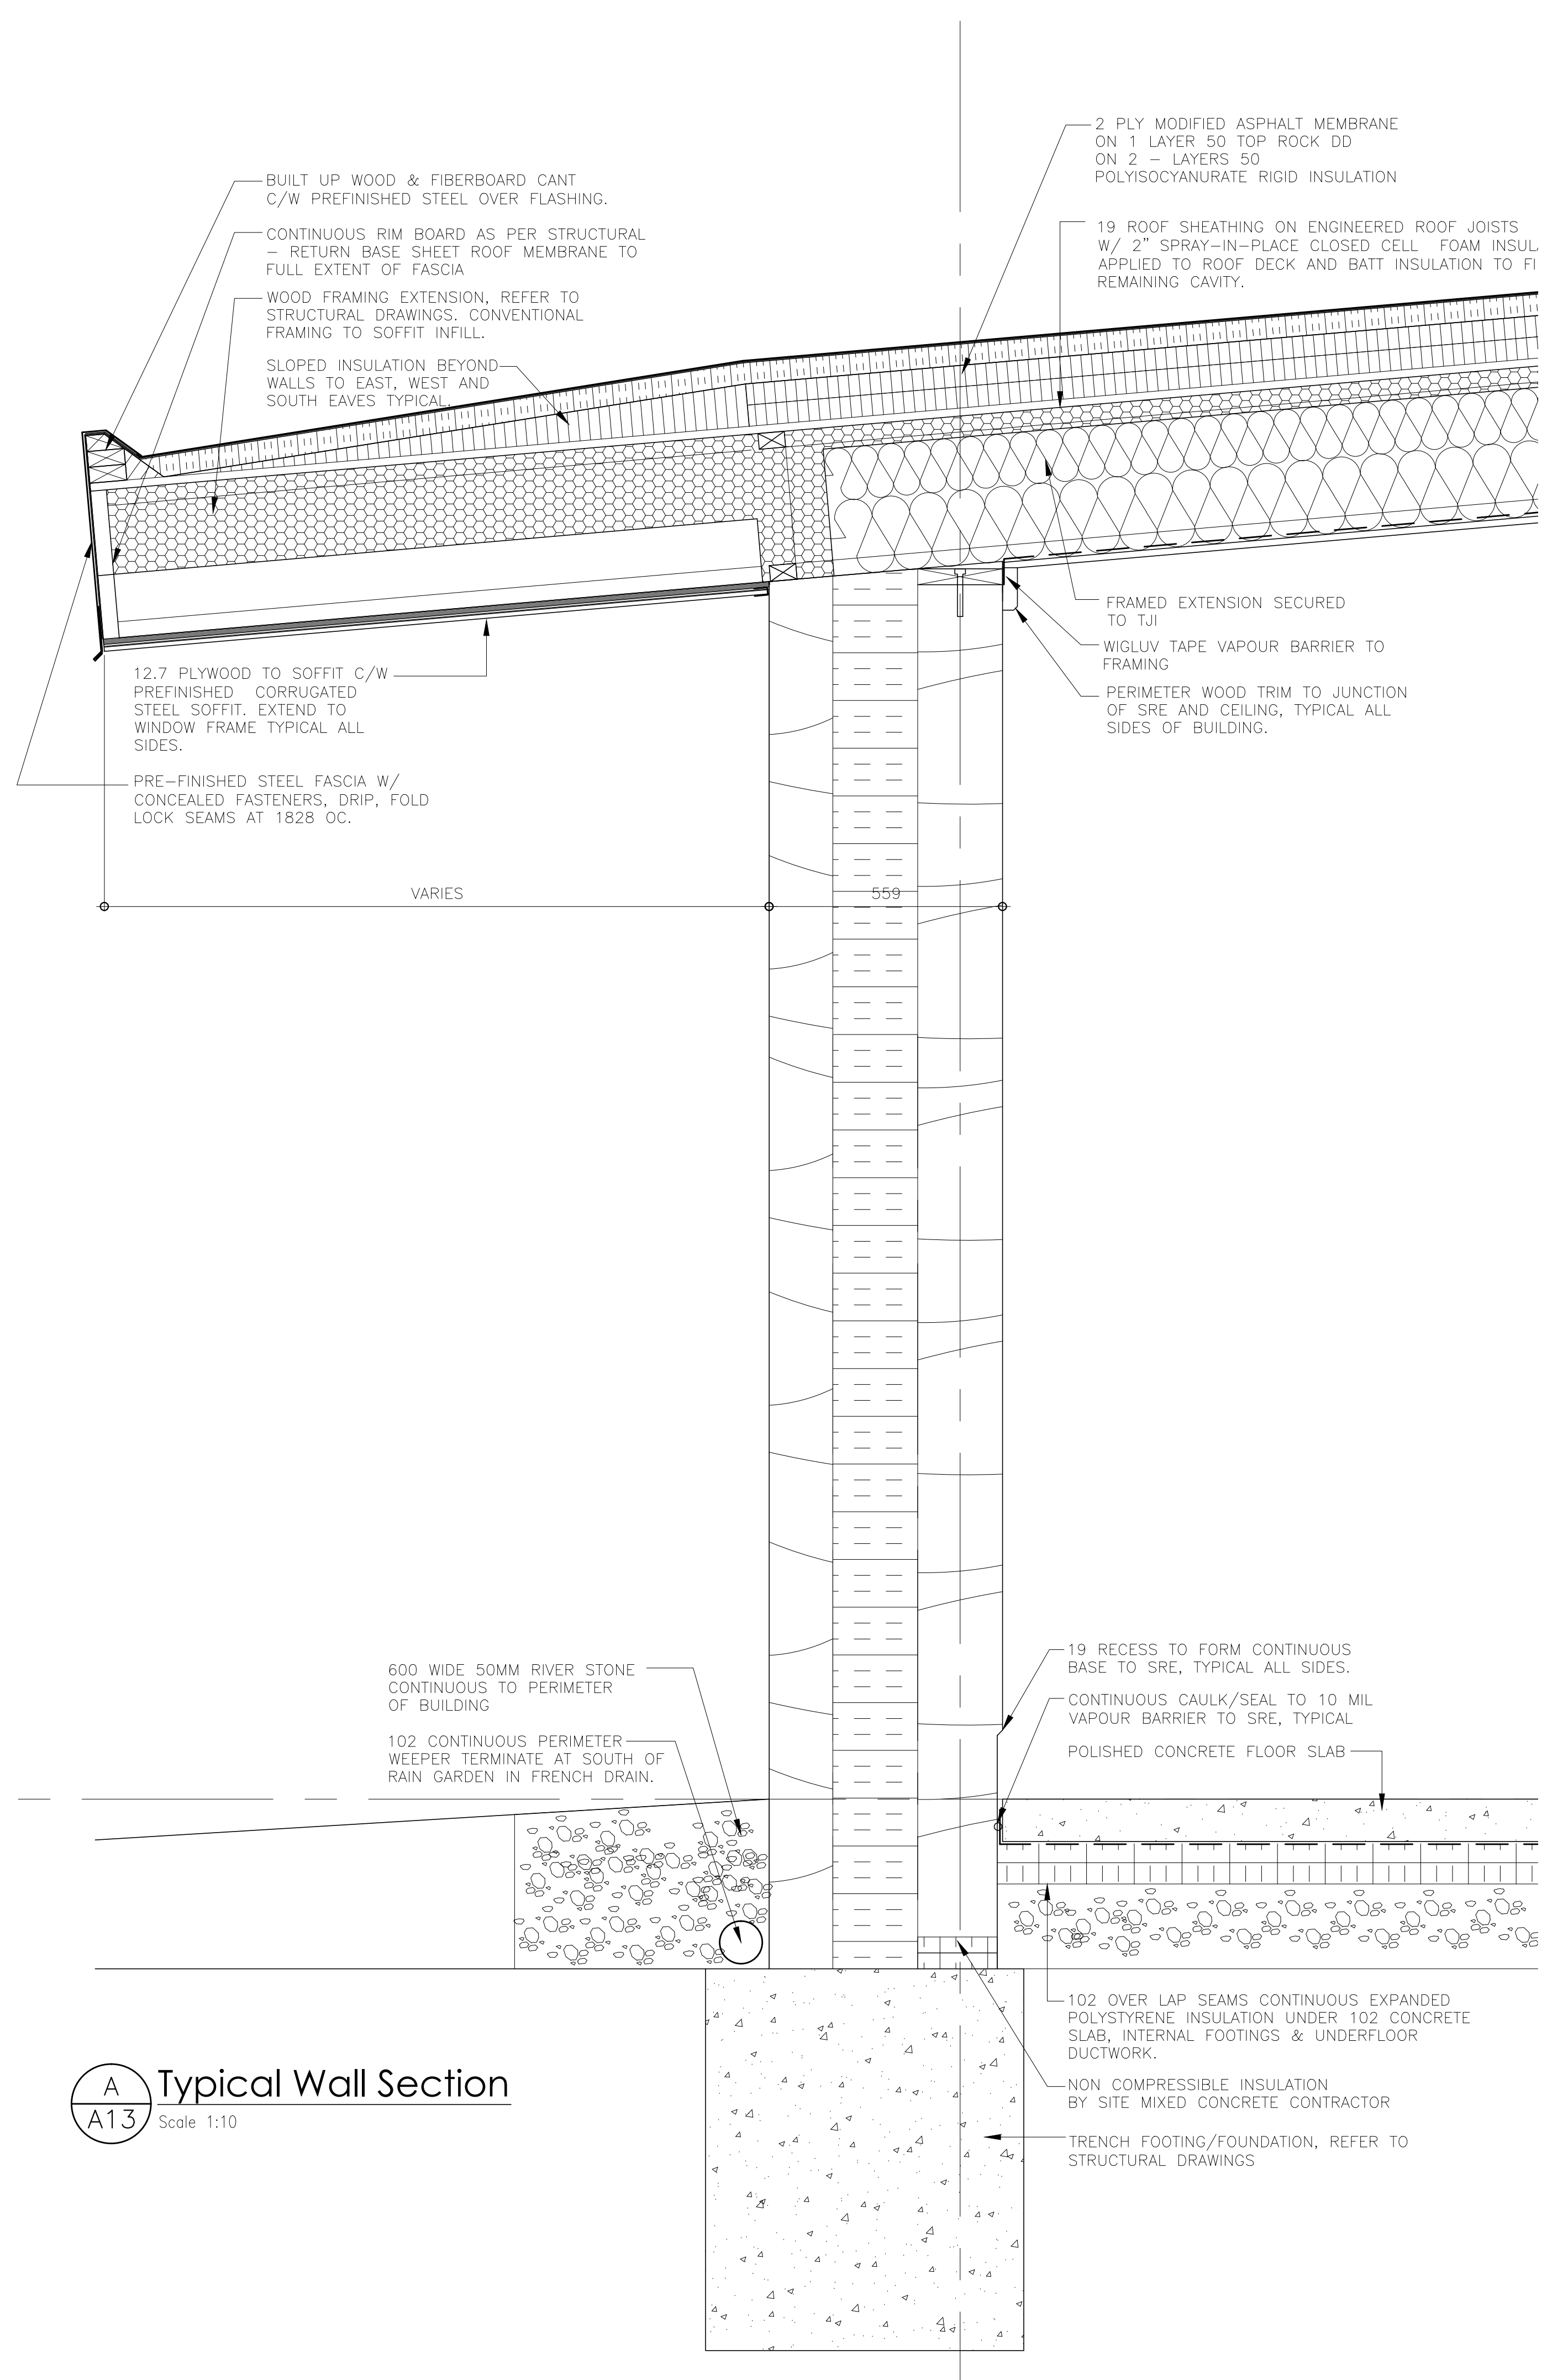

A Typical Wall Section
A13 Scale 1:10

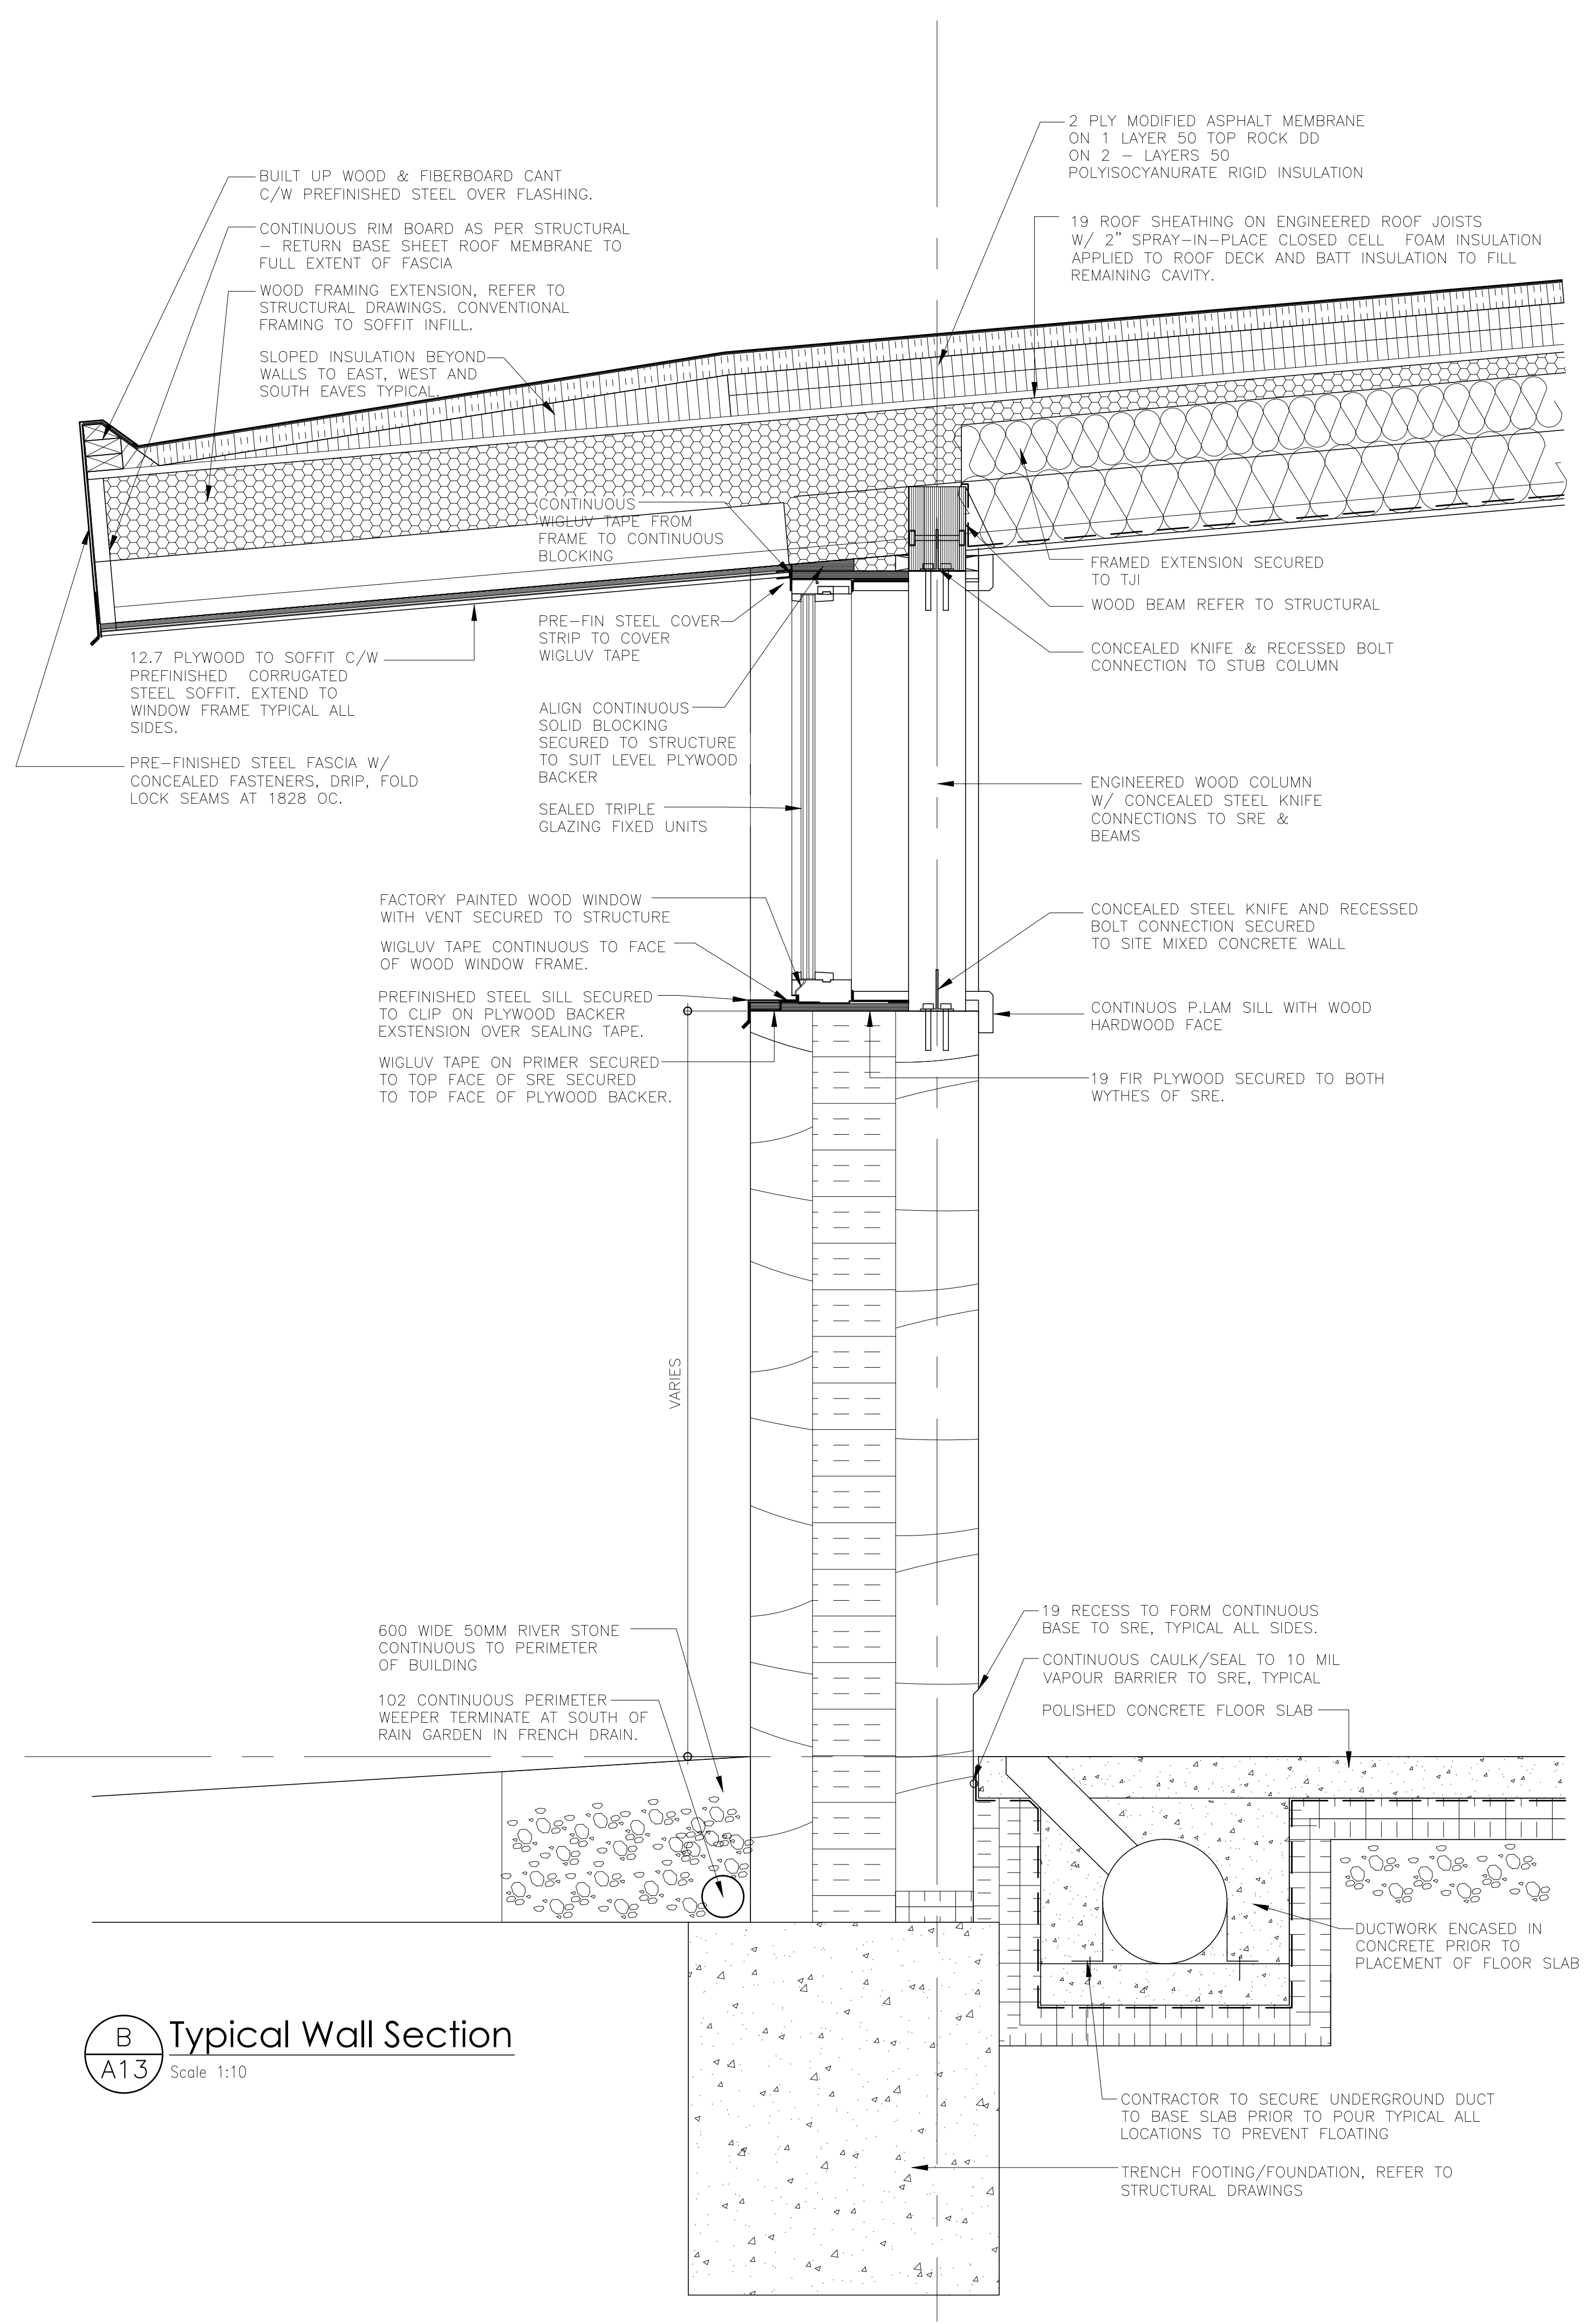

B Typical Wall Section
A13 Scale 1:10

- GENERAL NOTES:**
1. THE GENERAL NOTES REFER TO ALL ARCHITECTURAL DRAWINGS.
 2. DO NOT SCALE DRAWINGS.
 3. SITE CHECK ALL DIMENSIONS PRIOR TO CONSTRUCTION.
 4. NOTHING ON THESE DRAWINGS SUPERSEDES THE REGULATIONS OF THE GOVERNING CODES INCLUDING THE ONTARIO BUILDING CODE.
 5. NOTIFY ARCHITECT OF ALL CONFLICTS AND DISCREPANCIES PRIOR TO CONSTRUCTION.
 6. CONTRACTOR TO COORDINATE ARCHITECTURAL, STRUCTURAL, MECHANICAL, ELECTRICAL DRAWINGS BEFORE CONSTRUCTION AND NOTIFY ARCHITECT OF ANY DISCREPANCIES.
 7. THESE DRAWINGS ARE NOT INTENDED TO SHOW CIVIL, STRUCTURAL, MECHANICAL OR ELECTRICAL INFORMATION.


5		
4		
3		
2	Issued for Tender & Permit	2017.05.12
1	Issued for 90% Review	2017.04.10
NO.	REVISION	DATE

M
MARKLEVITZ ARCHITECTS
inc


516 HURON STREET, STRATFORD, ONTARIO N5A 5T7
TEL: 519 271 9230 FAX: 519 271 6560
www.marklevitz.com

THESE DRAWINGS ARE AN INSTRUMENT OF SERVICE AND ALL INFORMATION WITHIN IS THE SOLE PROPERTY AND COPYRIGHT OF MARKLEVITZ ARCHITECTS INC. REPRODUCTION OF THESE DOCUMENTS WITHOUT WRITTEN PERMISSION OF THE ARCHITECT AND CONSULTANTS IS STRICTLY PROHIBITED.


PROJECT	New Waste Management Administration Building
LOCATION	384060 Salford Road Township of Oxford, Ontario
FOR	Oxford County
DRAWING	Typical Wall Sections & Details
DRAWING NO.	A13
PROJ. No:	3153-16
DATE:	2017.05.12

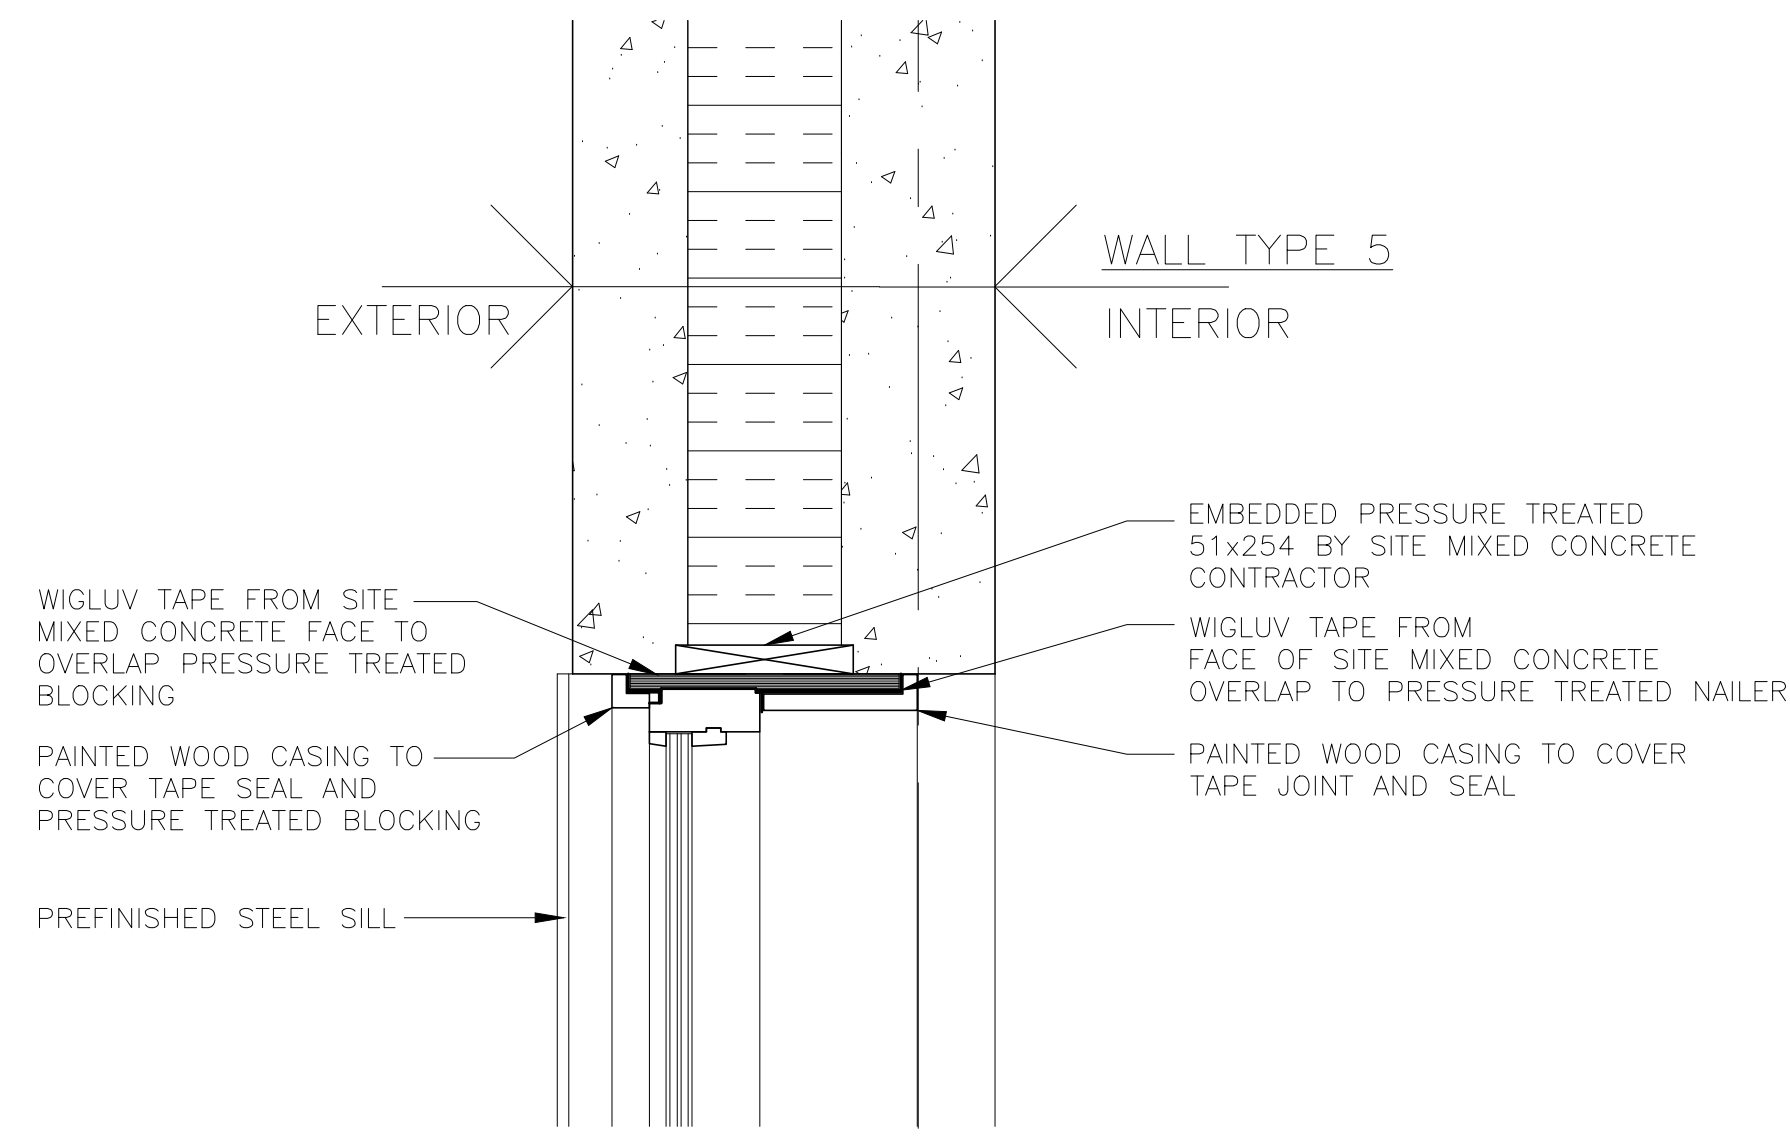


C1 Typical Window Jamb
A14 Scale 1:10

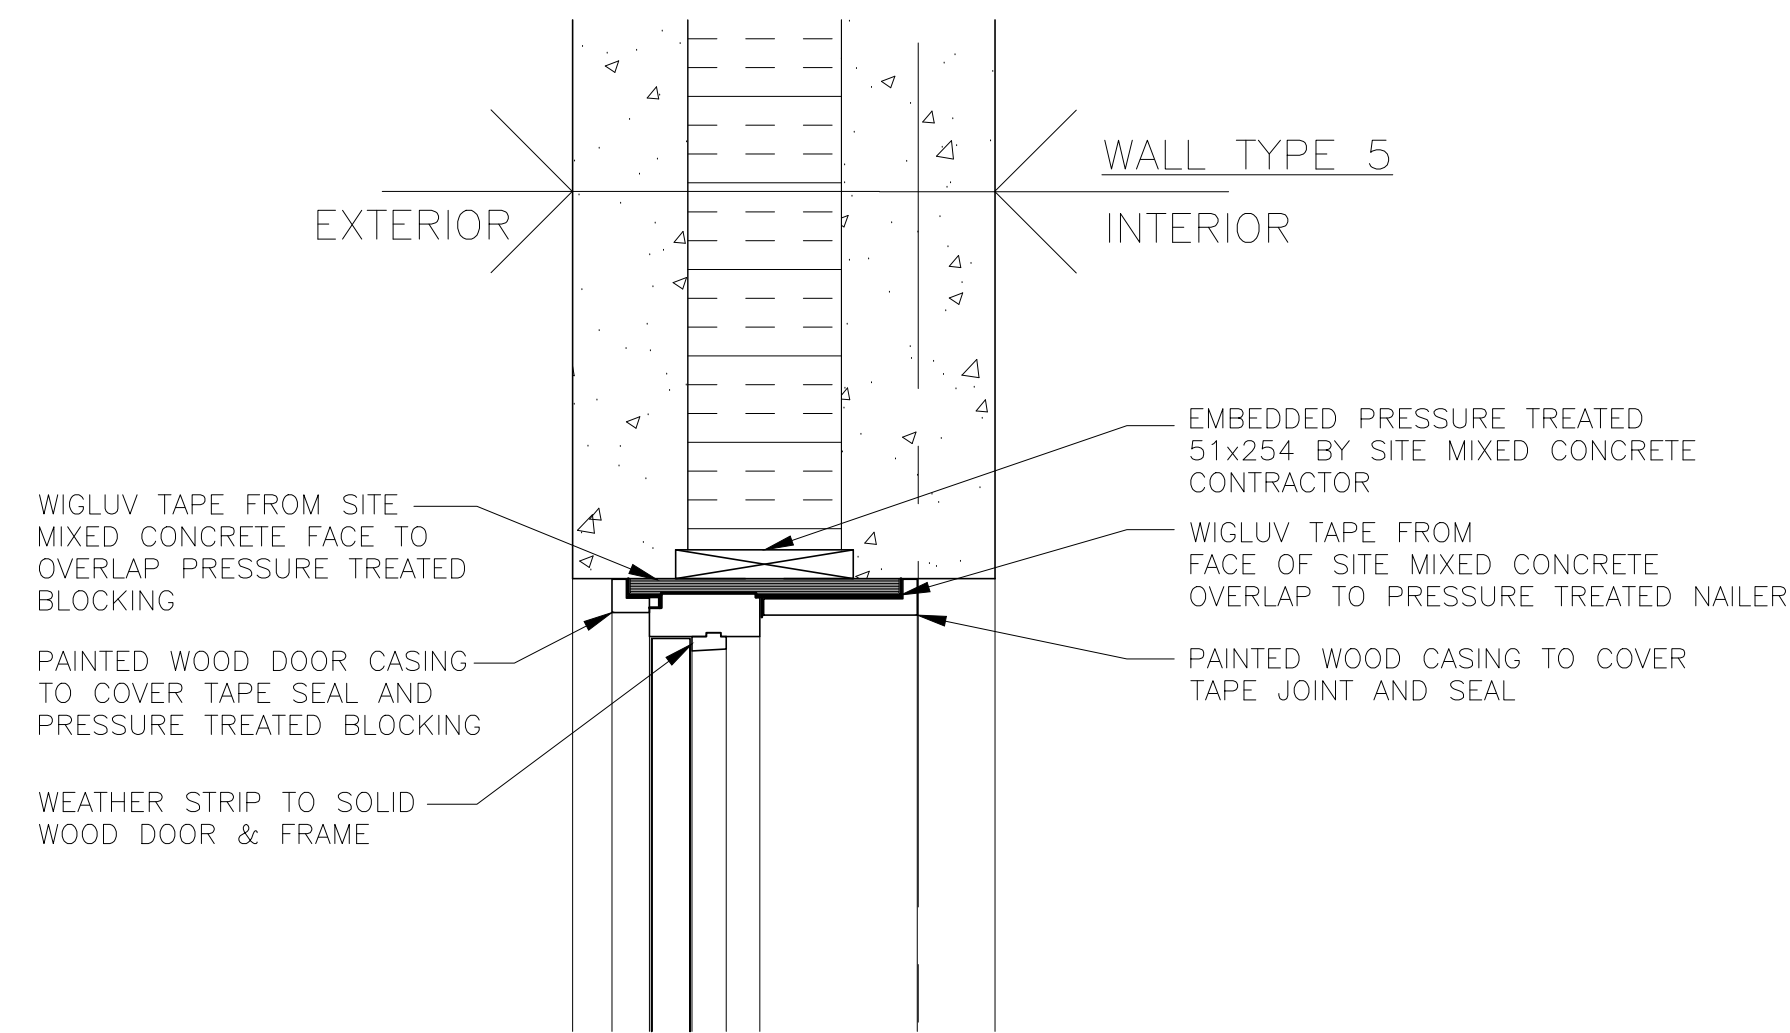

C2 Typical Door Jamb
A14 Scale 1:10

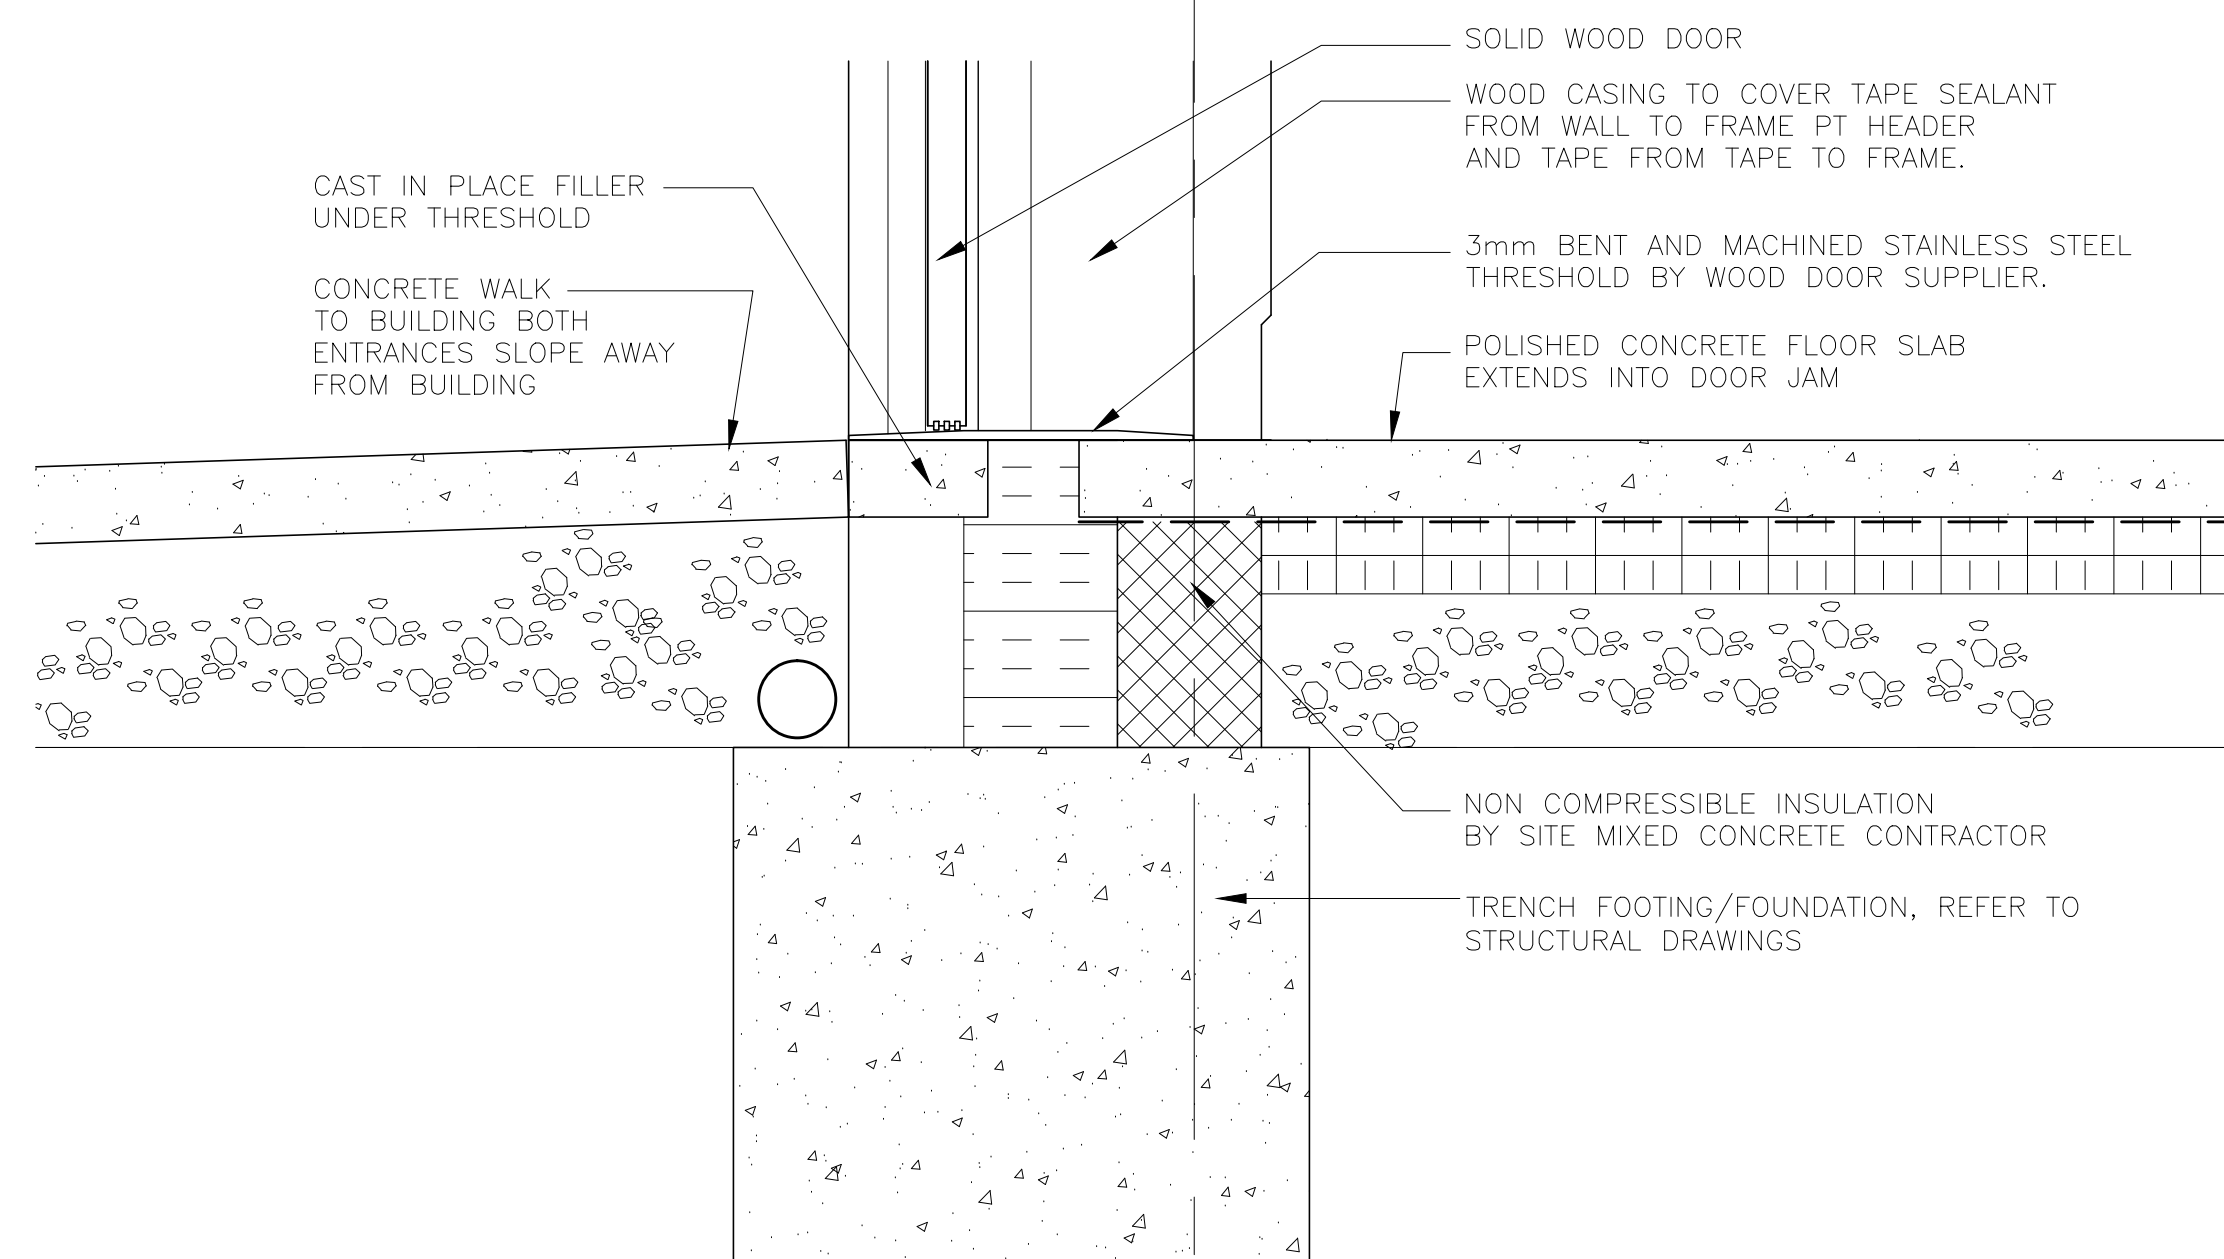

D Typical Door Sill
A14 Scale 1:10

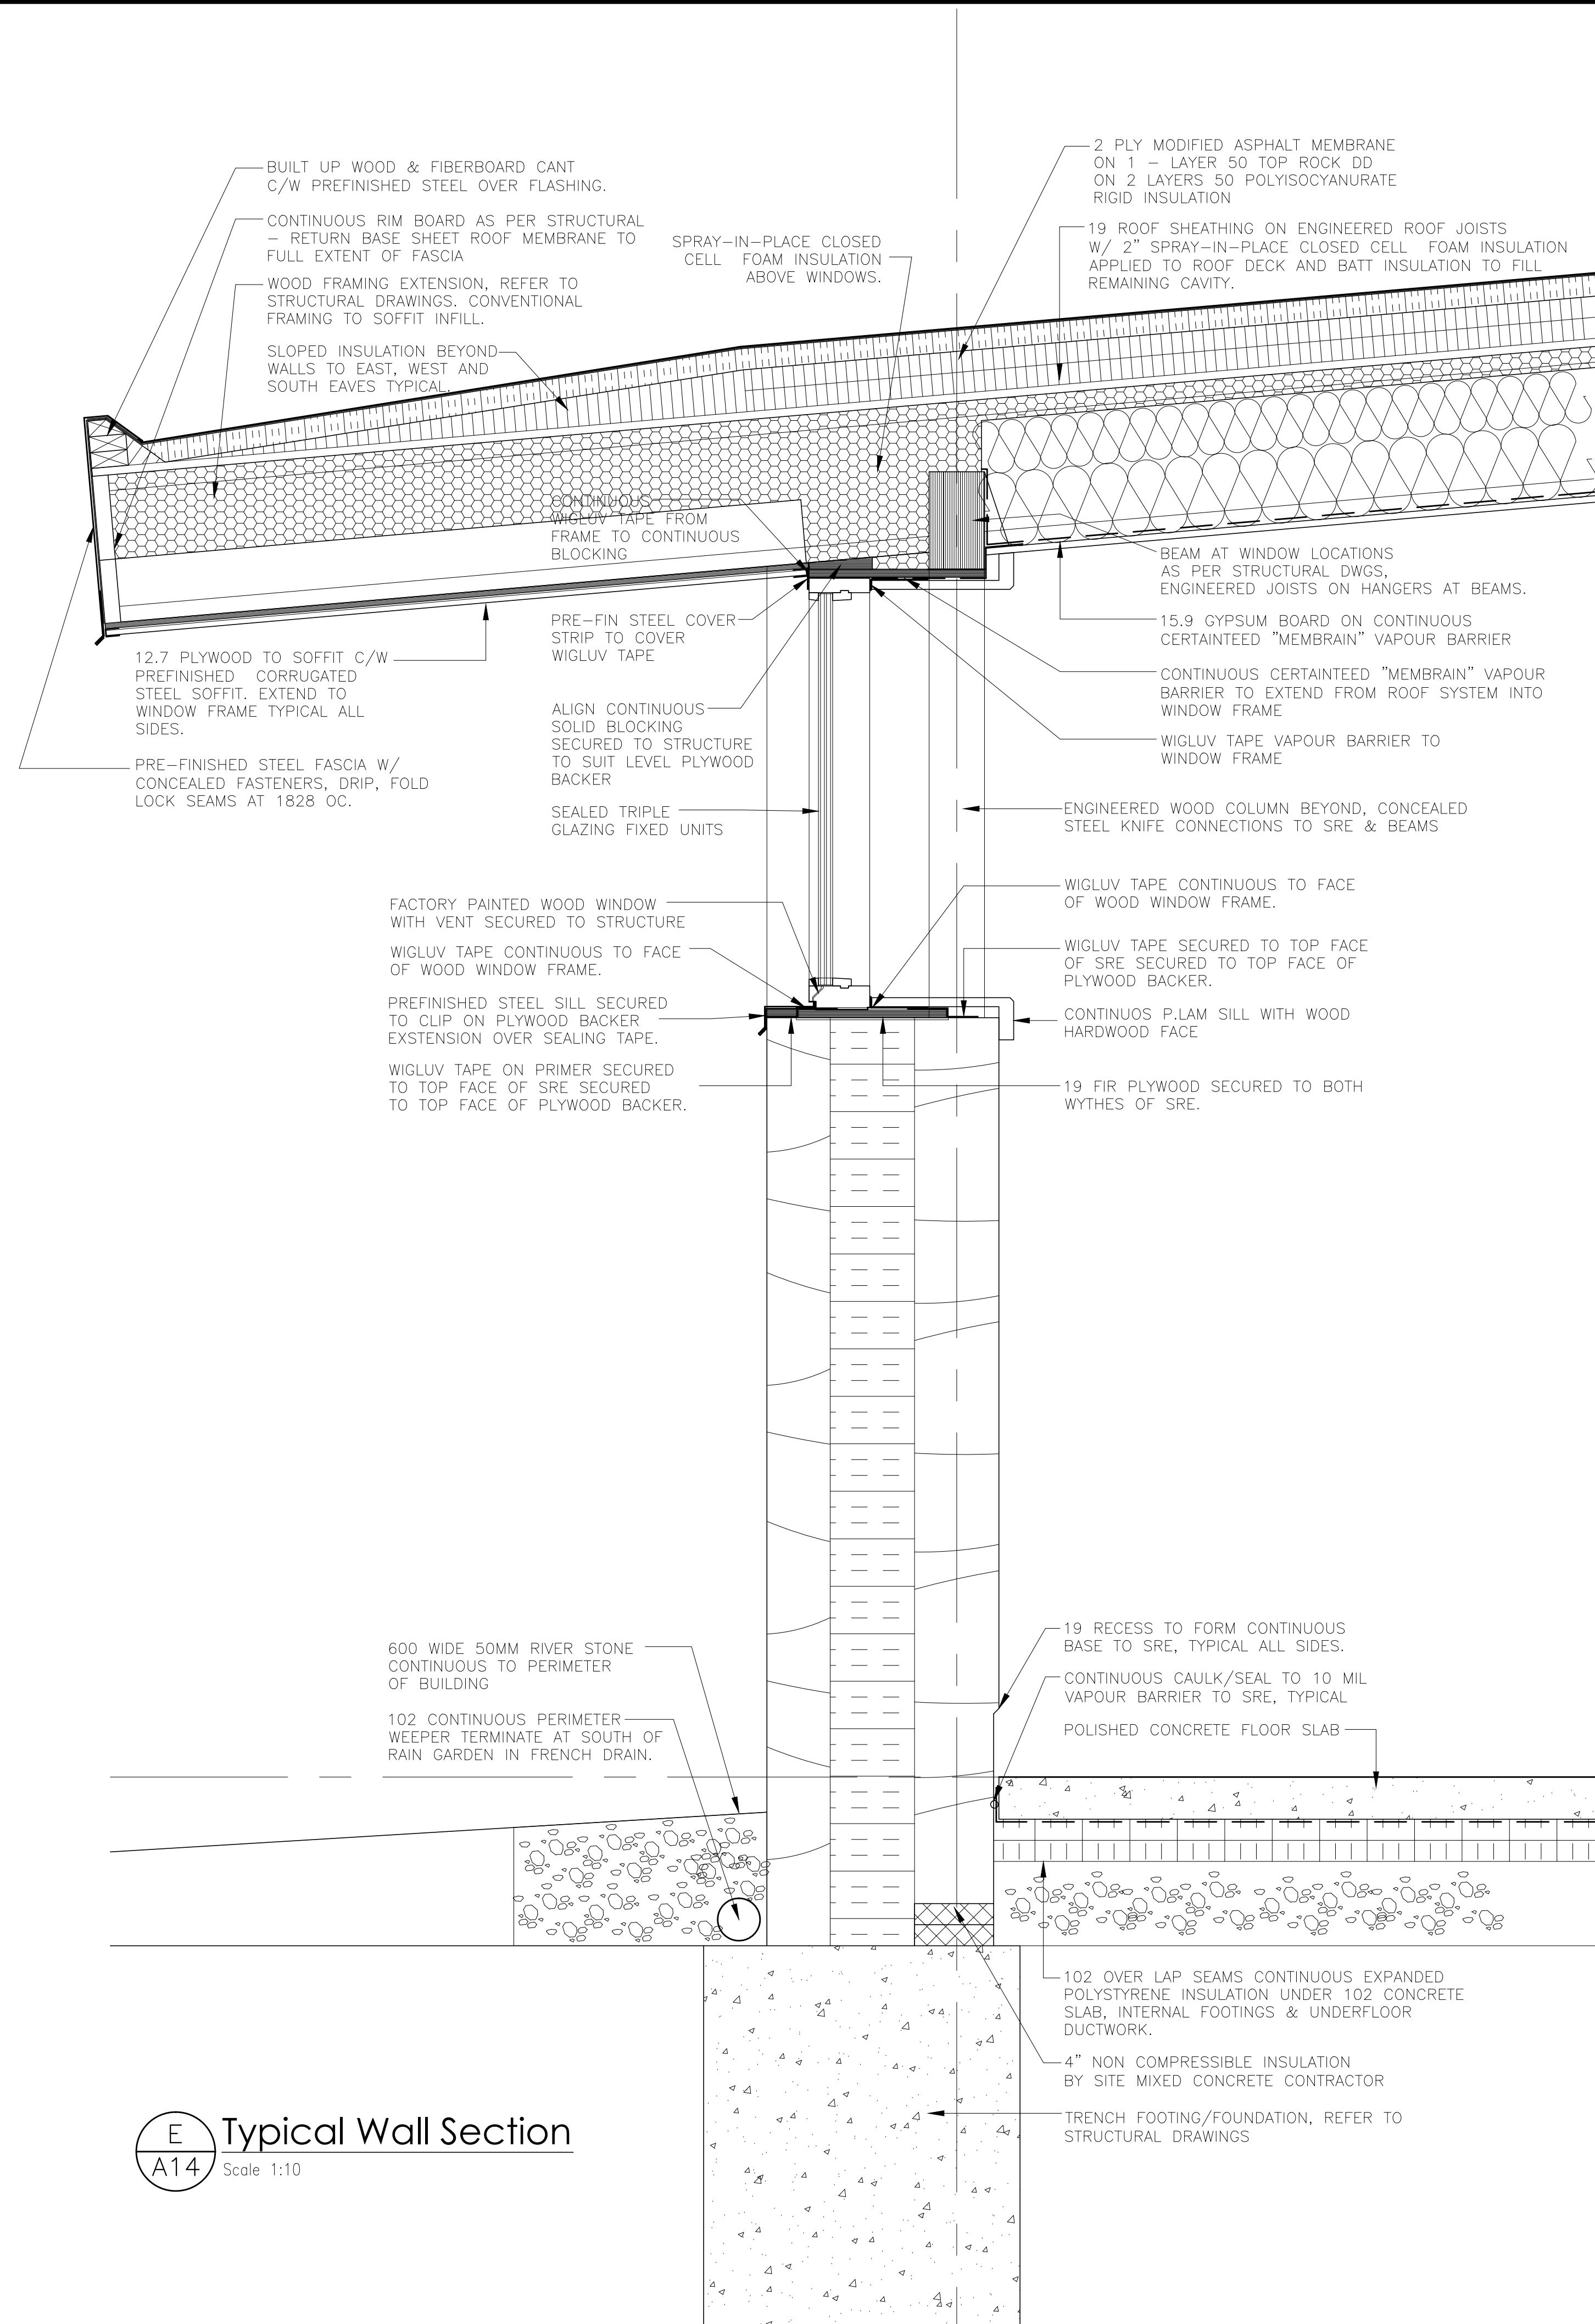

E Typical Wall Section
A14 Scale 1:10

GENERAL NOTES:

1. THE GENERAL NOTES REFER TO ALL ARCHITECTURAL DRAWINGS.
2. DO NOT SCALE DRAWINGS.
3. SITE CHECK ALL DIMENSIONS PRIOR TO CONSTRUCTION.
4. NOTHING ON THESE DRAWINGS SUPERSEDES THE REGULATIONS OF THE GOVERNING CODES INCLUDING THE ONTARIO BUILDING CODE.
5. NOTIFY ARCHITECT OF ALL CONFLICTS AND DISCREPANCIES PRIOR TO CONSTRUCTION.
6. CONTRACTOR TO COORDINATE ARCHITECTURAL, STRUCTURAL, MECHANICAL, ELECTRICAL DRAWINGS BEFORE CONSTRUCTION AND NOTIFY ARCHITECT OF ANY DISCREPANCIES.
7. THESE DRAWINGS ARE NOT INTENDED TO SHOW CIVIL, STRUCTURAL, MECHANICAL OR ELECTRICAL INFORMATION.

5		
4		
3		
2	Issued for Tender & Permit	2017.05.12
1	Issued for 90% Review	2017.04.10
NO.	REVISION	DATE



516 HURON STREET, STRATFORD, ONTARIO N5A 5T7
TEL: 519 271 9230 FAX: 519 271 6560
www.marklevitz.com

THESE DRAWINGS ARE AN INSTRUMENT OF SERVICE AND ALL INFORMATION WITHIN IS THE SOLE PROPERTY AND COPYRIGHT OF MARKLEVITZ ARCHITECTS INC. REPRODUCTION OF THESE DOCUMENTS WITHOUT WRITTEN PERMISSION OF THE ARCHITECT AND CONSULTANTS IS STRICTLY PROHIBITED.


PROJECT
New Waste Management Administration Building

LOCATION
384060 Salford Road
Township of Oxford, Ontario


FOR
Oxford County

DRAWING
Typical Wall Sections & Details


DRAWING NO.
A14
PROJ. No:
3153-16
DATE:
2017.05.12

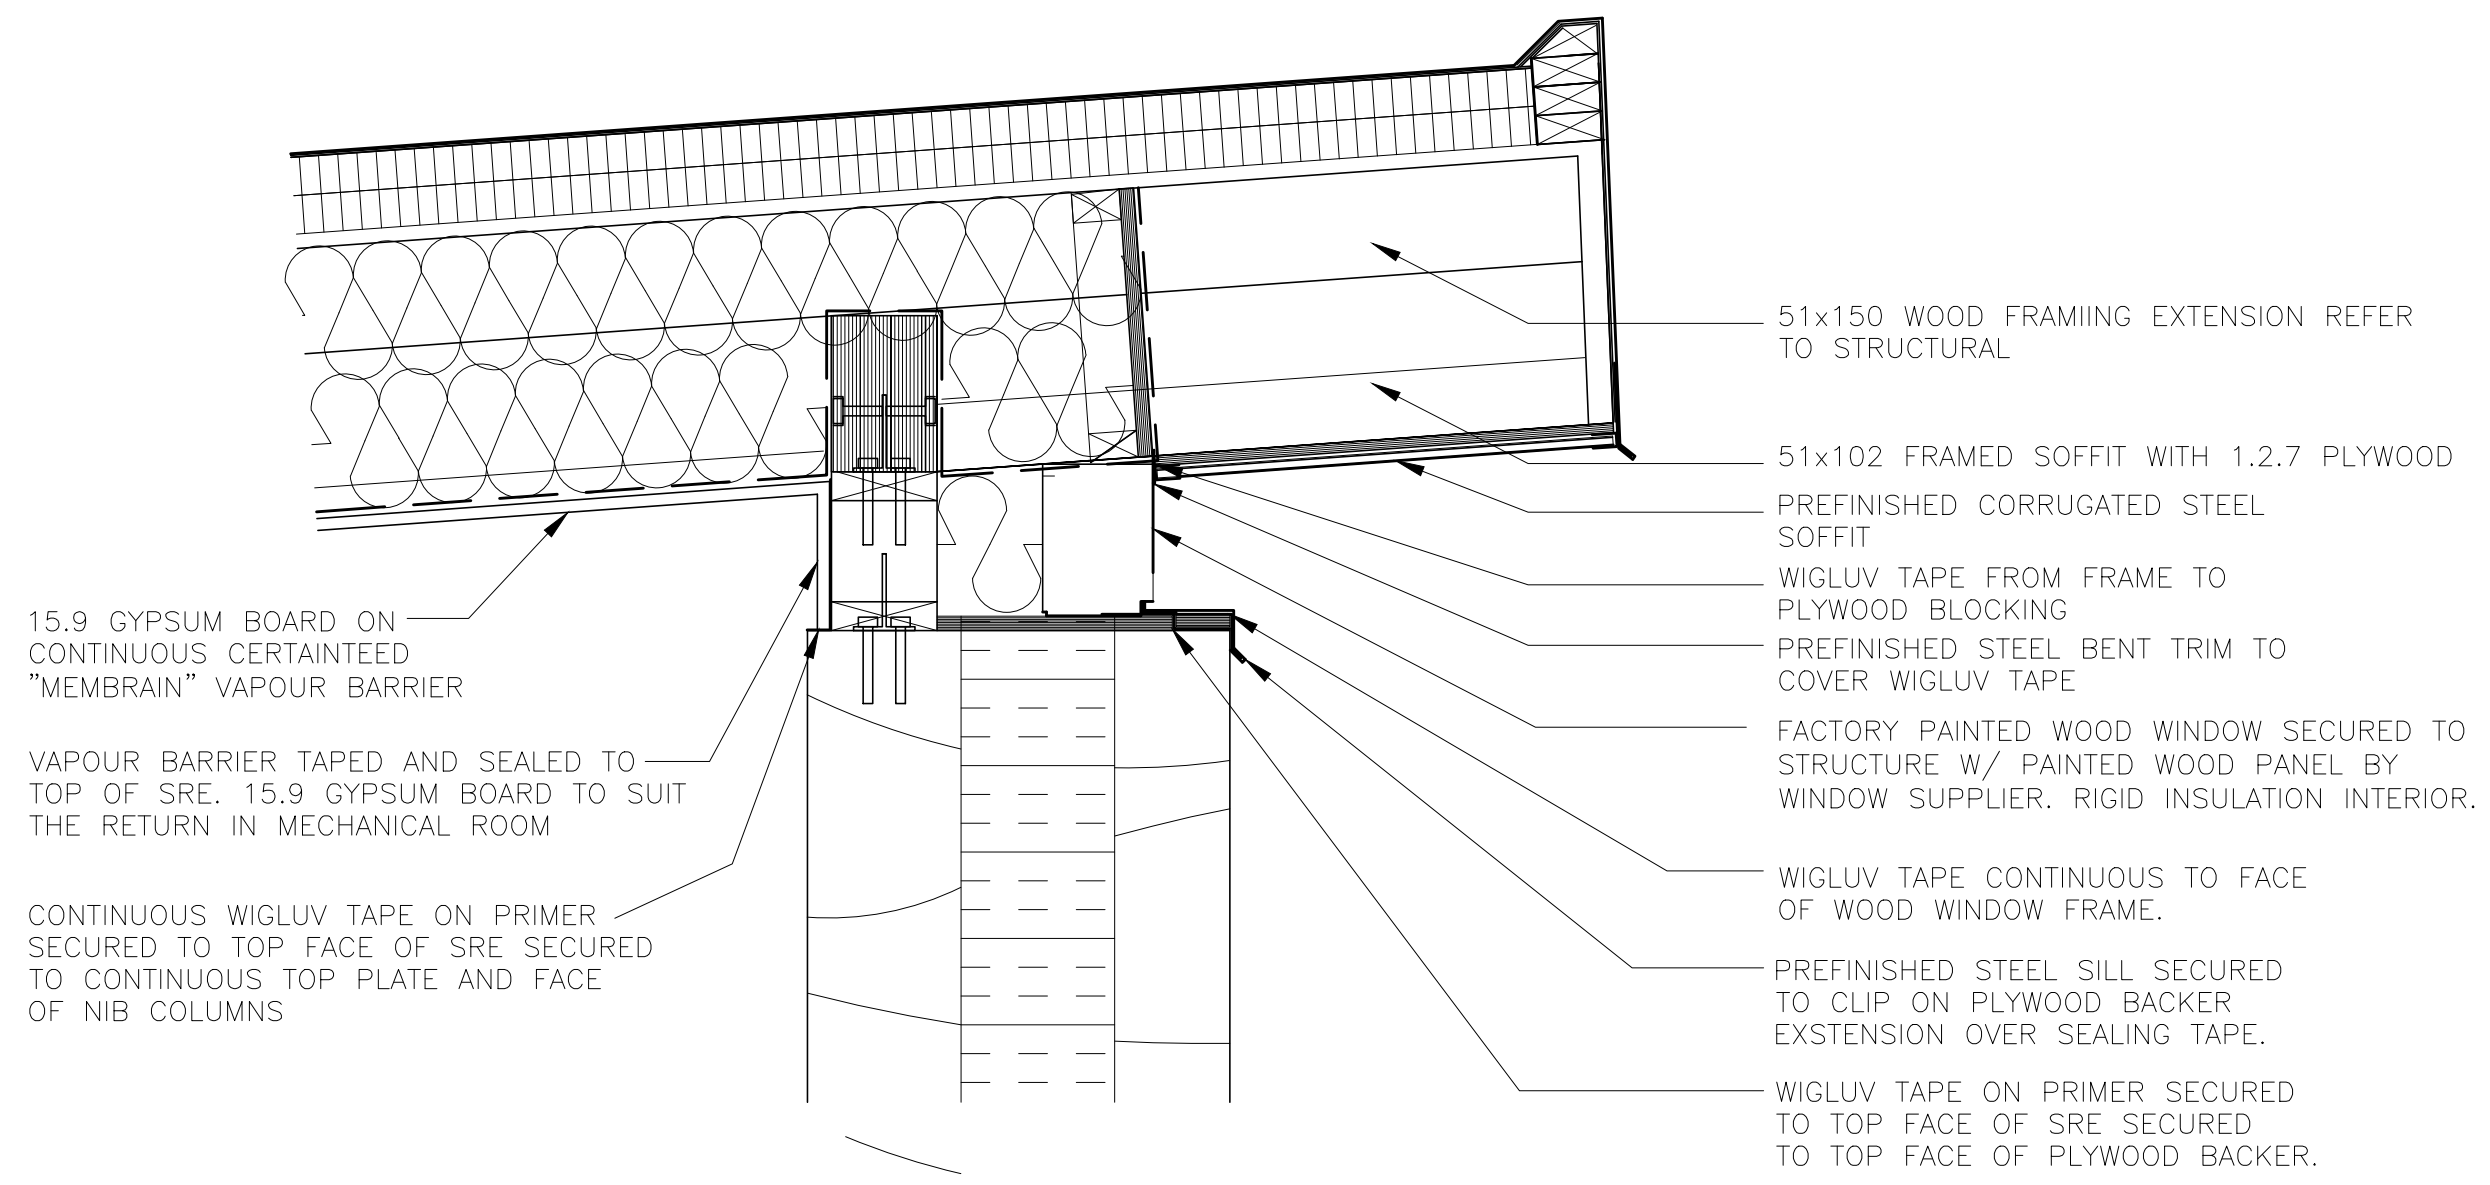


F Section
A15 Scale 1:10

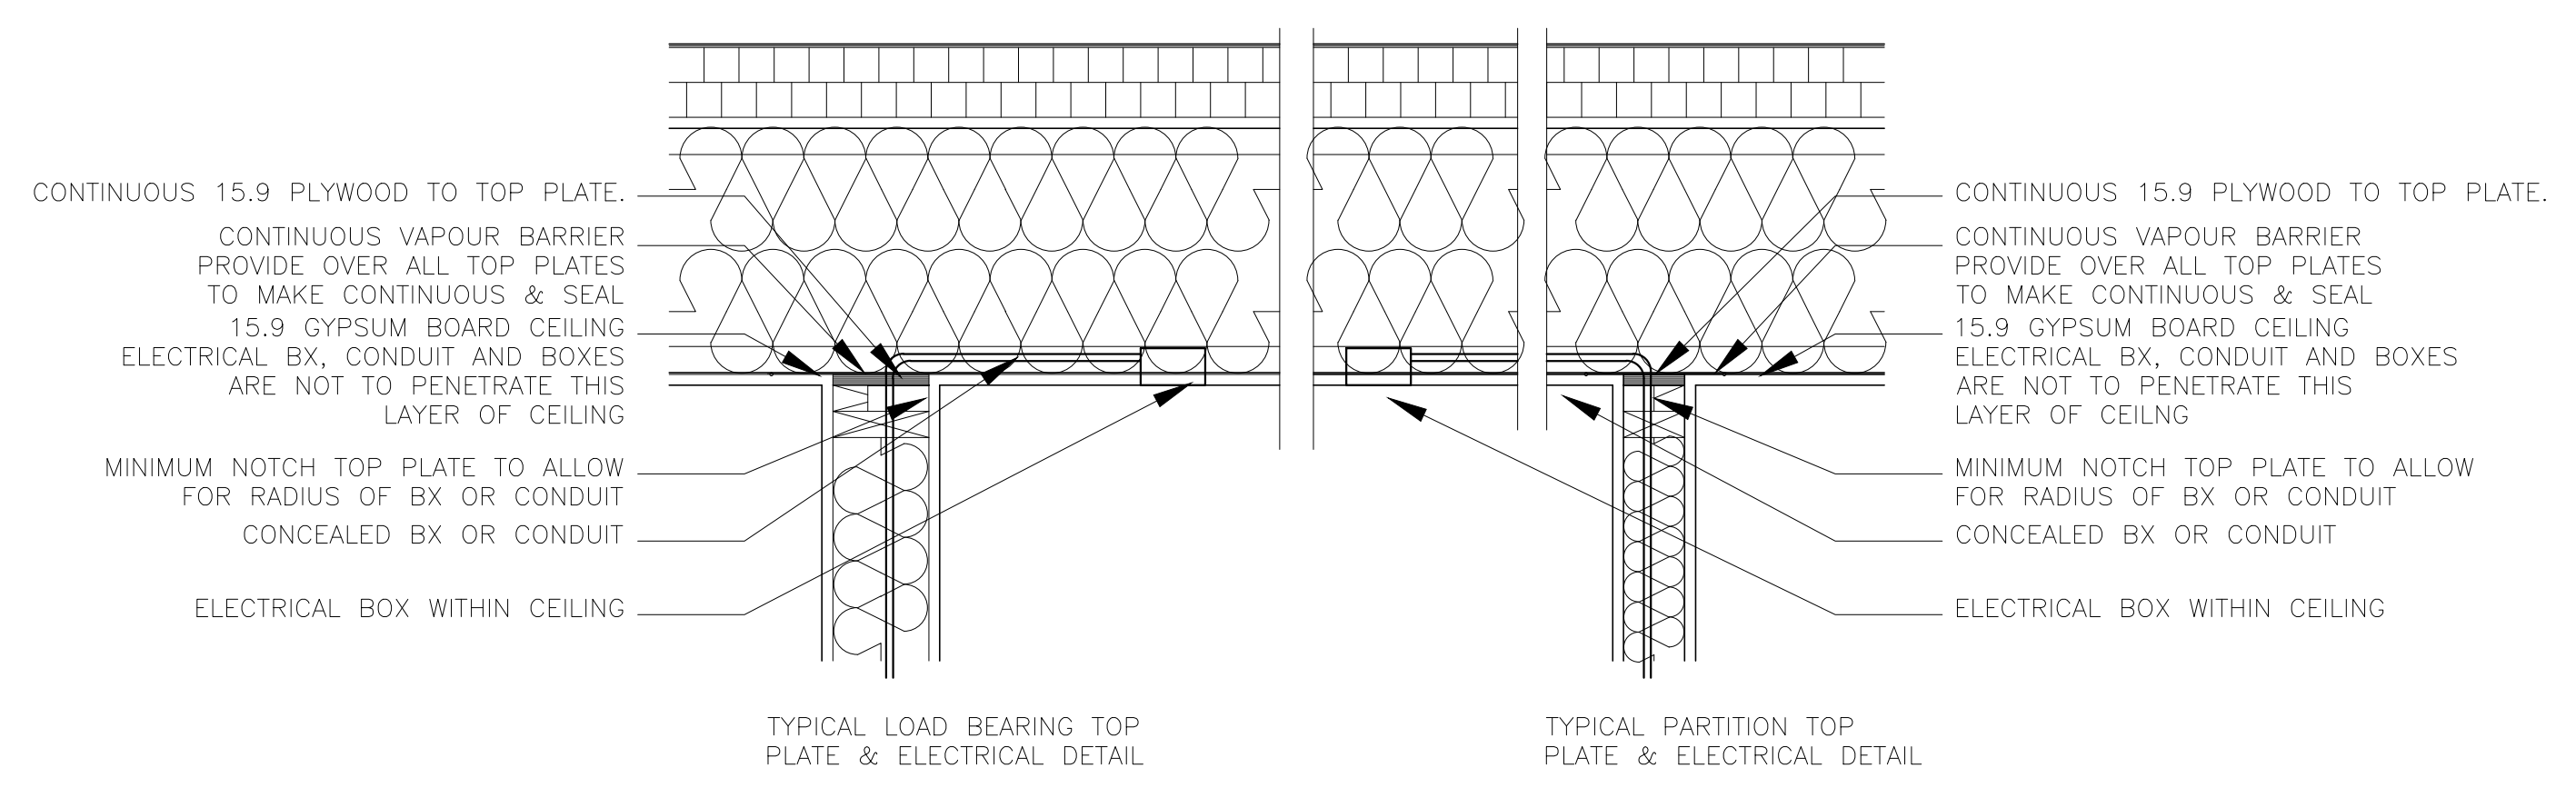


G Typical Section Thru Service Ceiling
A15 Scale 1:10

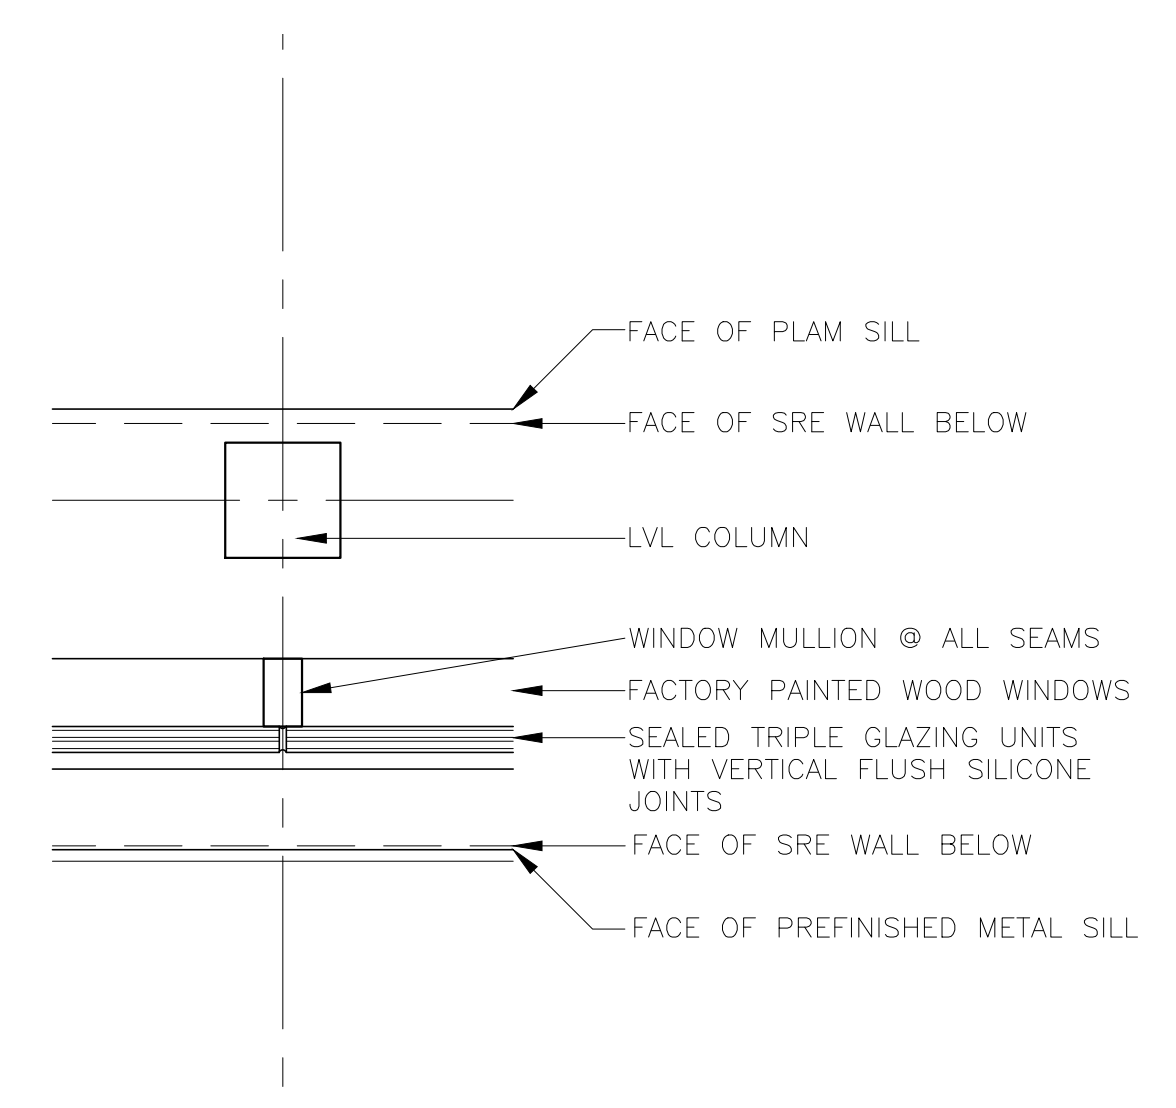


H Typical Plan at Column
A15 Scale 1:10

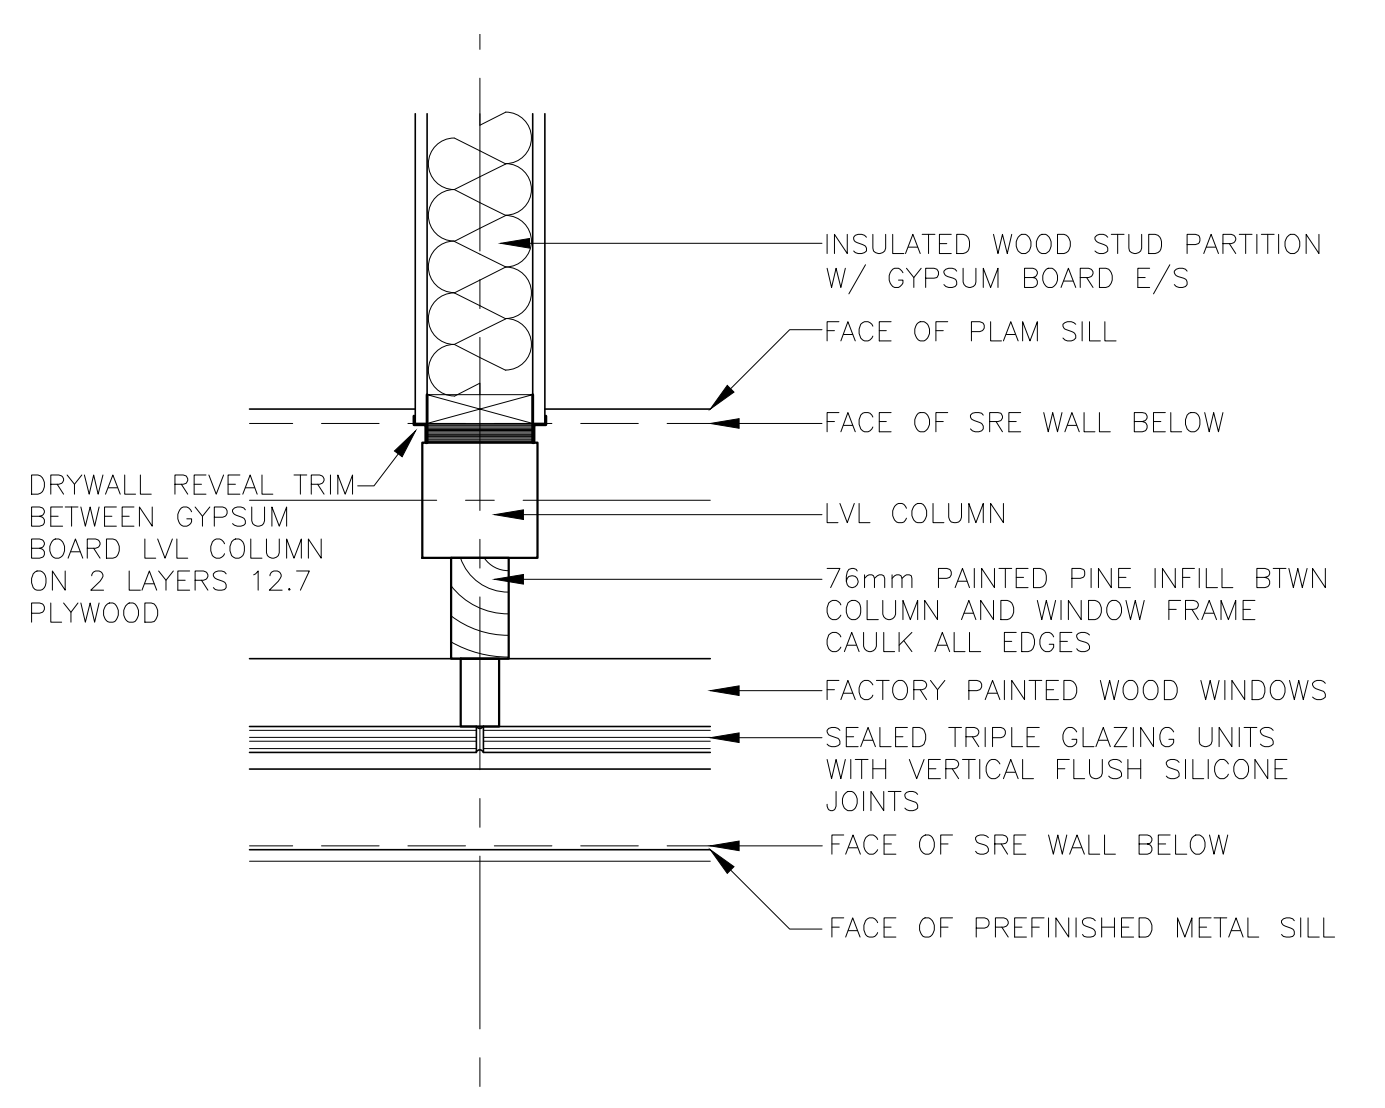


J Typical Plan at Column & Wall
A15 Scale 1:10

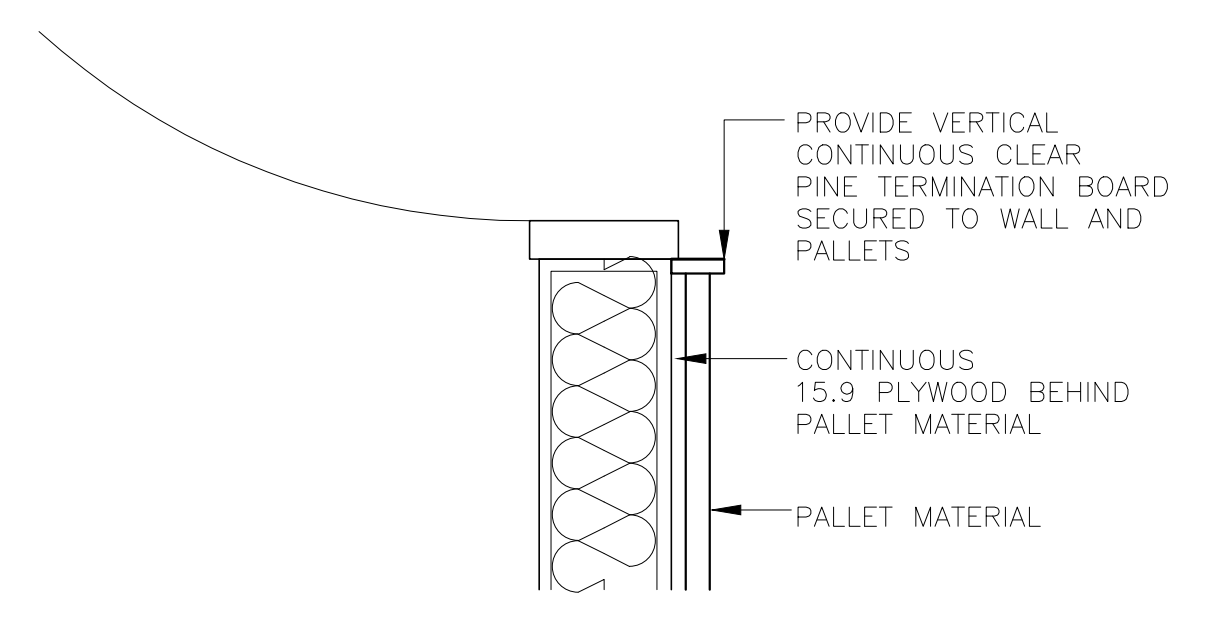

K Feature Wall Plan Detail at Door D9
A15 Scale 1:10

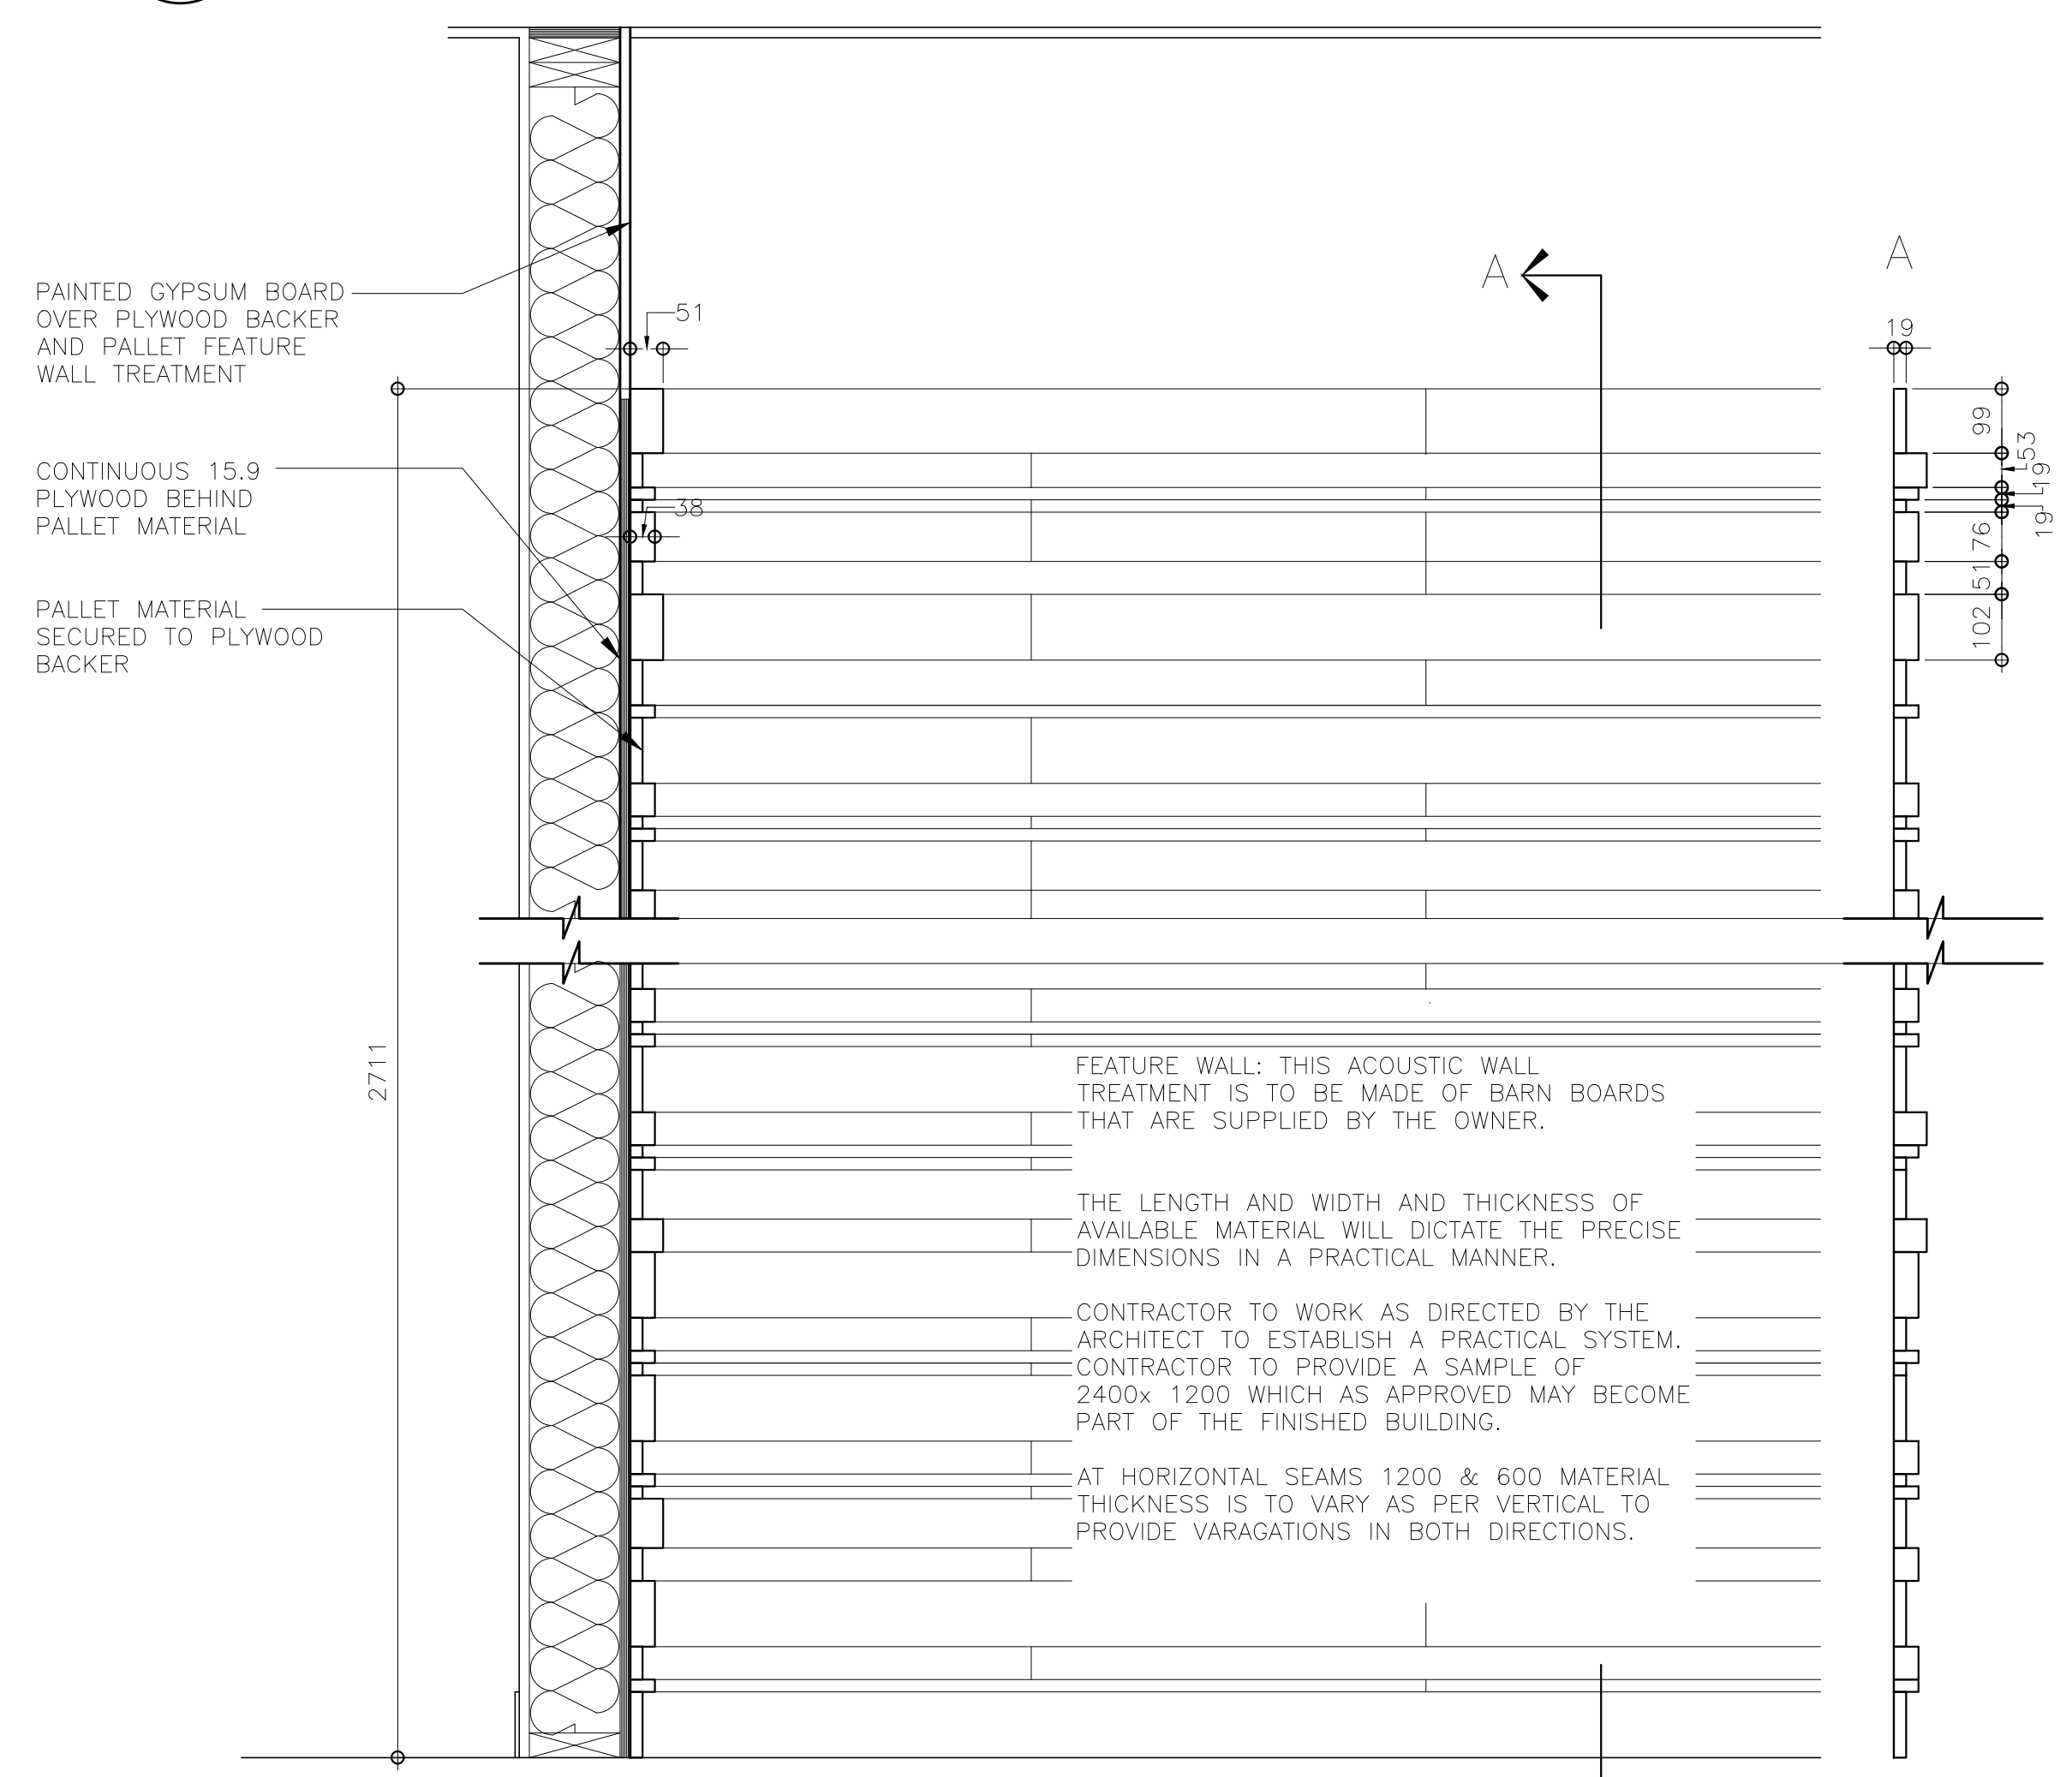

L Feature Wall Section Detail
A15 Scale 1:10

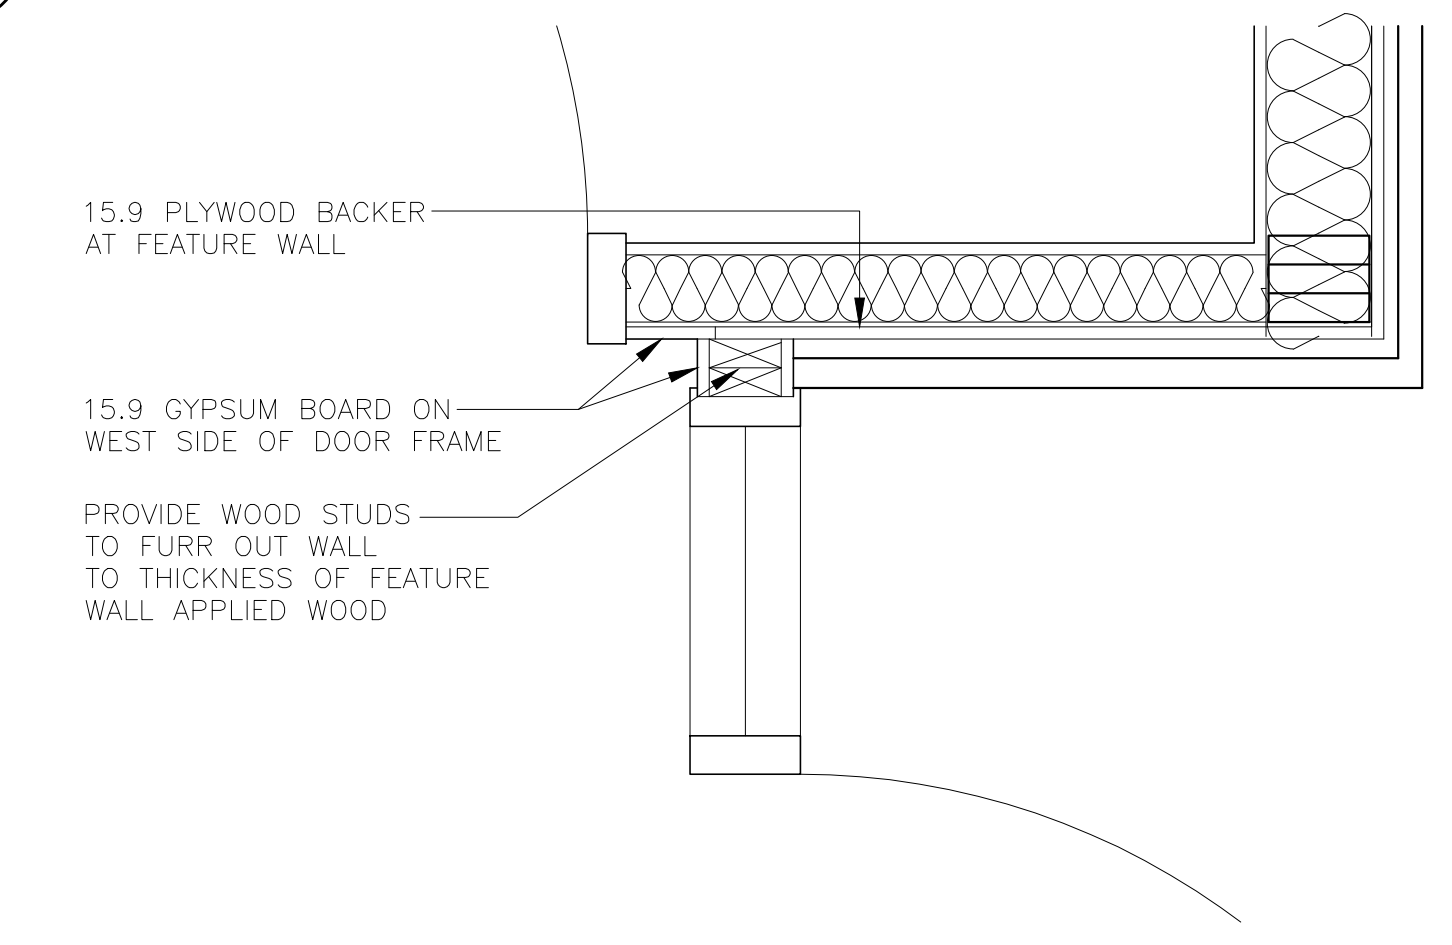

M Feature Wall Plan Detail at Door D7
A15 Scale 1:10

FEATURE WALL: THIS ACOUSTIC WALL TREATMENT IS TO BE MADE OF BARN BOARDS THAT ARE SUPPLIED BY THE OWNER.

THE LENGTH AND WIDTH AND THICKNESS OF AVAILABLE MATERIAL WILL DICTATE THE PRECISE DIMENSIONS IN A PRACTICAL MANNER.

CONTRACTOR TO WORK AS DIRECTED BY THE ARCHITECT TO ESTABLISH A PRACTICAL SYSTEM. CONTRACTOR TO PROVIDE A SAMPLE OF 2400x 1200 WHICH AS APPROVED MAY BECOME PART OF THE FINISHED BUILDING.

AT HORIZONTAL SEAMS 1200 & 600 MATERIAL THICKNESS IS TO VARY AS PER VERTICAL TO PROVIDE VARAGATIONS IN BOTH DIRECTIONS.

- GENERAL NOTES:**
1. THE GENERAL NOTES REFER TO ALL ARCHITECTURAL DRAWINGS.
 2. DO NOT SCALE DRAWINGS.
 3. SITE CHECK ALL DIMENSIONS PRIOR TO CONSTRUCTION.
 4. NOTHING ON THESE DRAWINGS SUPERSEDES THE REGULATIONS OF THE GOVERNING CODES INCLUDING THE ONTARIO BUILDING CODE.
 5. NOTIFY ARCHITECT OF ALL CONFLICTS AND DISCREPANCIES PRIOR TO CONSTRUCTION.
 6. CONTRACTOR TO COORDINATE ARCHITECTURAL, STRUCTURAL, MECHANICAL, ELECTRICAL DRAWINGS BEFORE CONSTRUCTION AND NOTIFY ARCHITECT OF ANY DISCREPANCIES.
 7. THESE DRAWINGS ARE NOT INTENDED TO SHOW CIVIL, STRUCTURAL, MECHANICAL OR ELECTRICAL INFORMATION.

5		
4		
3		
2	Issued for Tender & Permit	2017.05.12
1	Issued for 90% Review	2017.04.10
NO.	REVISION	DATE

M
MARKLEVITZ
ARCHITECTS
inc

516 HURON STREET, STRATFORD, ONTARIO N5A 5T7
TEL: 519 271 9230 FAX: 519 271 6560
www.marklevitz.com

THESE DRAWINGS ARE AN INSTRUMENT OF SERVICE AND ALL INFORMATION WITHIN IS THE SOLE PROPERTY AND COPYRIGHT OF MARKLEVITZ ARCHITECTS INC. REPRODUCTION OF THESE DOCUMENTS WITHOUT WRITTEN PERMISSION OF THE ARCHITECT AND CONSULTANTS IS STRICTLY PROHIBITED.

PROJECT
New Waste Management Administration Building

LOCATION
384060 Salford Road
Township of Oxford, Ontario


FOR
Oxford County

DRAWING
Typical Wall Sections & Details


DRAWING NO.
A15

PROJ. No:
3153-16


DATE:
2017.05.12

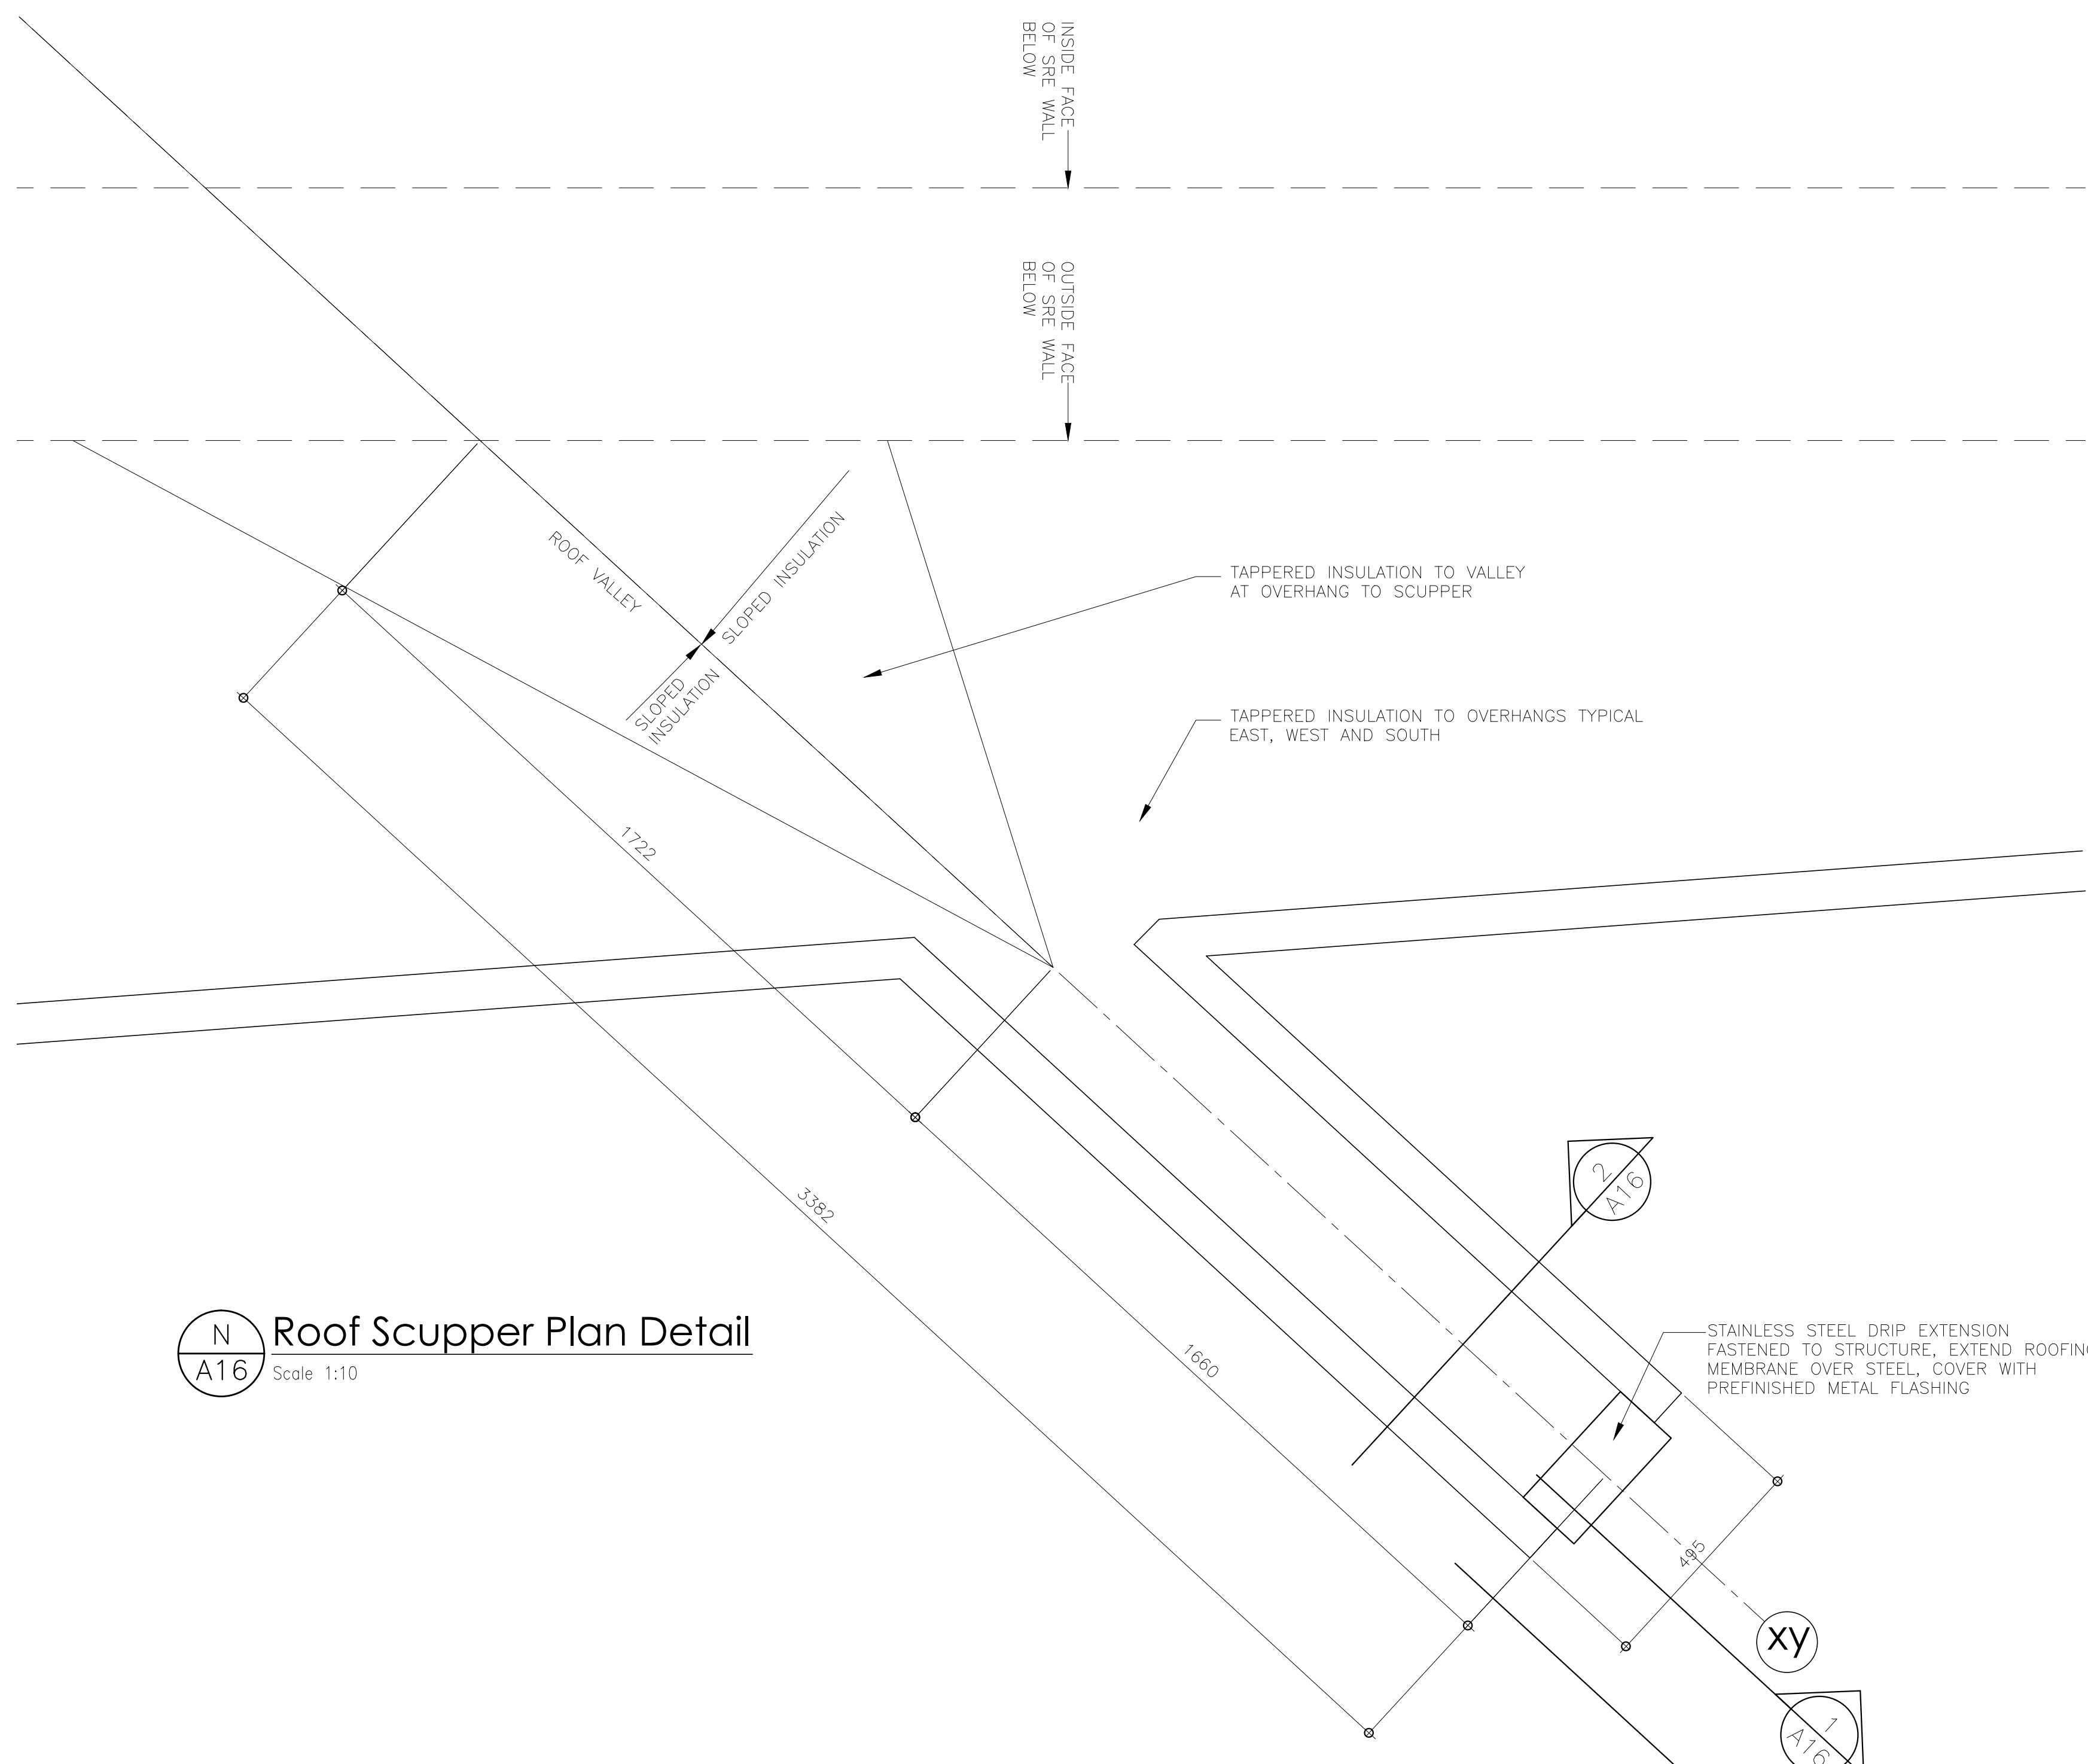


N
Roof Scupper Plan Detail
A16 Scale 1:10

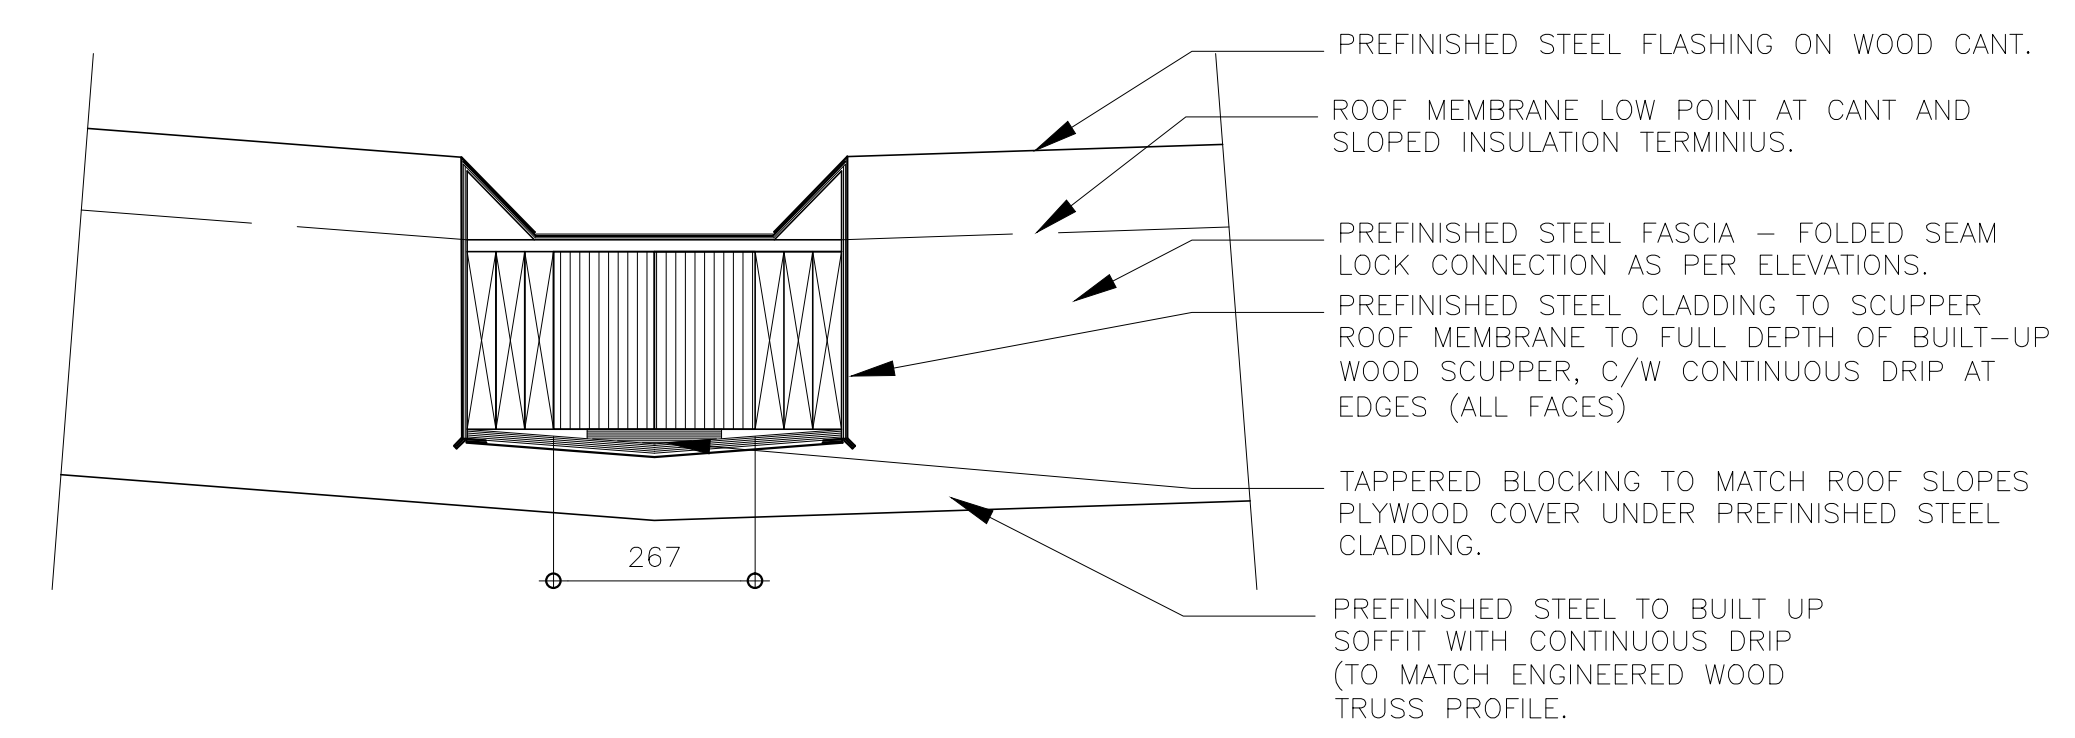

2
Roof Scupper Section Detail
A16 Scale 1:10

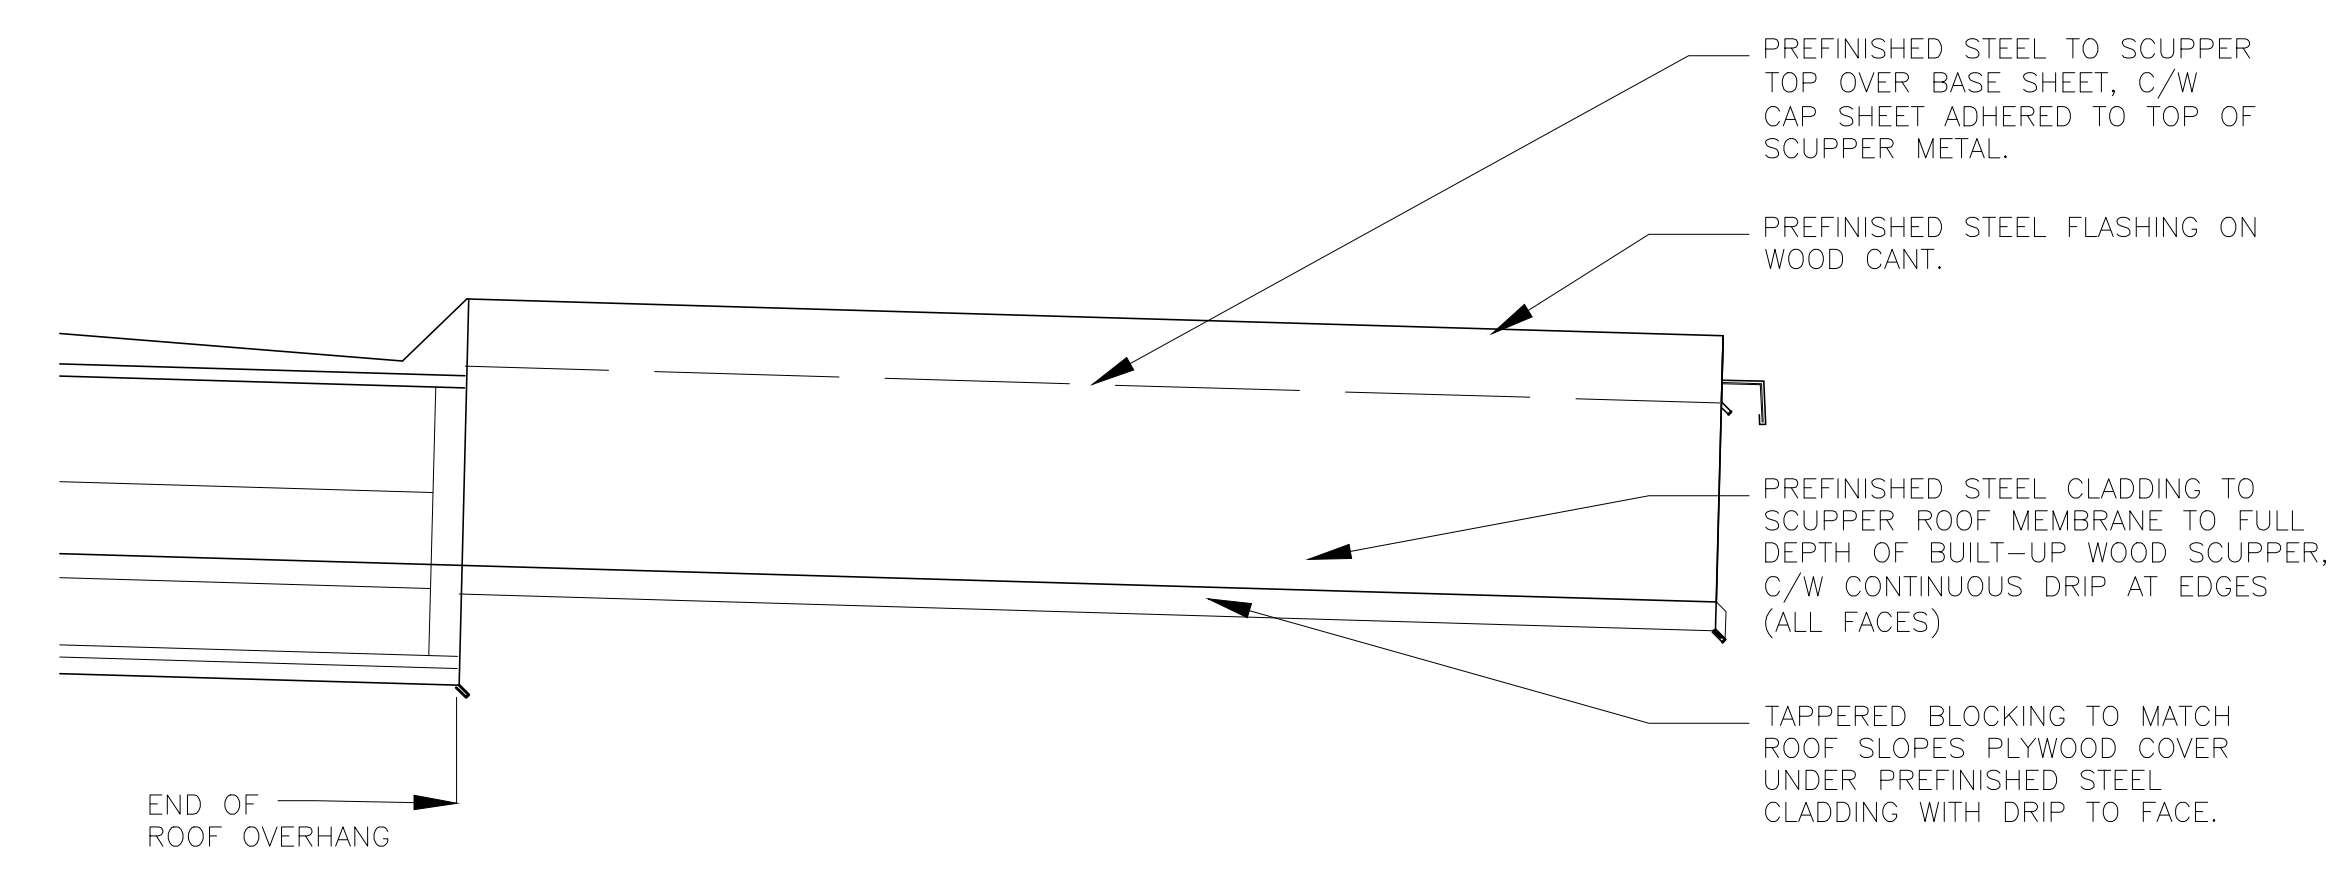

3
Roof Scupper Section Detail
A16 Scale 1:10

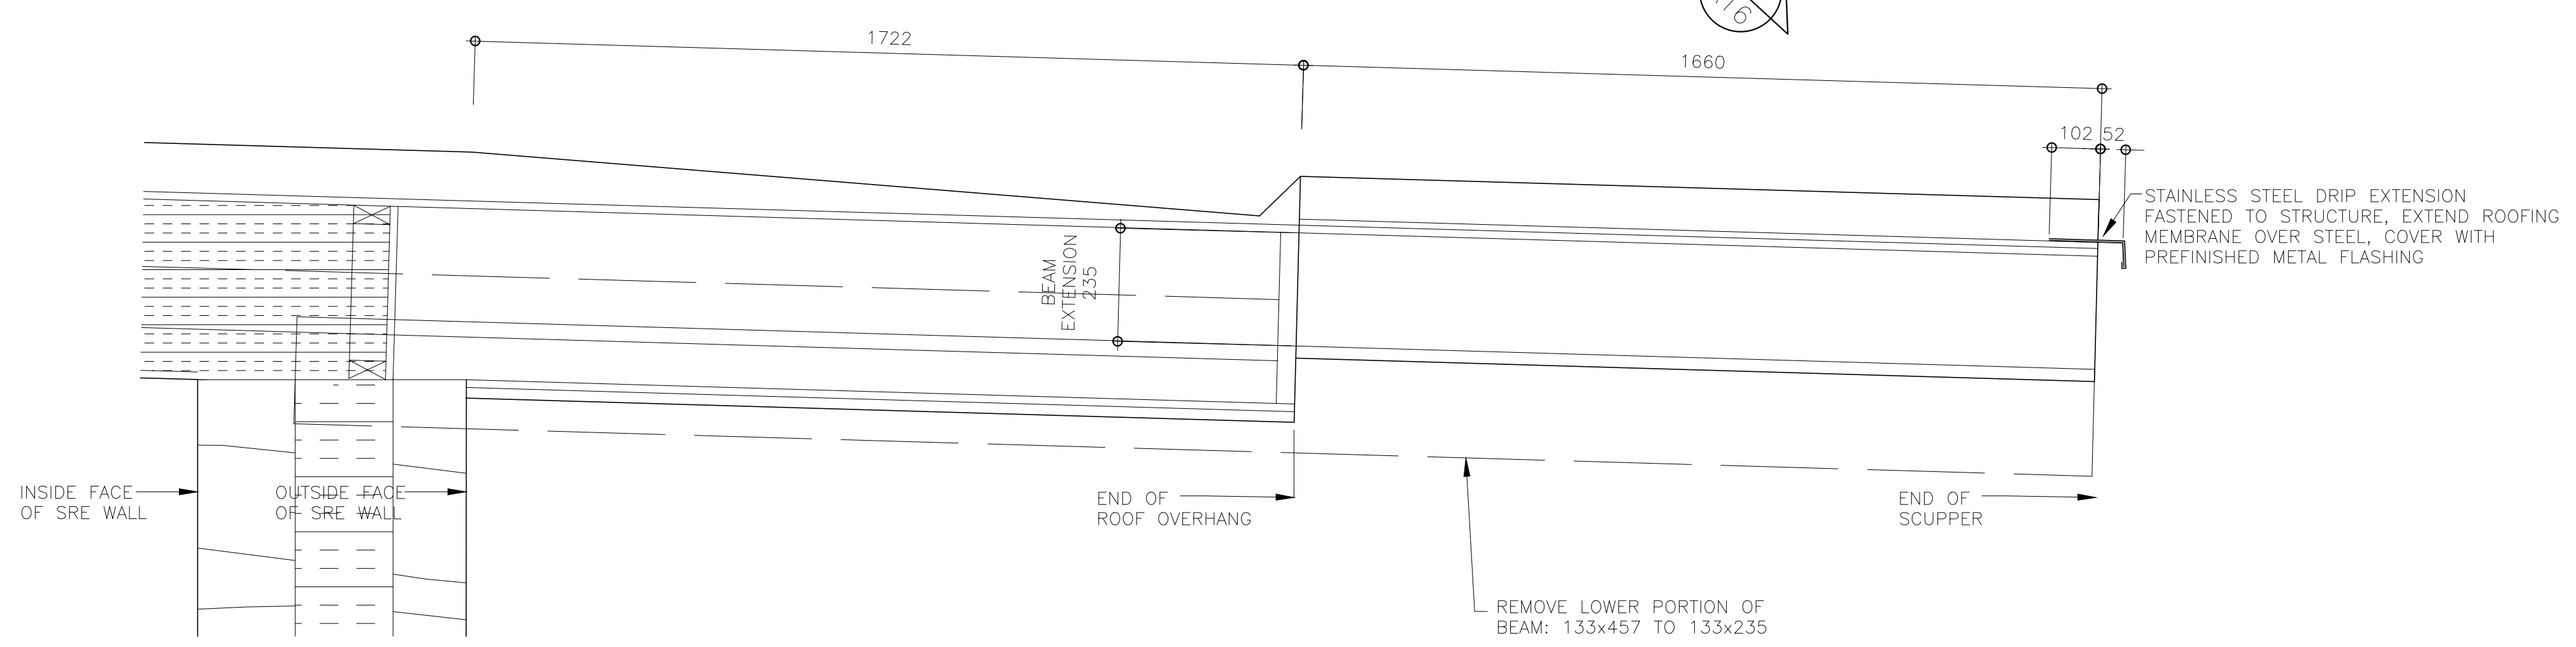

1
Roof Scupper Section Detail
A16 Scale 1:10

- GENERAL NOTES:**
1. THE GENERAL NOTES REFER TO ALL ARCHITECTURAL DRAWINGS.
 2. DO NOT SCALE DRAWINGS.
 3. SITE CHECK ALL DIMENSIONS PRIOR TO CONSTRUCTION.
 4. NOTHING ON THESE DRAWINGS SUPERSEDES THE REGULATIONS OF THE GOVERNING CODES INCLUDING THE ONTARIO BUILDING CODE.
 5. NOTIFY ARCHITECT OF ALL CONFLICTS AND DISCREPANCIES PRIOR TO CONSTRUCTION.
 6. CONTRACTOR TO COORDINATE ARCHITECTURAL, STRUCTURAL, MECHANICAL, ELECTRICAL DRAWINGS BEFORE CONSTRUCTION AND NOTIFY ARCHITECT OF ANY DISCREPANCIES.
 7. THESE DRAWINGS ARE NOT INTENDED TO SHOW CIVIL, STRUCTURAL, MECHANICAL OR ELECTRICAL INFORMATION.

5		
4		
3	AS-BUILT	2018.07.23
2	Issued for Tender & Permit	2017.05.12
1	Issued for 90% Review	2017.04.10
NO.	REVISION	DATE

M
MARKLEVITZ ARCHITECTS
inc

516 HURON STREET, STRATFORD, ONTARIO N5A 5T7
TEL: 519 271 9230 FAX: 519 271 6560
www.marklevitz.com

THESE DRAWINGS ARE AN INSTRUMENT OF SERVICE AND ALL INFORMATION WITHIN IS THE SOLE PROPERTY AND COPYRIGHT OF MARKLEVITZ ARCHITECTS INC. REPRODUCTION OF THESE DOCUMENTS WITHOUT WRITTEN PERMISSION OF THE ARCHITECT AND CONSULTANTS IS STRICTLY PROHIBITED.


PROJECT
New Waste Management Administration Building

LOCATION
384060 Salford Road
Township of Oxford, Ontario

FOR
Oxford County

DRAWING
Roof Scupper Details

DRAWING NO.	A16
PROJ. No:	3153-16
DATE:	2017.05.12

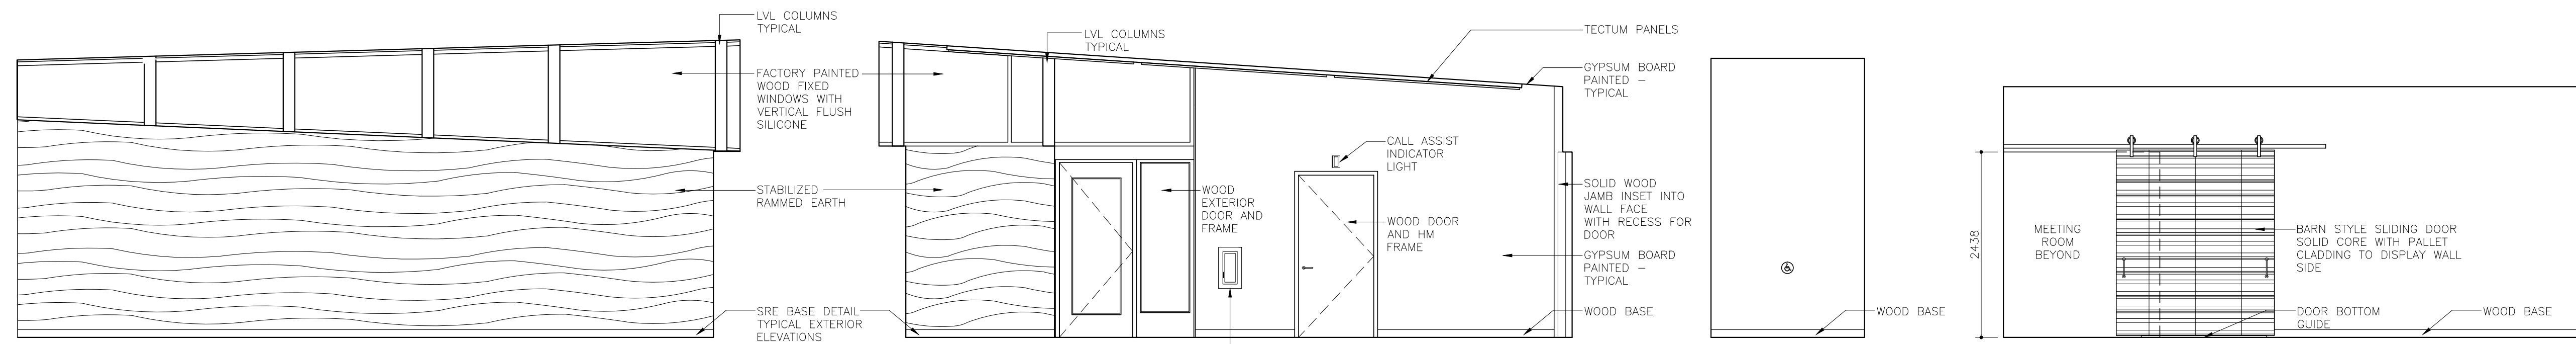


Int. Elev. 1 Entrance 101
Scale 1:50

Int. Elev. 2 Entrance 101
Scale 1:50

Int. Elev. 3 Entrance 101
Scale 1:50

Int. Elev. 4 Display 105
Scale 1:50

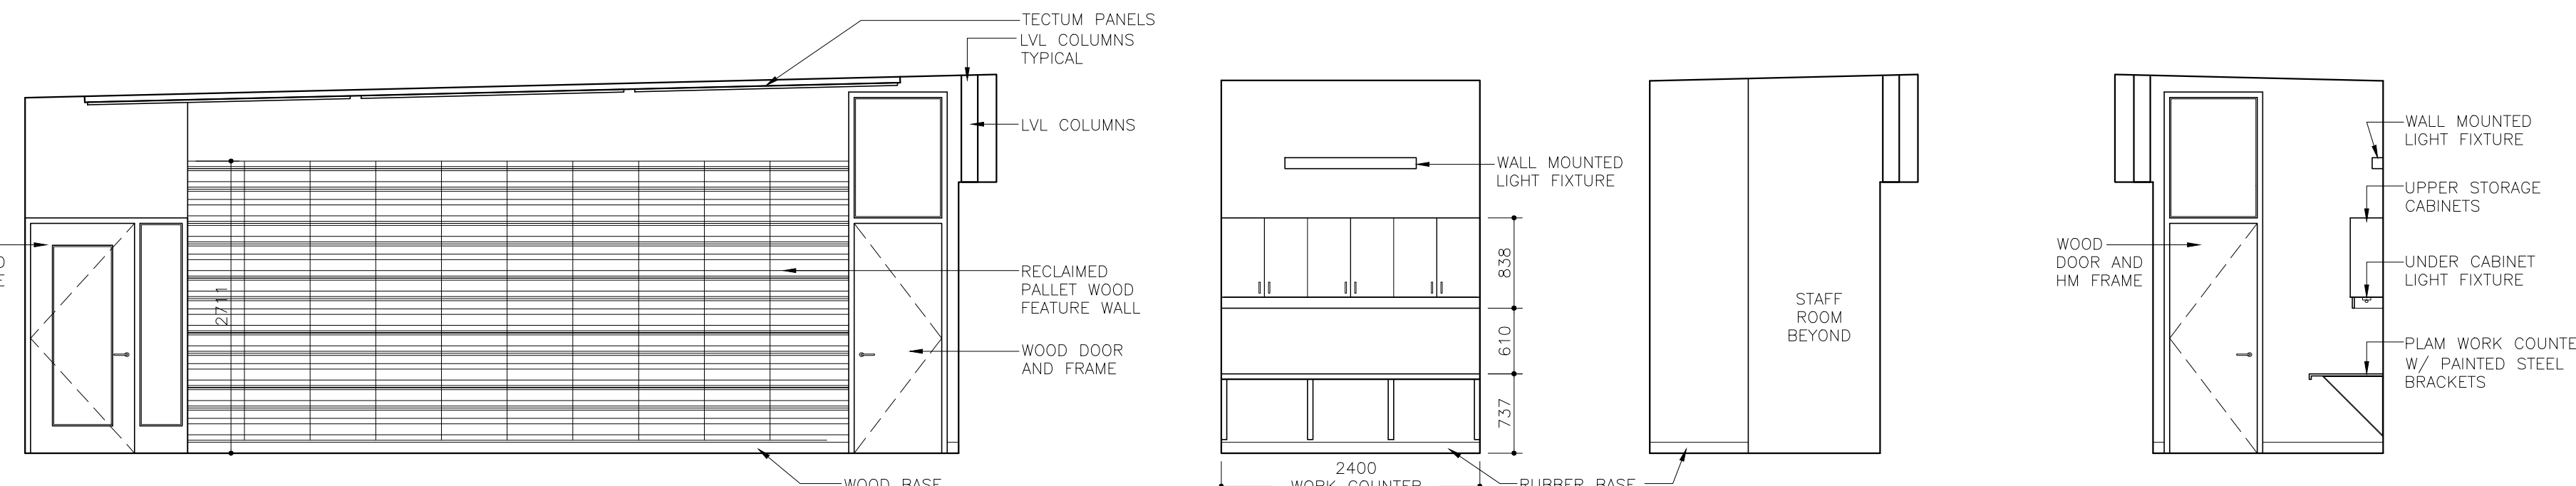

Int. Elev. 5 Display 105
Scale 1:50


Int. Elev. 6 Alcove 106
Scale 1:50

Int. Elev. 7 Alcove 106
Scale 1:50

Int. Elev. 8 Alcove 106
Scale 1:50

UNLESS NOTED OTHERWISE, ALL INTERIOR WALLS ARE GYPSUM BOARD WITH PAINT FINISH
UNLESS NOTED OTHERWISE, CEILINGS THROUGHOUT ARE PAINTED GYPSUM BOARD

- GB - GRAB BAR
- TP - TOILET PAPER HOLDER
- TD - TOWEL DISPENSER
- SD - SOAP DISPENSER
- WR - WASTE RECEPTACLE
- ND - NAPKIN DISPOSAL
- CH - COLLAPSIBLE COAT HOOK
- PB - AUTO OPERATOR BUTTON
- EA - EMERGENCY ASSIST BUTTON

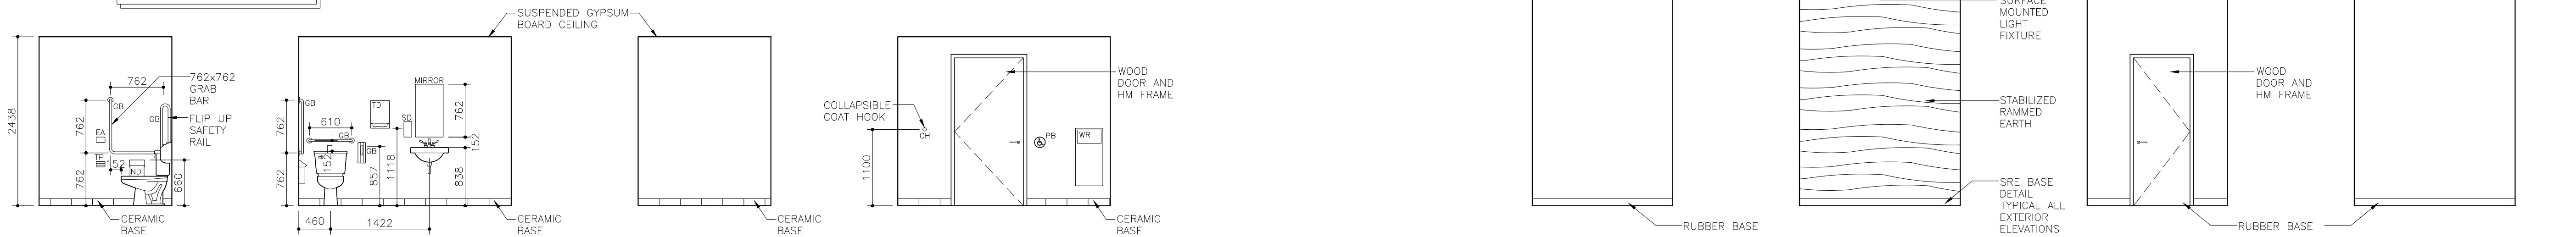

Int. Elev. 9 Washroom 102

Int. Elev. 10 Washroom 102

Int. Elev. 11 Washroom 102


Int. Elev. 12 Washroom 102

Int. Elev. 13 Electrical Room 103
Scale 1:50

Int. Elev. 14 Electrical Room 103
Scale 1:50

Int. Elev. 15 Electrical Room 103
Scale 1:50

Int. Elev. 16 Electrical Room 103
Scale 1:50

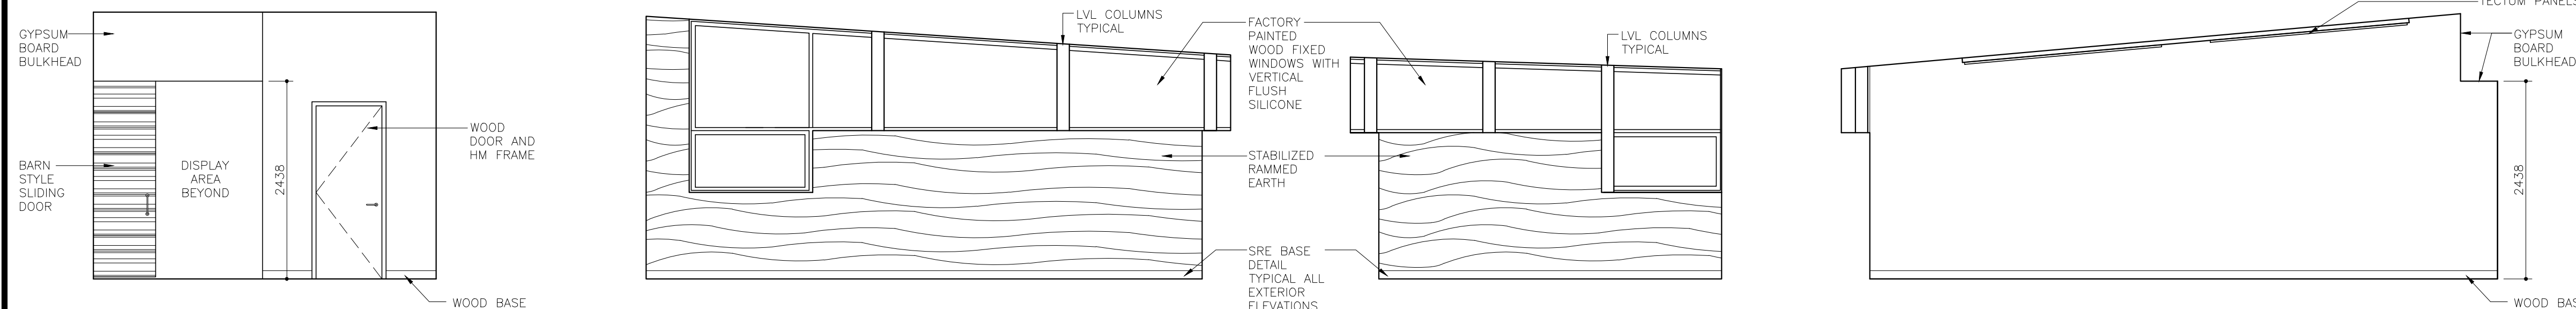

Int. Elev. 17 Meeting Room 104
Scale 1:50

Int. Elev. 18 Meeting Room 104
Scale 1:50

Int. Elev. 19 Meeting Room 104
Scale 1:50

Int. Elev. 20 Meeting Room 104
Scale 1:50

UNLESS NOTED OTHERWISE, ALL INTERIOR WALLS ARE GYPSUM BOARD WITH PAINT FINISH
UNLESS NOTED OTHERWISE, CEILINGS THROUGHOUT ARE PAINTED GYPSUM BOARD

GENERAL NOTES:

1. THE GENERAL NOTES REFER TO ALL ARCHITECTURAL DRAWINGS.
2. DO NOT SCALE DRAWINGS.
3. SITE CHECK ALL DIMENSIONS PRIOR TO CONSTRUCTION.
4. NOTHING ON THESE DRAWINGS SUPERSEDES THE REGULATIONS OF THE GOVERNING CODES INCLUDING THE ONTARIO BUILDING CODE.
5. NOTIFY ARCHITECT OF ALL CONFLICTS AND DISCREPANCIES PRIOR TO CONSTRUCTION.
6. CONTRACTOR TO COORDINATE ARCHITECTURAL, STRUCTURAL, MECHANICAL, ELECTRICAL DRAWINGS BEFORE CONSTRUCTION AND NOTIFY ARCHITECT OF ANY DISCREPANCIES.
7. THESE DRAWINGS ARE NOT INTENDED TO SHOW CIVIL, STRUCTURAL, MECHANICAL OR ELECTRICAL INFORMATION.

5		
4		
3	AS-BUILT	2018.07.23
2	Issued for Tender & Permit	2017.05.12
1	Issued for 90% Review	2017.04.10
NO.	REVISION	DATE



516 HURON STREET, STRATFORD, ONTARIO N5A 5T7
TEL: 519 271 9230 FAX: 519 271 6560
www.marklevitz.com

THESE DRAWINGS ARE AN INSTRUMENT OF SERVICE AND ALL INFORMATION WITHIN IS THE SOLE PROPERTY AND COPYRIGHT OF MARKLEVITZ ARCHITECTS INC. REPRODUCTION OF THESE DOCUMENTS WITHOUT WRITTEN PERMISSION OF THE ARCHITECT AND CONSULTANTS IS STRICTLY PROHIBITED.


PROJECT
New Waste Management Administration Building

LOCATION
**384060 Salford Road
Township of Oxford, Ontario**

FOR
Oxford County





DRAWING
Interior Elevations

DRAWING NO.	A17
PROJ. No:	3153-16
DATE:	2017.05.12

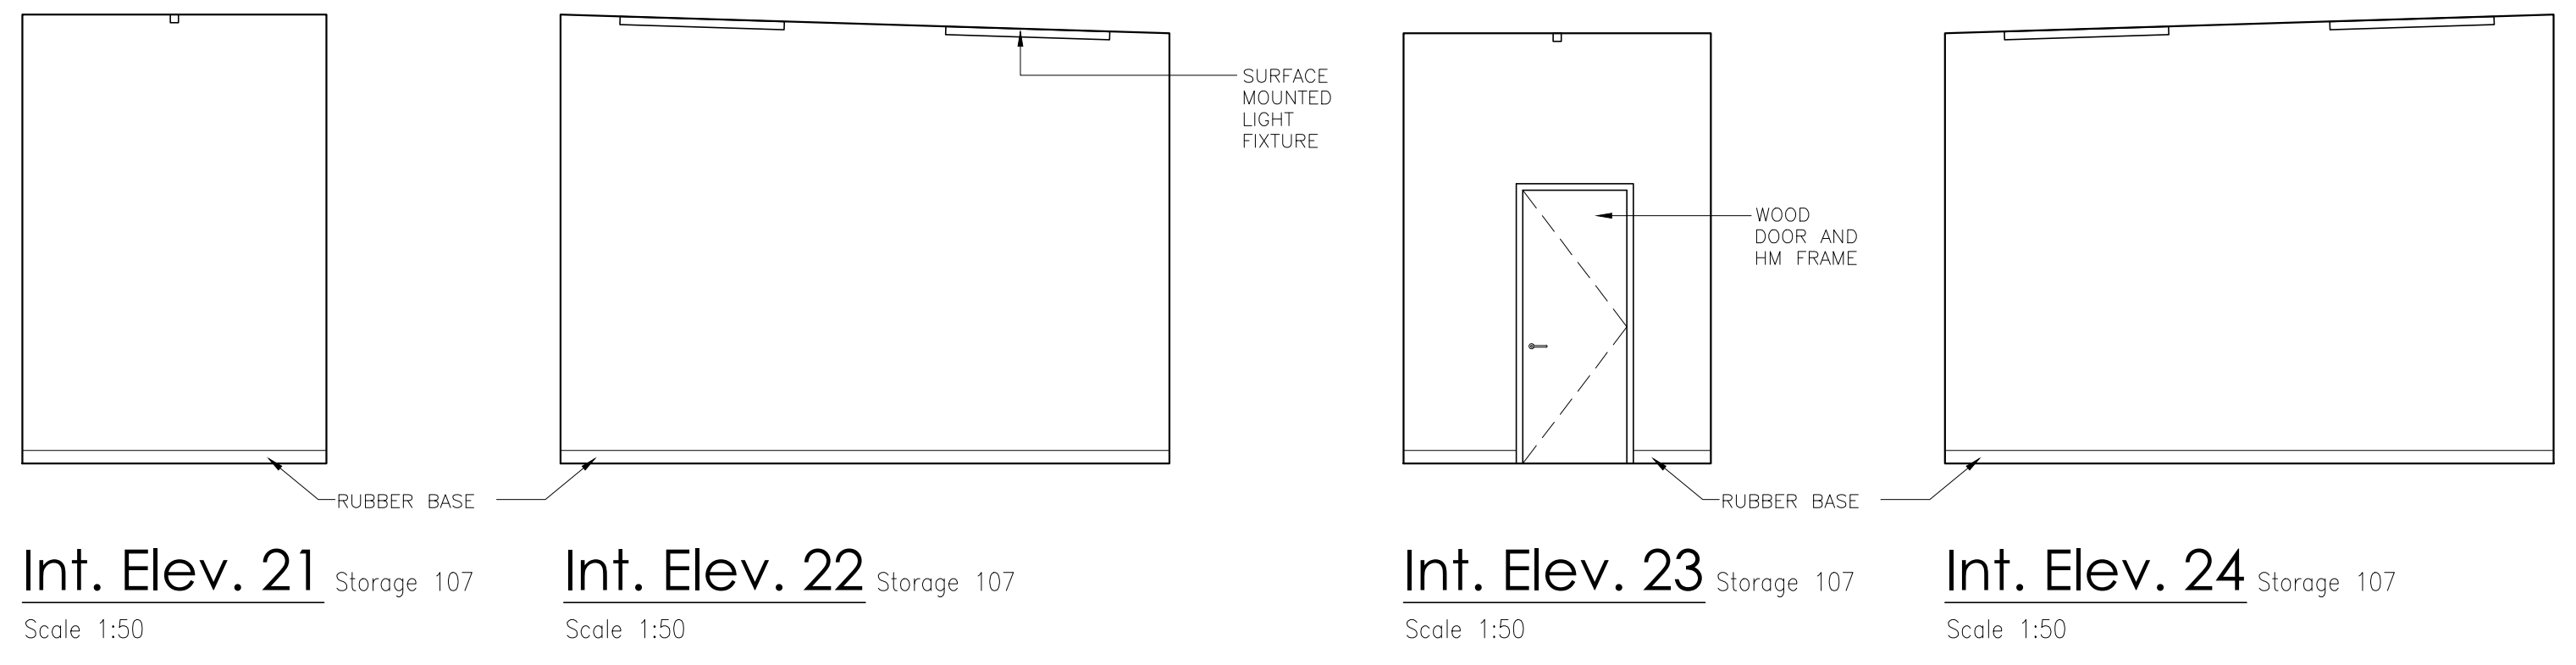

UNLESS NOTED OTHERWISE, ALL INTERIOR WALLS ARE GYPSUM BOARD WITH PAINT FINISH
UNLESS NOTED OTHERWISE, CEILINGS THROUGHOUT ARE PAINTED GYPSUM BOARD

- GENERAL NOTES:**
1. THE GENERAL NOTES REFER TO ALL ARCHITECTURAL DRAWINGS.
 2. DO NOT SCALE DRAWINGS.
 3. SITE CHECK ALL DIMENSIONS PRIOR TO CONSTRUCTION.
 4. NOTHING ON THESE DRAWINGS SUPERSEDES THE REGULATIONS OF THE GOVERNING CODES INCLUDING THE ONTARIO BUILDING CODE.
 5. NOTIFY ARCHITECT OF ALL CONFLICTS AND DISCREPANCIES PRIOR TO CONSTRUCTION.
 6. CONTRACTOR TO COORDINATE ARCHITECTURAL, STRUCTURAL, MECHANICAL, ELECTRICAL DRAWINGS BEFORE CONSTRUCTION AND NOTIFY ARCHITECT OF ANY DISCREPANCIES.
 7. THESE DRAWINGS ARE NOT INTENDED TO SHOW CIVIL, STRUCTURAL, MECHANICAL OR ELECTRICAL INFORMATION.

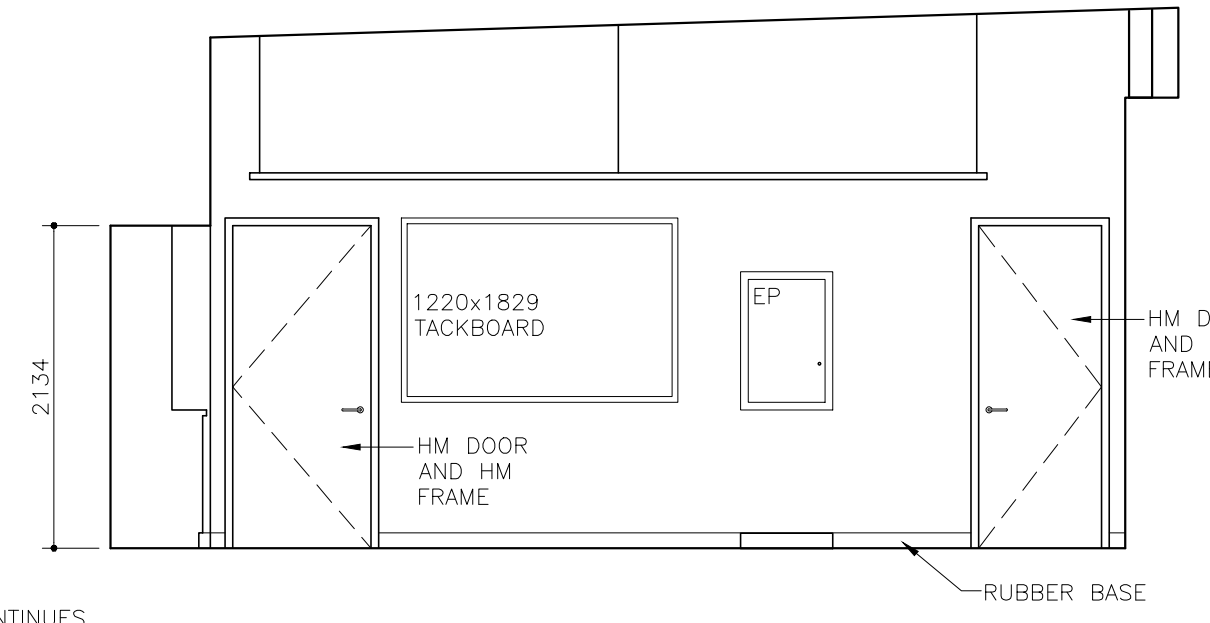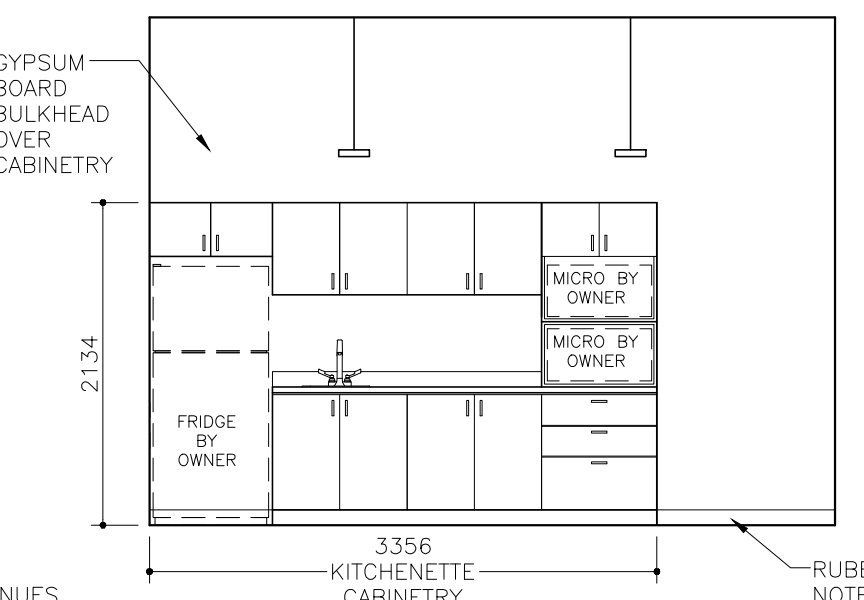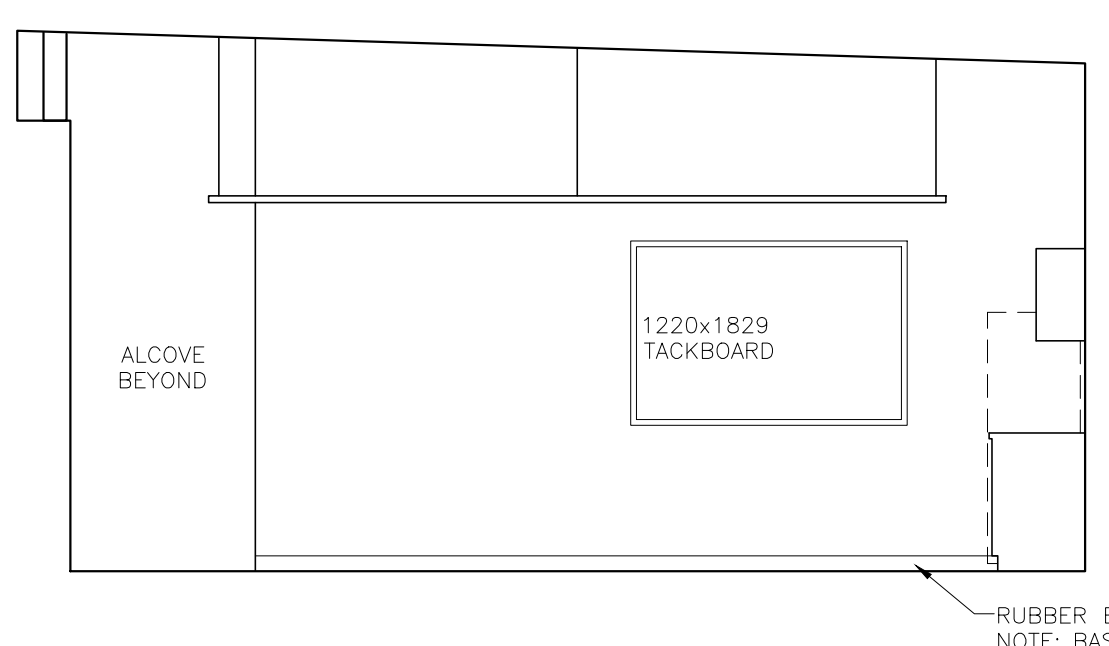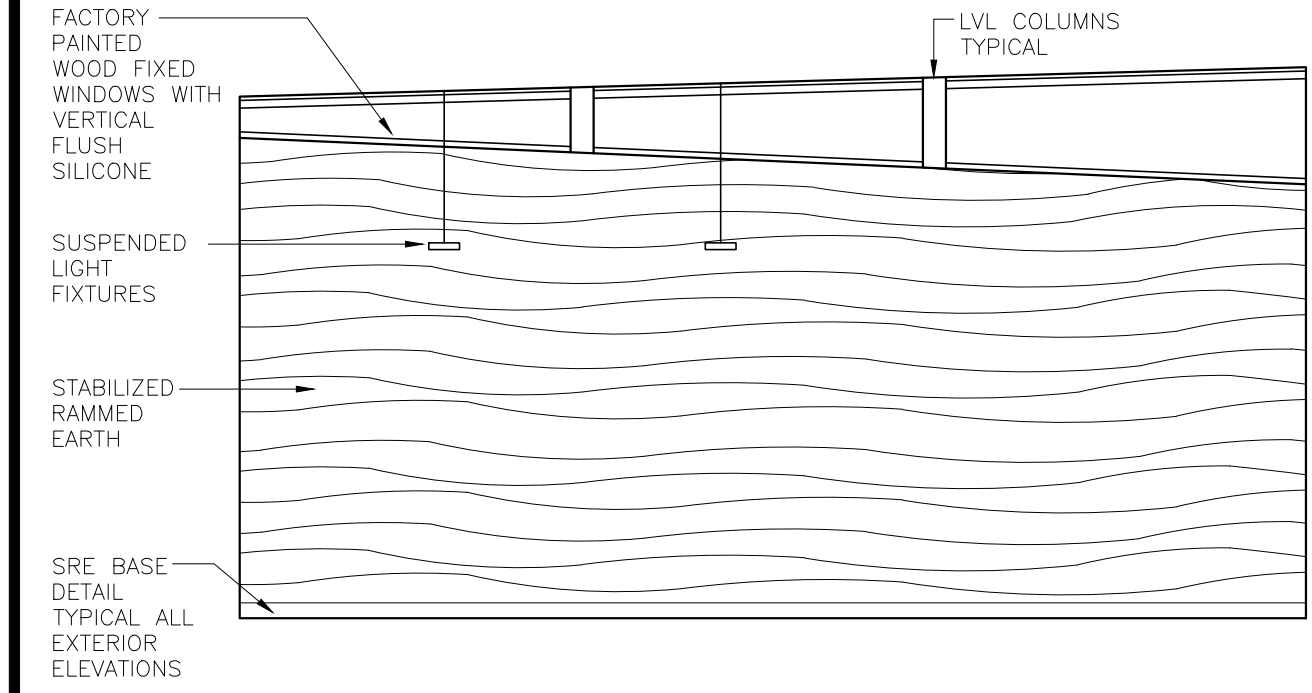





UNLESS NOTED OTHERWISE, ALL INTERIOR WALLS ARE GYPSUM BOARD WITH PAINT FINISH
UNLESS NOTED OTHERWISE, CEILINGS THROUGHOUT ARE PAINTED GYPSUM BOARD

Int. Elev. 25 Staff Room 108 Scale 1:50

Int. Elev. 26 Staff Room 108 Scale 1:50

Int. Elev. 27 Staff Room 108 Scale 1:50

Int. Elev. 28 Staff Room 108 Scale 1:50





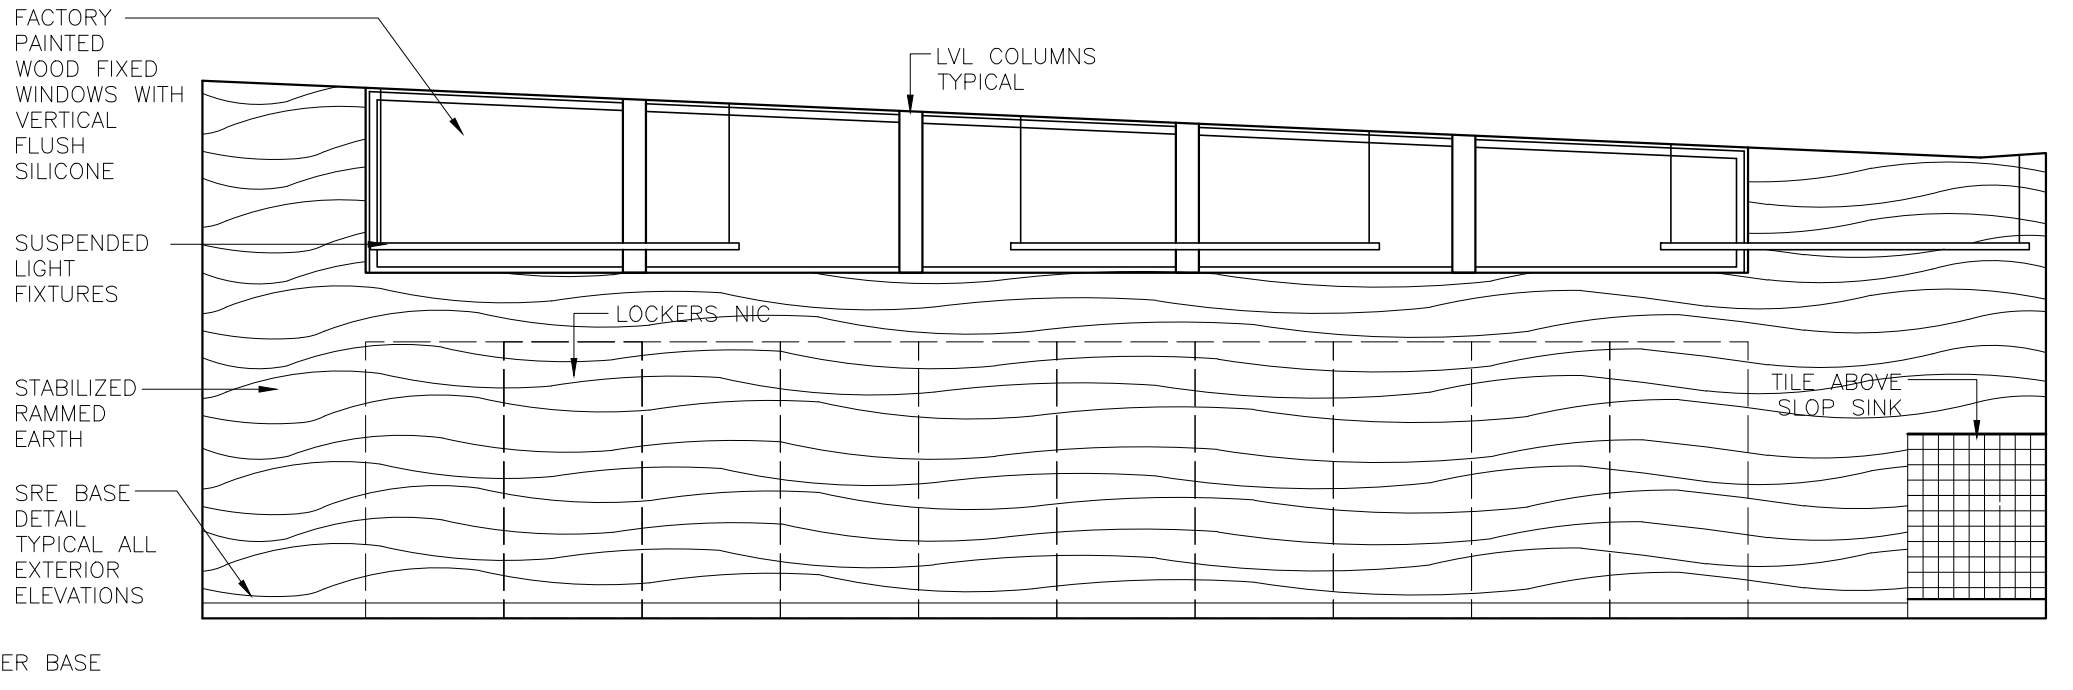
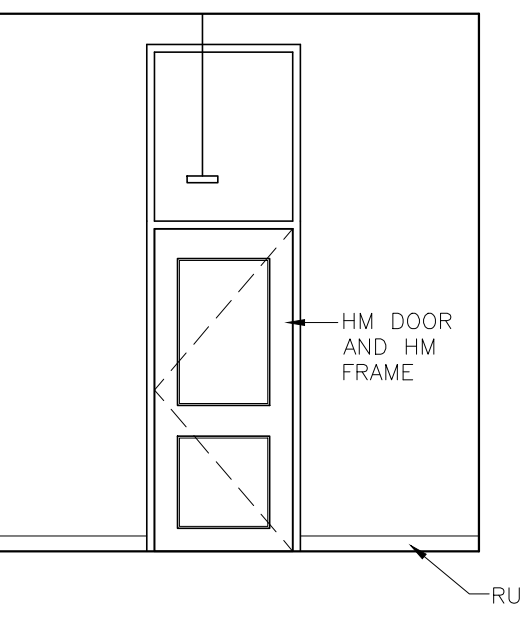
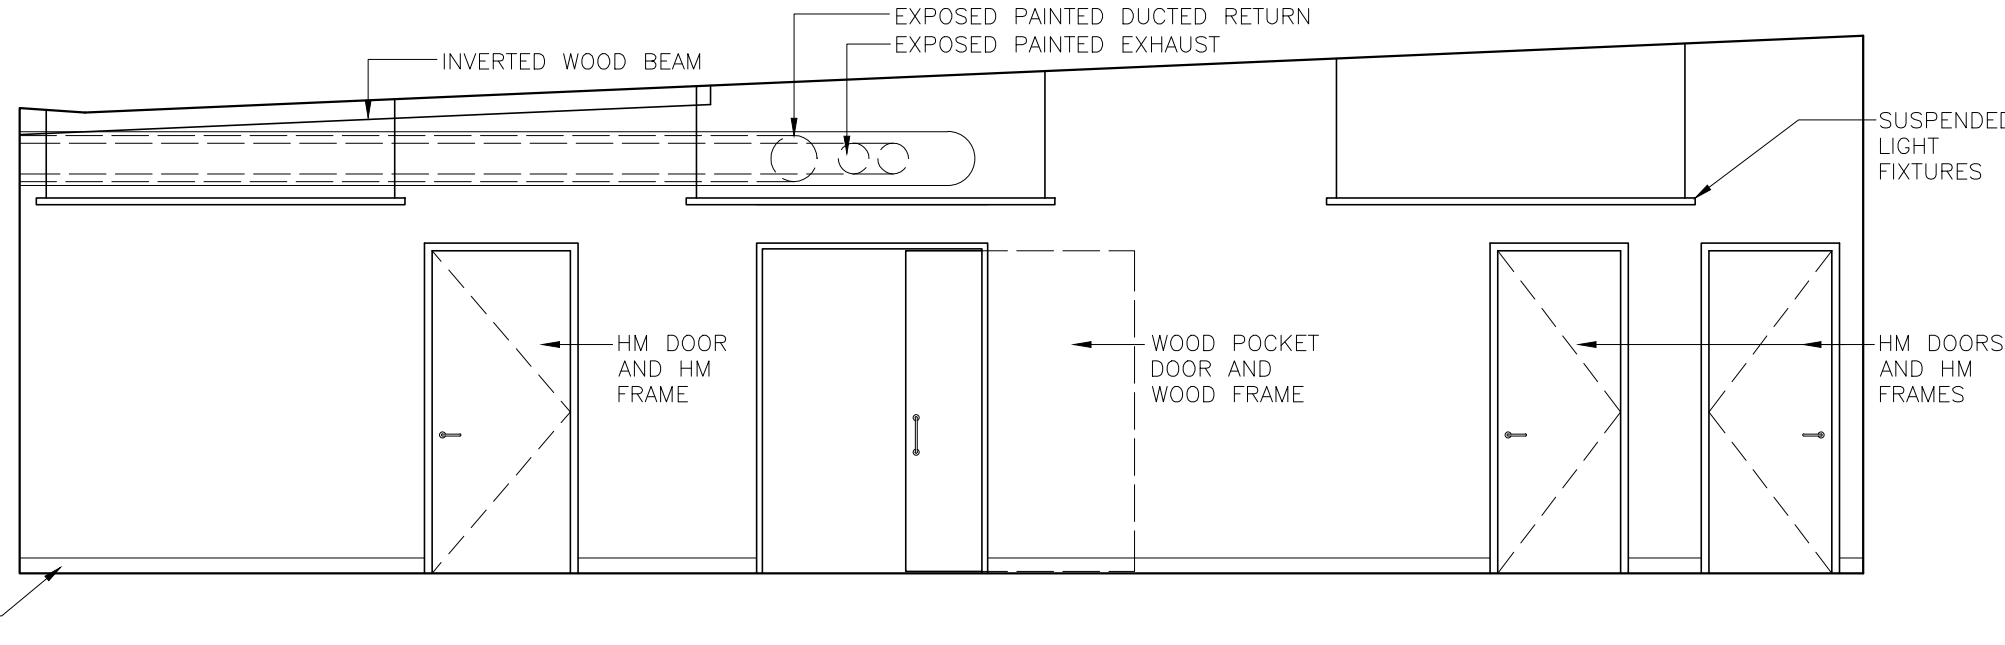
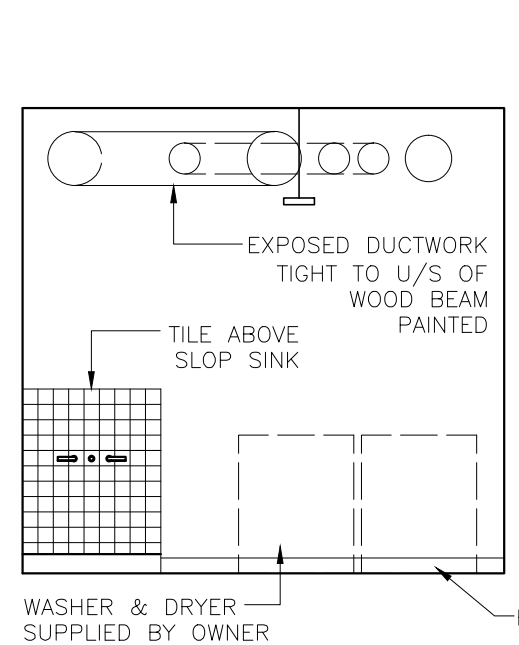


Int. Elev. 29 Locker Room 110 Scale 1:50

Int. Elev. 30 Locker Room 110 Scale 1:50

Int. Elev. 31 Locker Room 110 Scale 1:50

Int. Elev. 32 Locker Room 110 Scale 1:50

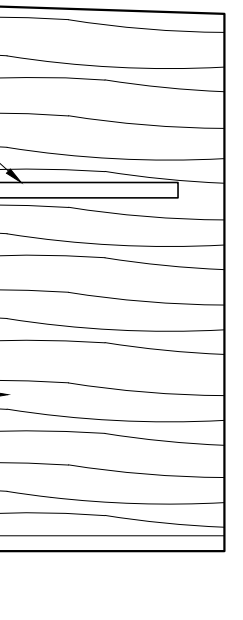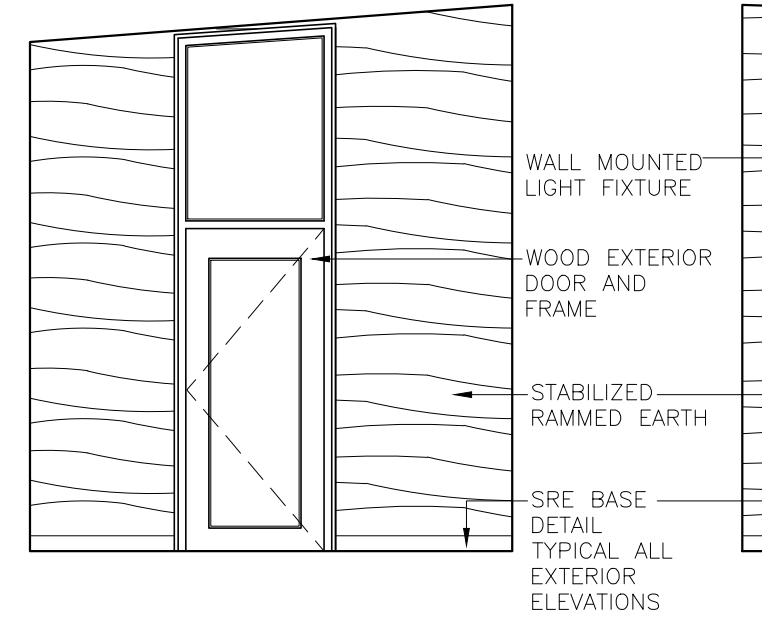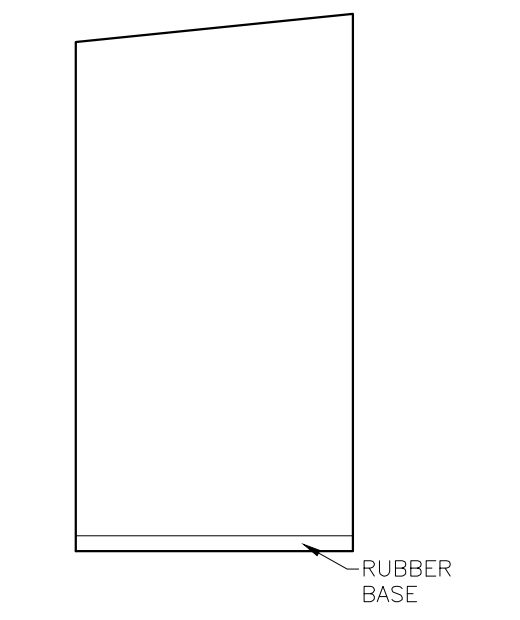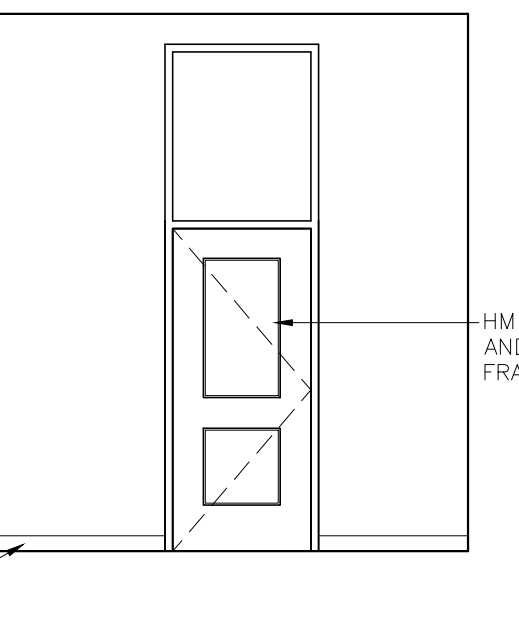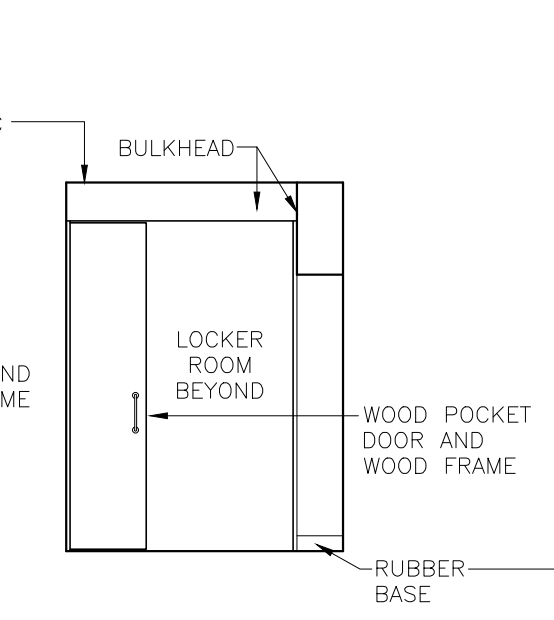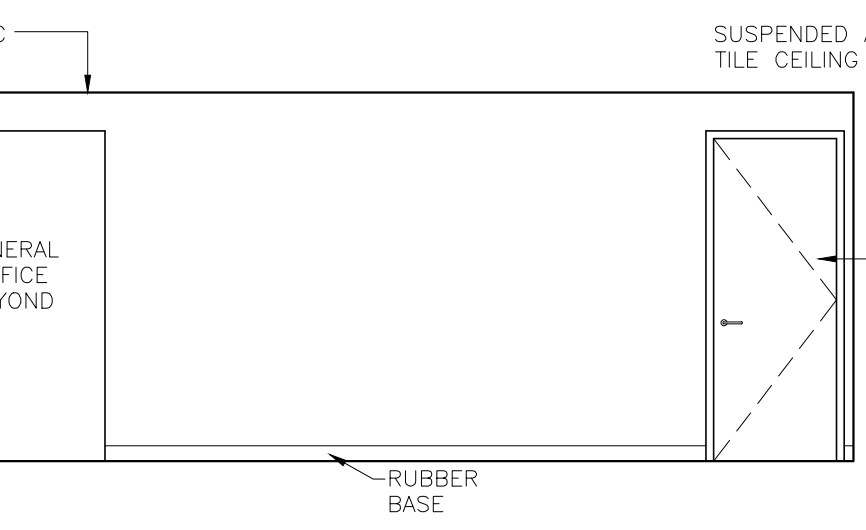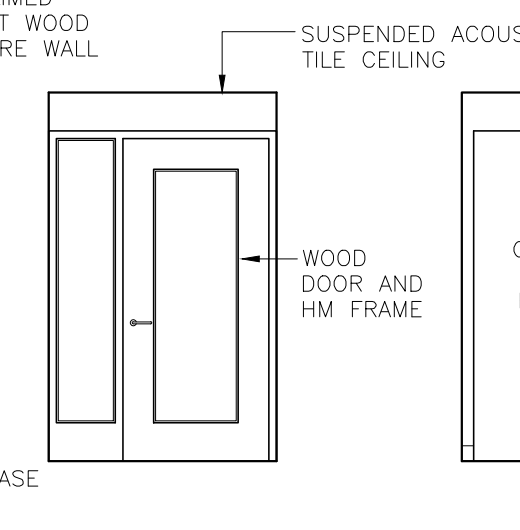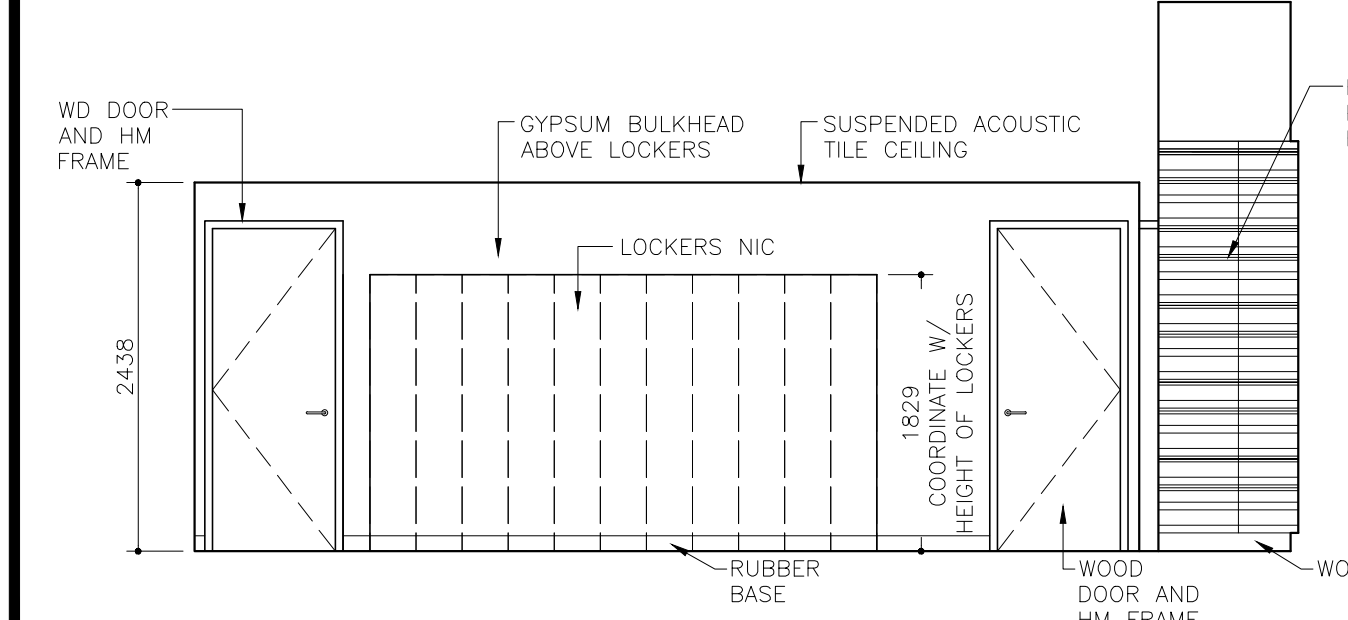

Int. Elev. 33 Corridor Scale 1:50

Int. Elev. 34 Corridor Scale 1:50

Int. Elev. 35 Corridor Scale 1:50

Int. Elev. 36 Corridor Scale 1:50

Int. Elev. 37 Vestibule 111 Scale 1:50

Int. Elev. 38 Vestibule 111 Scale 1:50

Int. Elev. 39 Vestibule 111 Scale 1:50

Int. Elev. 40 Vestibule 111 Scale 1:50

5		
4		
3	AS-BUILT	2018.07.23
2	Issued for Tender & Permit	2017.05.12
1	Issued for 90% Review	2017.04.10
NO.	REVISION	DATE

M
MARKLEVITZ ARCHITECTS
inc

516 HURON STREET, STRATFORD, ONTARIO N5A 5T7
TEL: 519 271 9230 FAX: 519 271 6560
www.marklevitz.com

THESE DRAWINGS ARE AN INSTRUMENT OF SERVICE AND ALL INFORMATION WITHIN IS THE SOLE PROPERTY AND COPYRIGHT OF MARKLEVITZ ARCHITECTS INC. REPRODUCTION OF THESE DOCUMENTS WITHOUT WRITTEN PERMISSION OF THE ARCHITECT AND CONSULTANTS IS STRICTLY PROHIBITED.

PROJECT: New Waste Management Administration Building
LOCATION: 384060 Salford Road Township of Oxford, Ontario
FOR: Oxford County
DRAWING: Interior Elevations






DRAWING NO. **A18**
PROJ. No: 3153-16
DATE: 2017.05.12

3153-16 Oxford County Waste Management Building Working Drawings.dwg

GENERAL NOTES:

1. THE GENERAL NOTES REFER TO ALL ARCHITECTURAL DRAWINGS.
2. DO NOT SCALE DRAWINGS.
3. SITE CHECK ALL DIMENSIONS PRIOR TO CONSTRUCTION.
4. NOTHING ON THESE DRAWINGS SUPERSEDES THE REGULATIONS OF THE GOVERNING CODES INCLUDING THE ONTARIO BUILDING CODE.
5. NOTIFY ARCHITECT OF ALL CONFLICTS AND DISCREPANCIES PRIOR TO CONSTRUCTION.
6. CONTRACTOR TO COORDINATE ARCHITECTURAL, STRUCTURAL, MECHANICAL, ELECTRICAL DRAWINGS BEFORE CONSTRUCTION AND NOTIFY ARCHITECT OF ANY DISCREPANCIES.
7. THESE DRAWINGS ARE NOT INTENDED TO SHOW CIVIL, STRUCTURAL, MECHANICAL OR ELECTRICAL INFORMATION.

UNLESS NOTED OTHERWISE, ALL INTERIOR WALLS ARE GYPSUM BOARD WITH PAINT FINISH
UNLESS NOTED OTHERWISE, CEILINGS THROUGHOUT ARE PAINTED GYPSUM BOARD

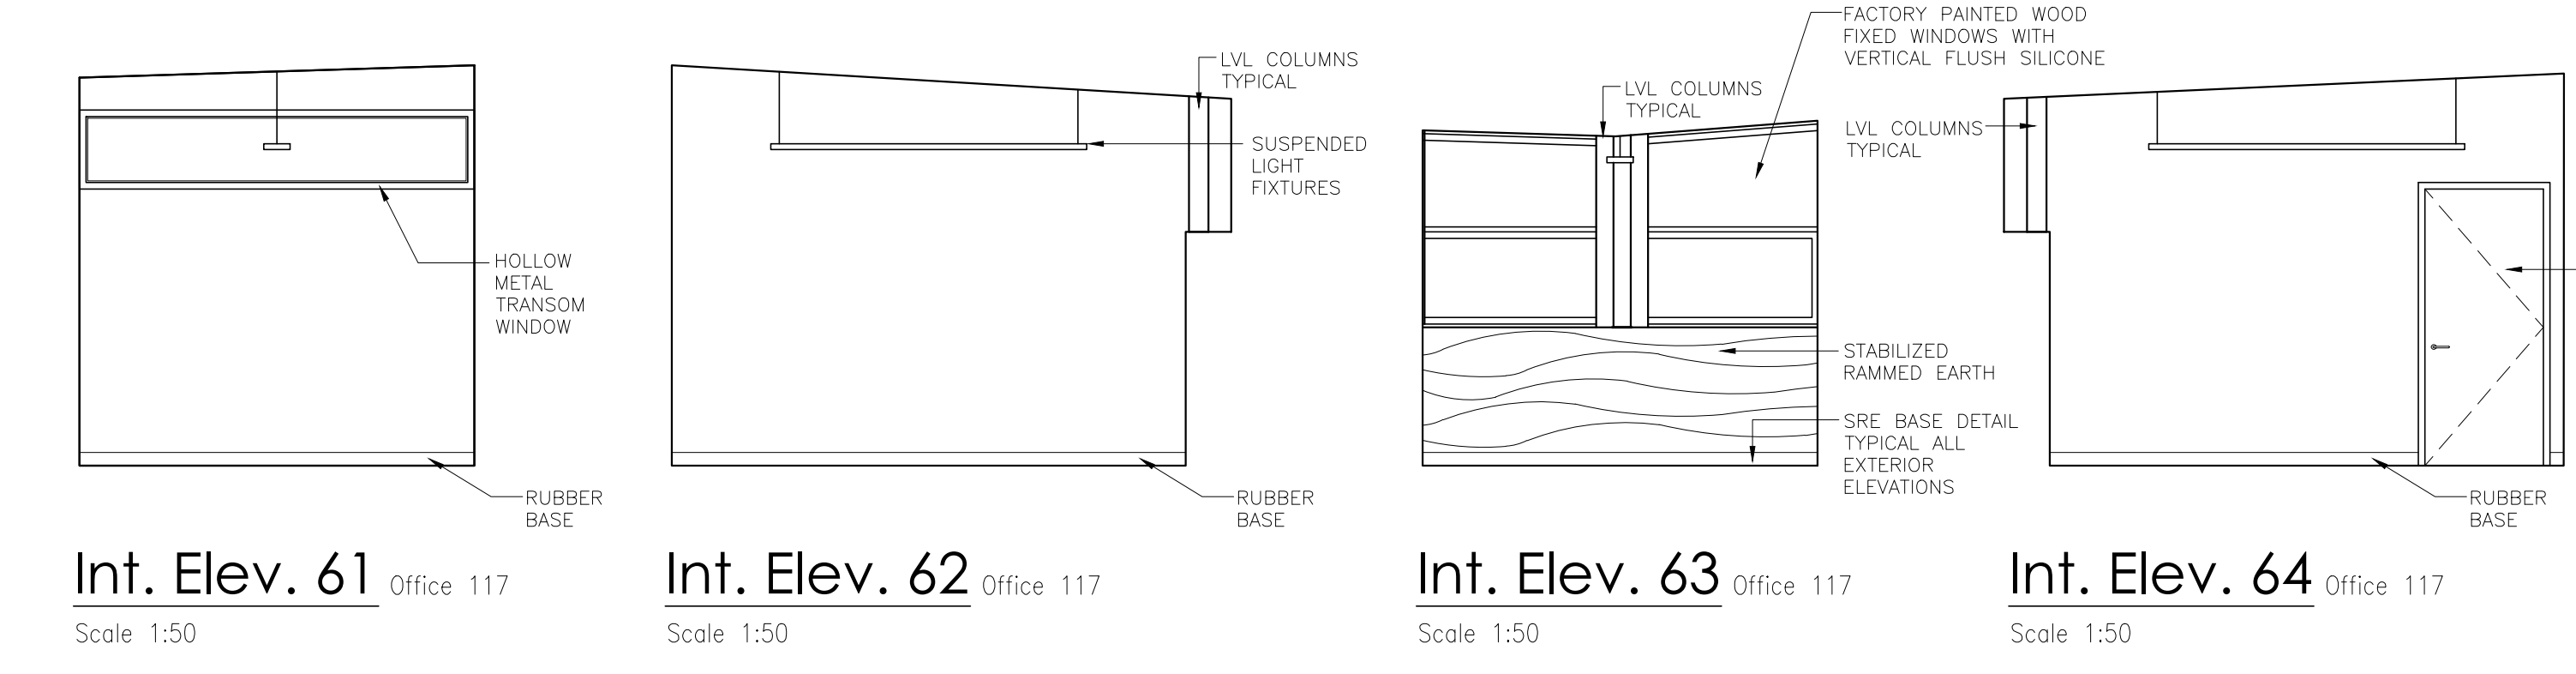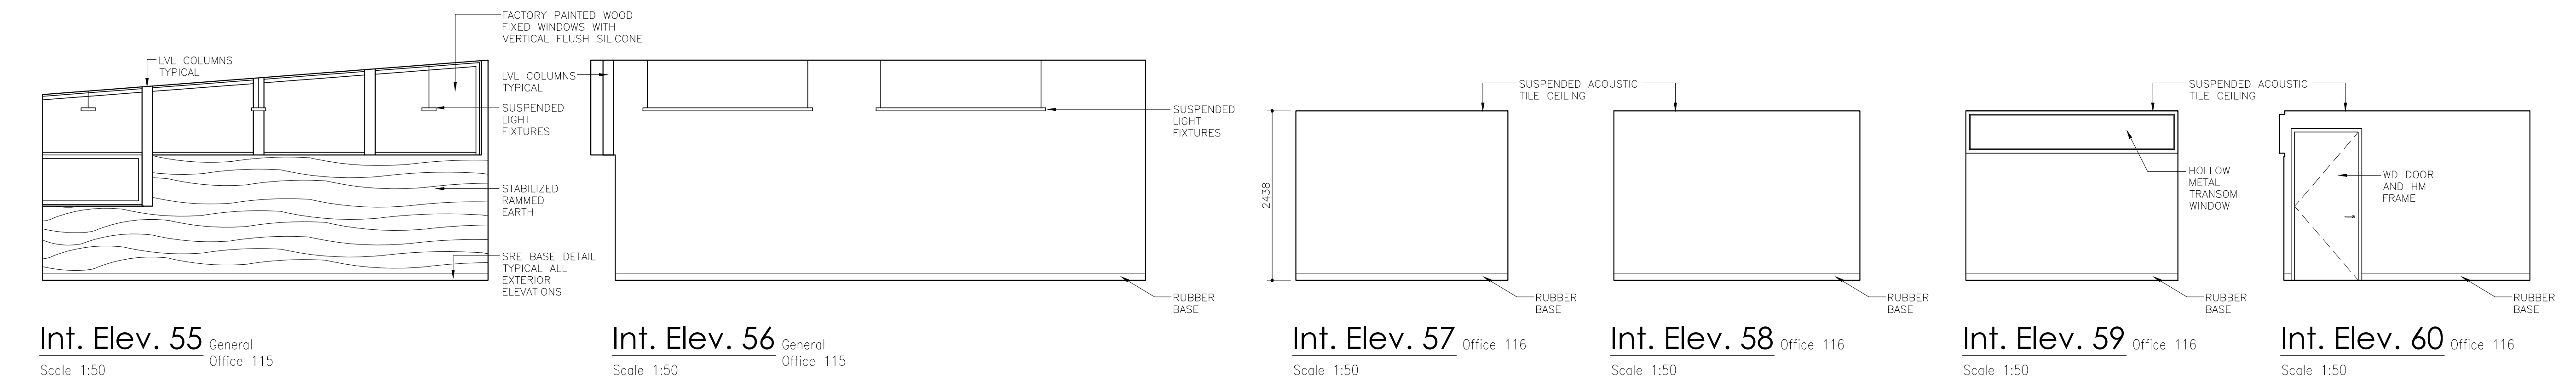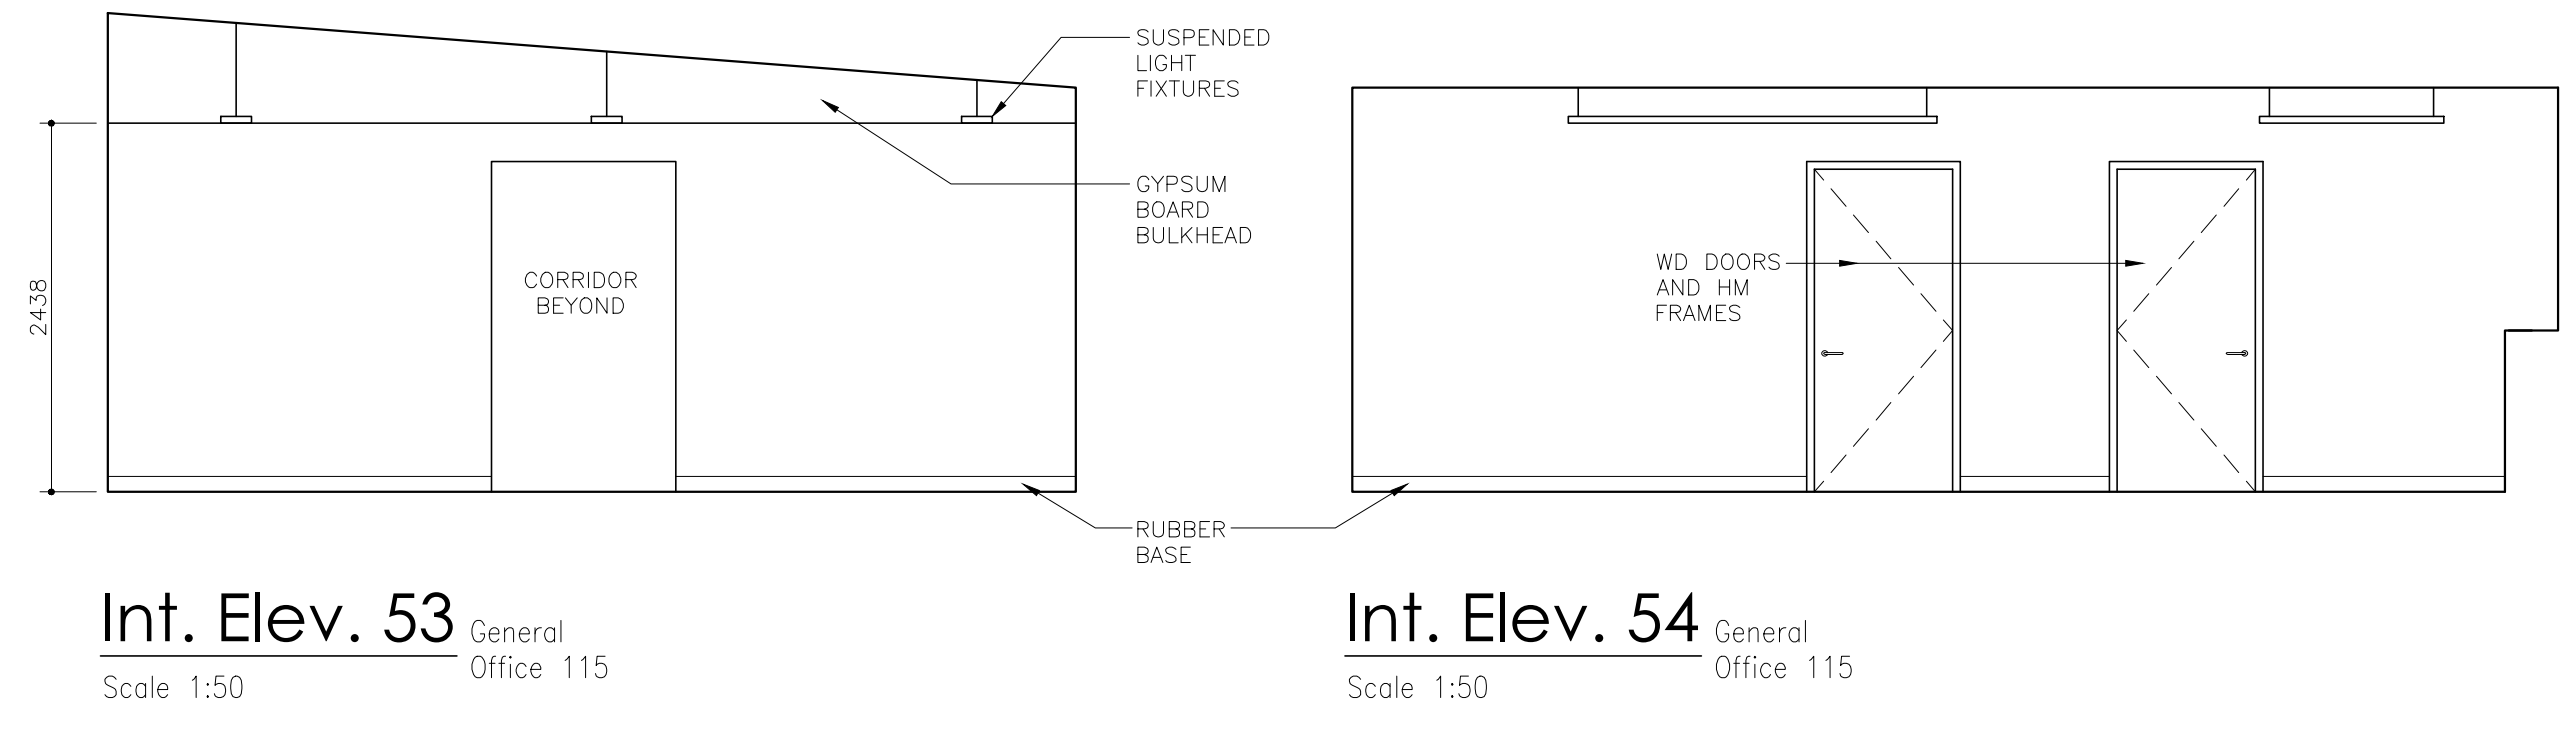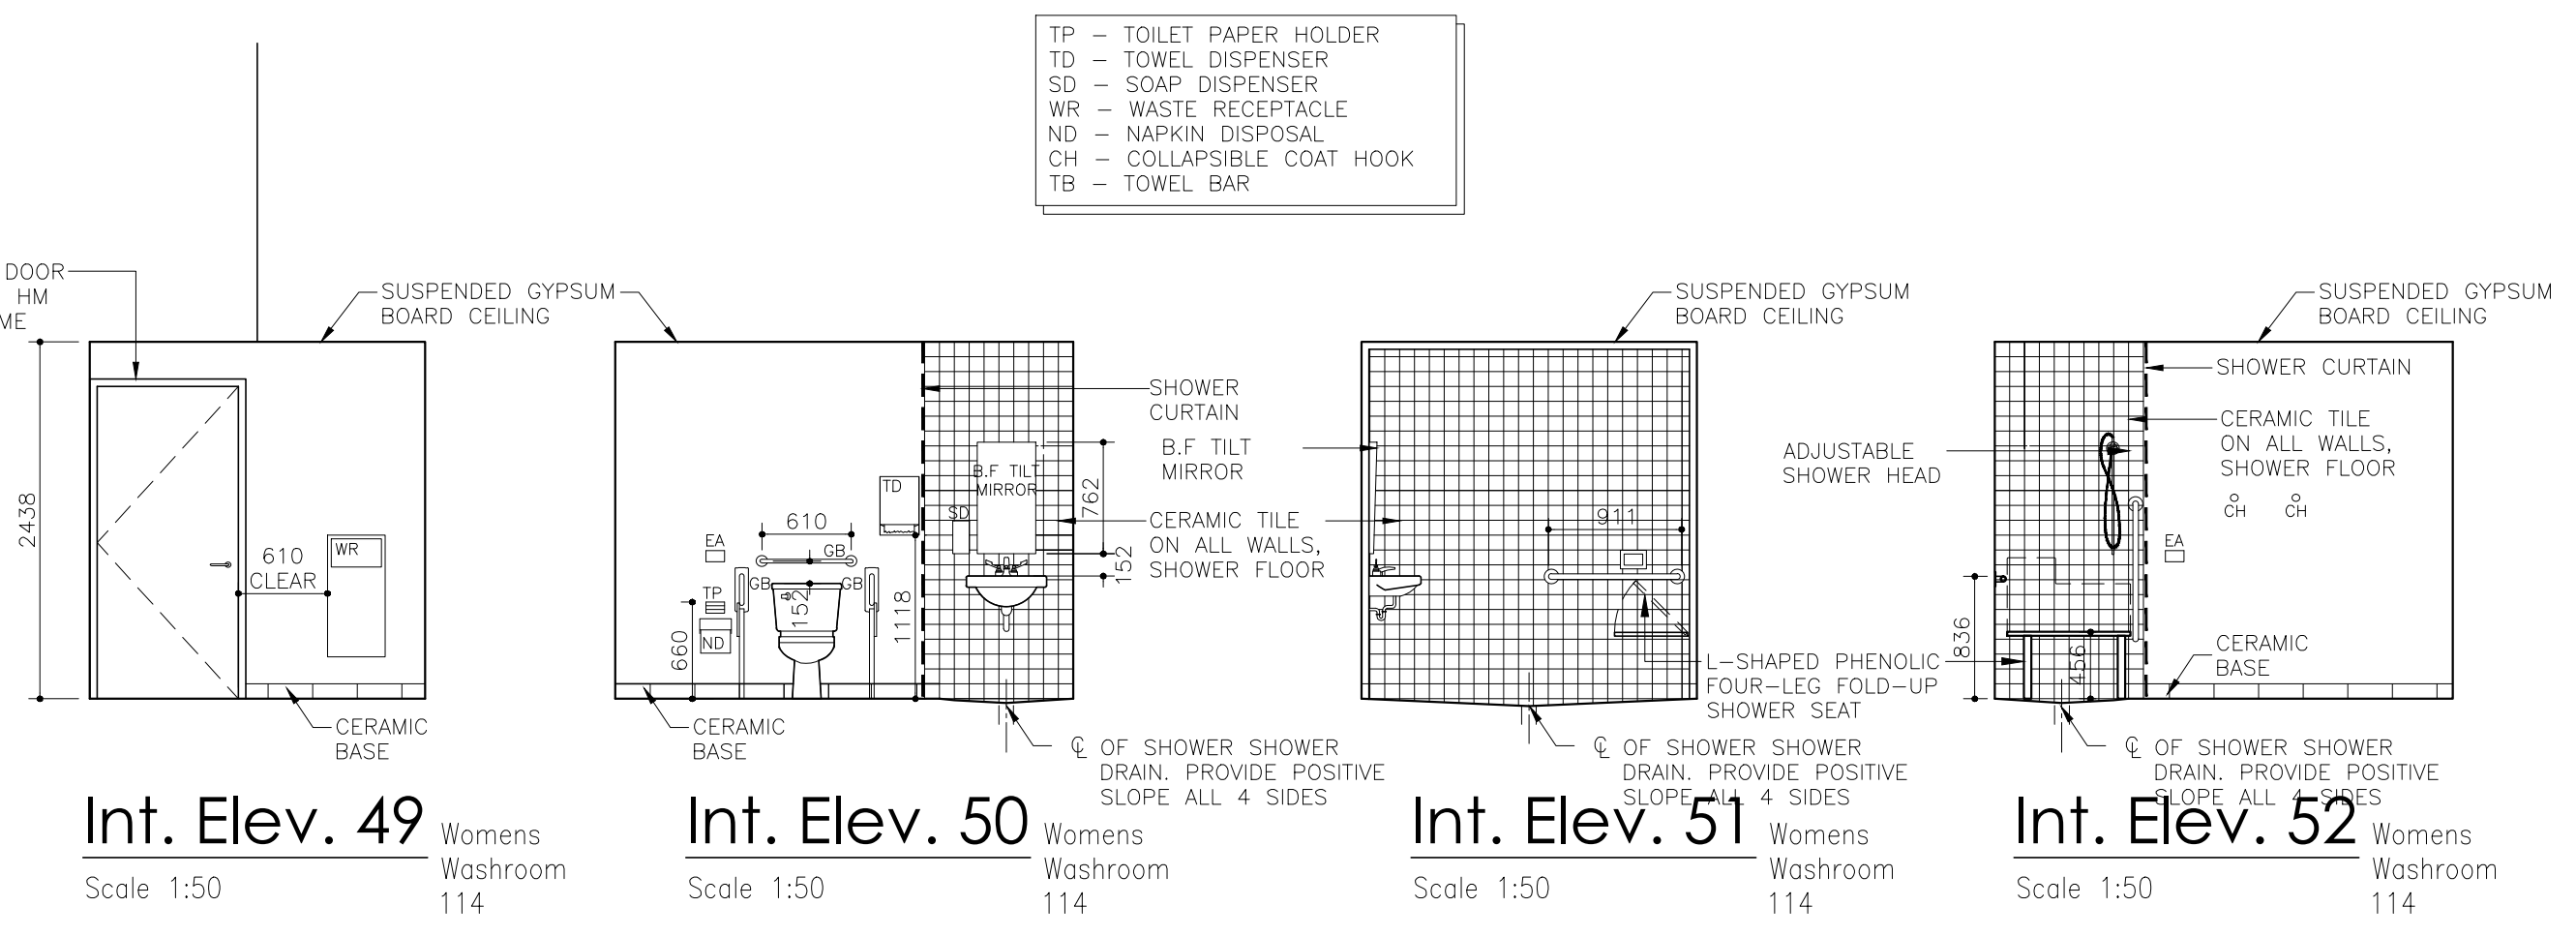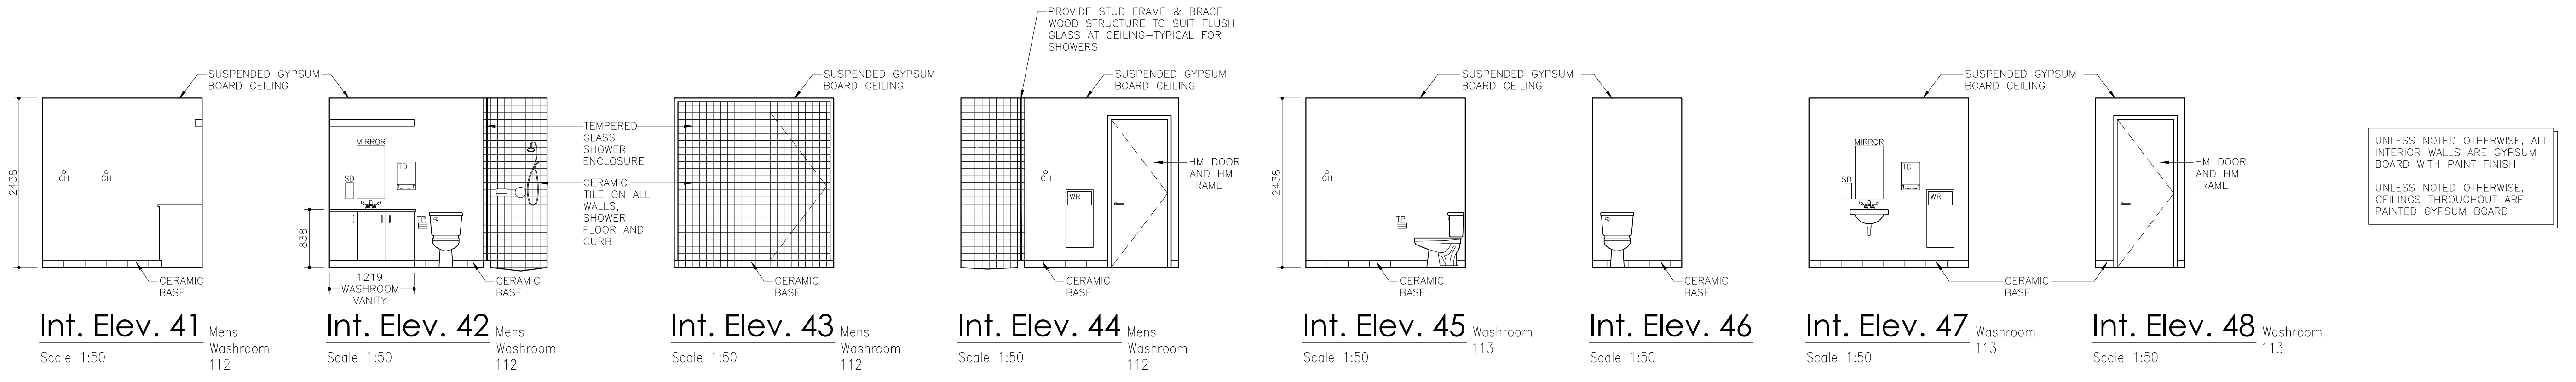

UNLESS NOTED OTHERWISE, ALL INTERIOR WALLS ARE GYPSUM BOARD WITH PAINT FINISH
UNLESS NOTED OTHERWISE, CEILINGS THROUGHOUT ARE PAINTED GYPSUM BOARD

5		
4		
3	AS-BUILT	2018.07.23
2	Issued for Tender & Permit	2017.05.12
1	Issued for 90% Review	2017.04.10
NO.	REVISION	DATE



516 HURON STREET, STRATFORD, ONTARIO N5A 5T7
TEL: 519 271 9230 FAX: 519 271 6560
www.marklevitz.com

THESE DRAWINGS ARE AN INSTRUMENT OF SERVICE AND ALL INFORMATION WITHIN IS THE SOLE PROPERTY AND COPYRIGHT OF MARKLEVITZ ARCHITECTS INC. REPRODUCTION OF THESE DOCUMENTS WITHOUT WRITTEN PERMISSION OF THE ARCHITECT AND CONSULTANTS IS STRICTLY PROHIBITED.

PROJECT
New Waste Management Administration Building

LOCATION
384060 Salford Road
Township of Oxford, Ontario

FOR
Oxford County

DRAWING
Interior Elevations

DRAWING NO.	A19
PROJ. No:	3153-16
DATE:	2017.05.12